

PREPARED FOR  
BENCHMARK BUILDERS



# PLAT OF SURVEY

- OF -


KROTT SURVEYING INC.

N3705 WILLOW BEND LANE  
LAKE GENEVA WI. 53147  
PHONE # (262)248-3697  
FAX # (262)249-0639

UNIT 4 OF THE FIRST ADDENDUM TO THE COTTAGES OF LAKE GENEVA HILLS, A  
CONDOMINIUM LOCATED IN THE SW 1/4 OF THE SE 1/4 OF SECTION 26, TOWN 2 NORTH, RANGE  
17 EAST, CITY OF LAKE GENEVA, COUNTY OF WALWORTH AND STATE OF WISCONSIN.

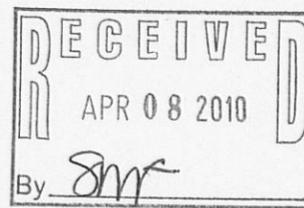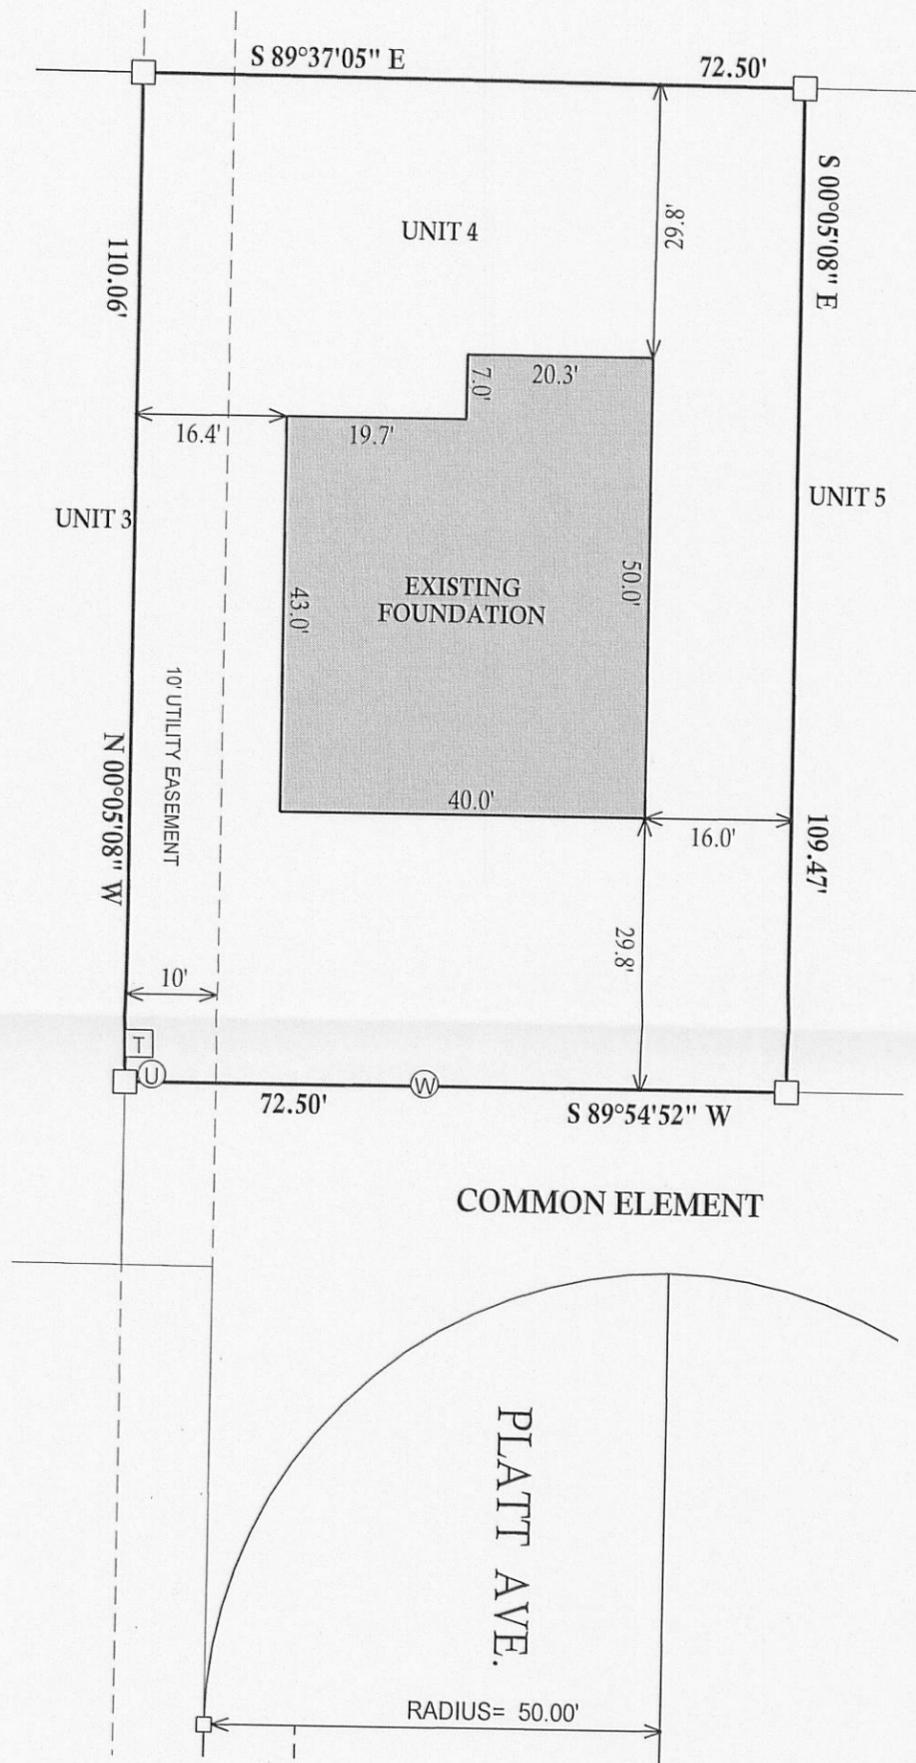

NOTE : BEARINGS REFRENCED TO THE RECORD PLAT

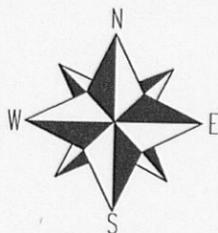

SCALE 1" = 20'



### LEGEND

- FOUND IRON BAR
- ⊙ UTILITY PEDISTALS
- ⊠ TRANSFORMER


(XX) RECORDED AS

TAX ID # ZCOT00004

JOB # 08-025

I have surveyed the above-described property and the above map is a true representation thereof and shows the size and location of the property, its exterior boundaries, the location and dimensions of all structures thereon, fences apparent easements and roadways and visible encroachments, if any.

This survey is made for the exclusive use of the present owners of the property, and also those who purchase, mortgage, or insure the title thereto within one (1) year from date hereof; and as to them I warrant the accuracy of said survey map.

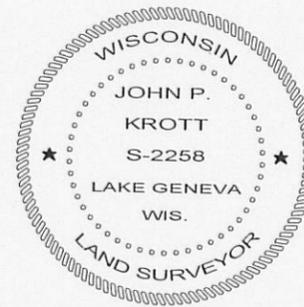

DATE THIS 24th, DAY OF FEBRUARY, 2010  
DATE OF LAST REVISION 03 / 23 / 2010

*John P. Krott*

JOHN KROTT S - 2258  
Wisconsin Registered Land Surveyor  
( original if signed in red )

007-2727 021-9191