


AMBIT LAND SURVEYING
P. O. Box 42
Bassett, WI. 53101-0042

PLAT OF SURVEY OF


PHONE 262-537-4874
FAX 262-537-4221

Lot 2 of SYVER-STAD LAKE SHORE ESTATES, located in Section 1, Township 1 North, Range 17 East of the 4th Principal Meridian, City of Lake Geneva, Walworth County, Wisconsin.

PARCEL IDENTIFICATION NO.: ZSY 00002

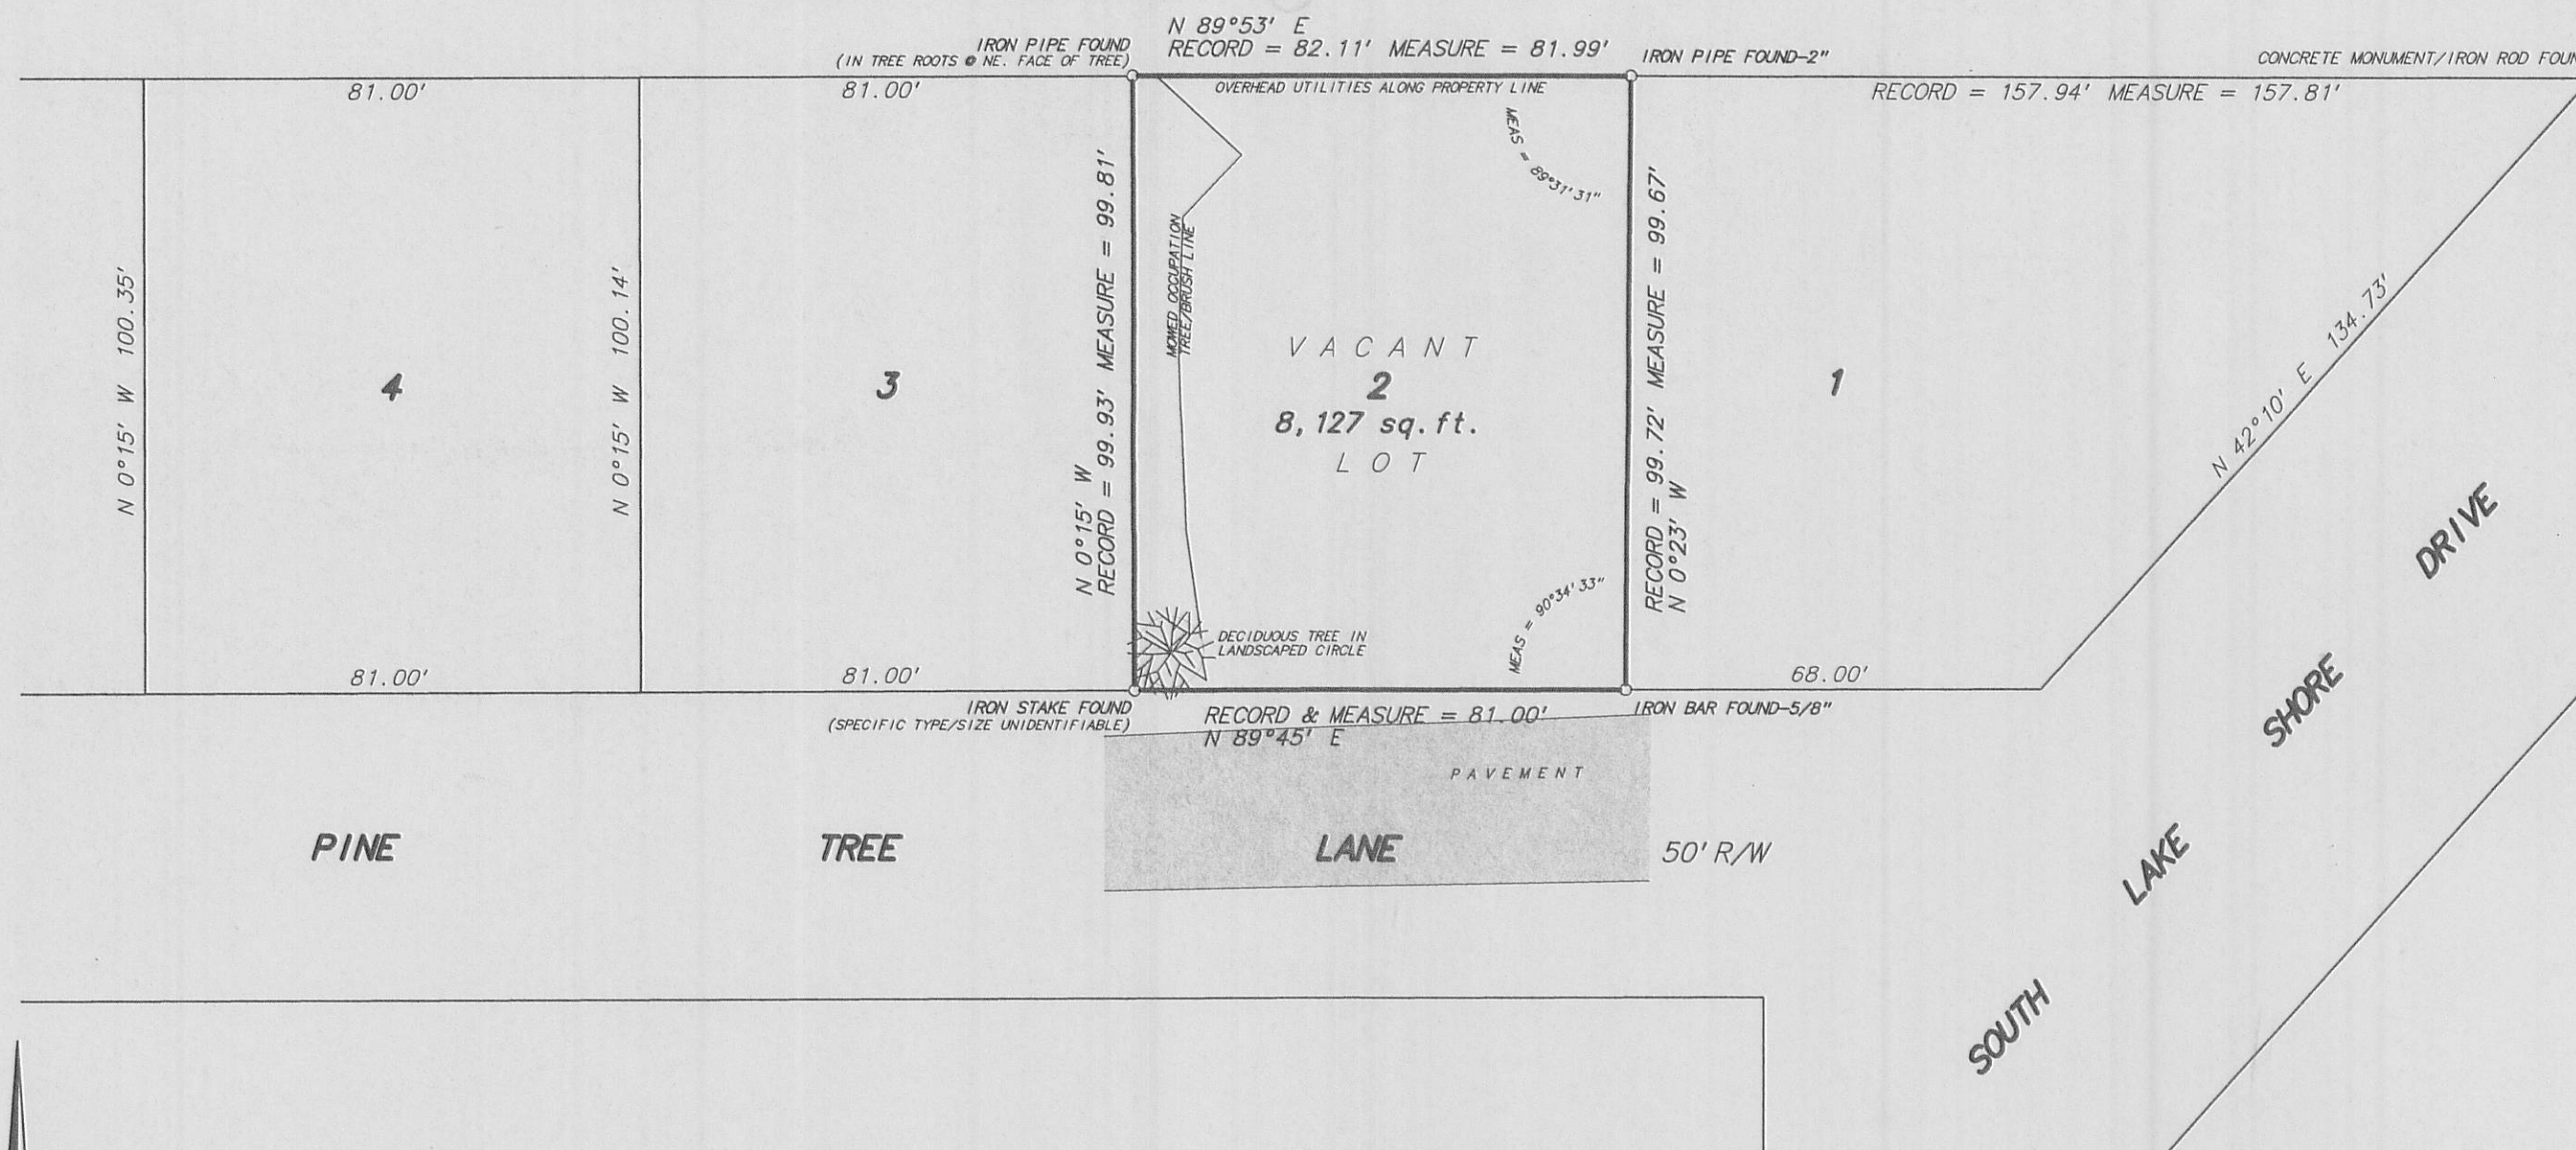

SCALE: 1 inch = 30 feet
ORDERED BY: D. Pierce / Pierce Builders
JOB NO. 08037

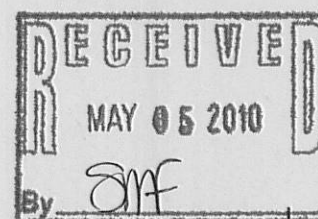

Rec'd Unsigned

Fieldwork completed on and date of certification: April 11, 2008

I hereby certify that I have surveyed the above described property and the above plat is a true representation thereof and shows the size and location of the property, its exterior boundaries, the location and dimensions of all visible structures thereon, boundary fences, apparent easements and roadways and visible encroachments, if any.

This survey is made for the exclusive use of the present owners of the property, and also those who purchase, mortgage or guarantee the title thereto within ONE YEAR from the date hereof.

Dated at Bassett, Wisconsin this _____ day of _____ 2008.

Mark A. Bolender
Wisconsin Registered Land Surveyor S - 1784

ZSY-2

007-2741