


THE WEST 20 FEET OF THE EAST 40 FEET OF LOT 2 IN BLOCK 30 IN THE ORIGINAL PLAT OF THE VILLAGE (NOW CITY) OF LAKE GENEVA, BEING A PART OF SECTION 36, IN TOWNSHIP 2 NORTH, RANGE 17 EAST, IN THE CITY OF LAKE GENEVA, WALWORTH COUNTY, WISCONSIN.


SURVEY LOCATION: 720 WEST MAIN STREET, LAKE GENEVA

RECEIVED
AUG 26 2010
By *SM*

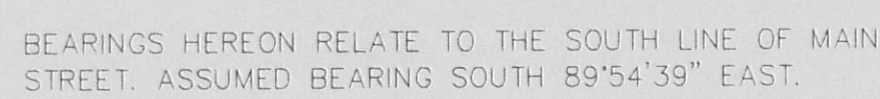

"I hereby certify that I have surveyed the above described property and that the above map is a correct representation thereof and shows the size and location of the property, its exterior boundaries, the location of all visible structures and dimensions of all principal buildings thereon, boundary fences, apparent easements, roadways and encroachments, if any."

"This survey is made for the use of the present owners of the property, and those who purchase, mortgage, or guarantee the title thereto within one year from date hereof."

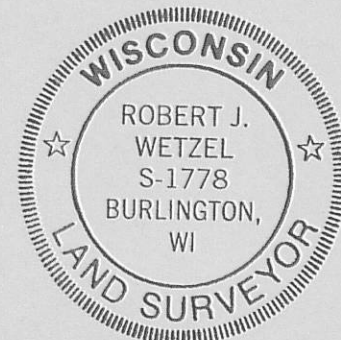

412 N. PINE STREET
BURLINGTON, WI 53105
(262)-767-0225

Robert J. Wetzel
ROBERT J. WETZEL S-1778

DRAWN BY:	bw	DATE:	REVISED NOVEMBER 5, 2008 REVISED NOVEMBER 5, 2008 OCTOBER 14, 2009
CHECKED BY:	rw/al	DRAWING NO.:	8109-d2
OR. NO.:	8109	SHEET	1 OF 1

ZOP - 3/2

007-2759