


PREPARED FOR:
DIANE KRAUSE
SHOREWEST REALTY
LAKE GENEVA, WI.

PLAT OF SURVEY

- OF -

LOT 27 BARBARA JEAN ESTATES, A SUBDIVISION LOCATED IN THE NORTHEAST 1/4
OF SECTION 1, TOWN 1 NORTH, RANGE 17 EAST, CITY OF LAKE GENEVA, WALWORTH
COUNTY, WISCONSIN.

PATHFINDER SURVEYING INC.
(formerly)
J.K. SURVEYING INC.
P.O BOX 322
LAKE GENEVA, WI. 53147
WWW.PATHFINDERSURVEYING.NET
262-248-8303

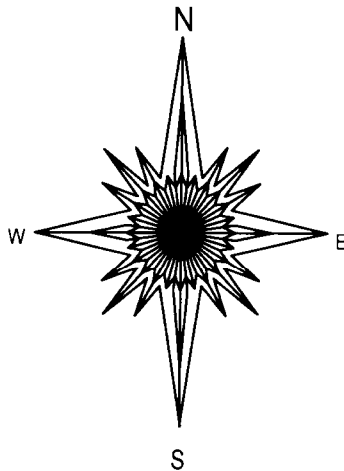

20 0 20 40

BASIS OF BEARING OF THIS PLAT: THE EAST LINE OF
TIMPOTHY DR. WAS ASSUMED TO BEAR N0°43'57"E
AS SHOWN ON THE RECORD PLAT.


- () = recorded as
□ = found iron bar
○ = found iron pipe
● = set iron pipe
■ = set iron bar

SCALE 1" = 20'

JOB # 10-162

TAX ID # ZJ 00027


TIMOTHY DR.
(PLATTED AS 66' WIDE)

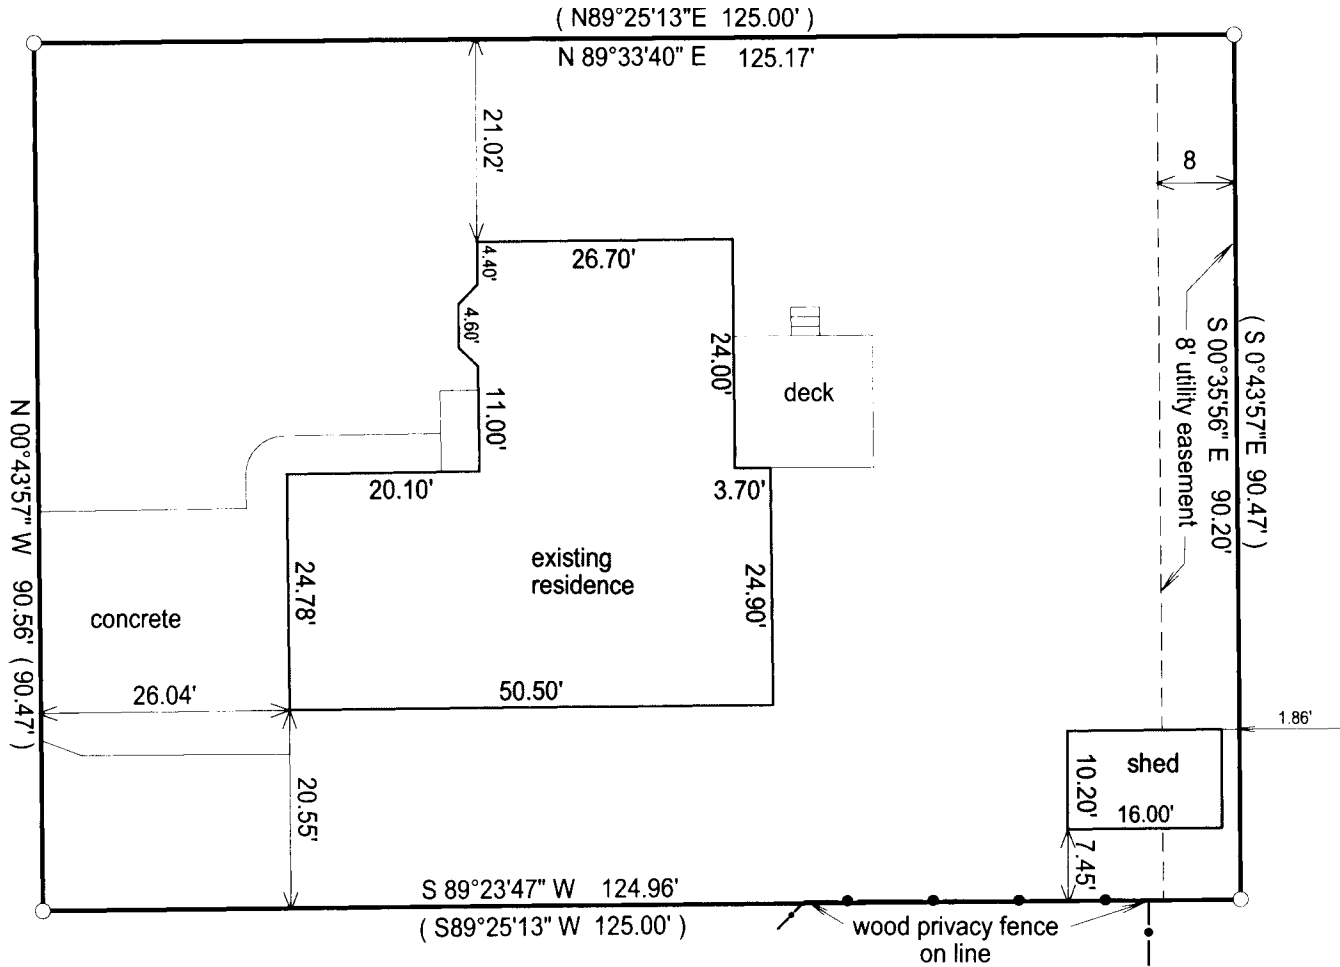

"I hereby certify that I have surveyed the above described property and that the above
map is a true representation of its exterior boundary and shows the size and location of
all visible structures, apparent easements and encroachments if any."

This survey is made for the present owners of the property, and those who
purchase, mortgage, or guarantee the title thereto, within one year from
the date hereof.

DATED THIS 6TH DAY OF NOVEMBER, 2010.

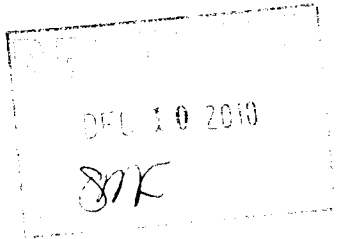

JEFFREY L. KIMPS / S - 2436
Wisconsin Registered Land Surveyor
(original if signed in red)

007-2794