


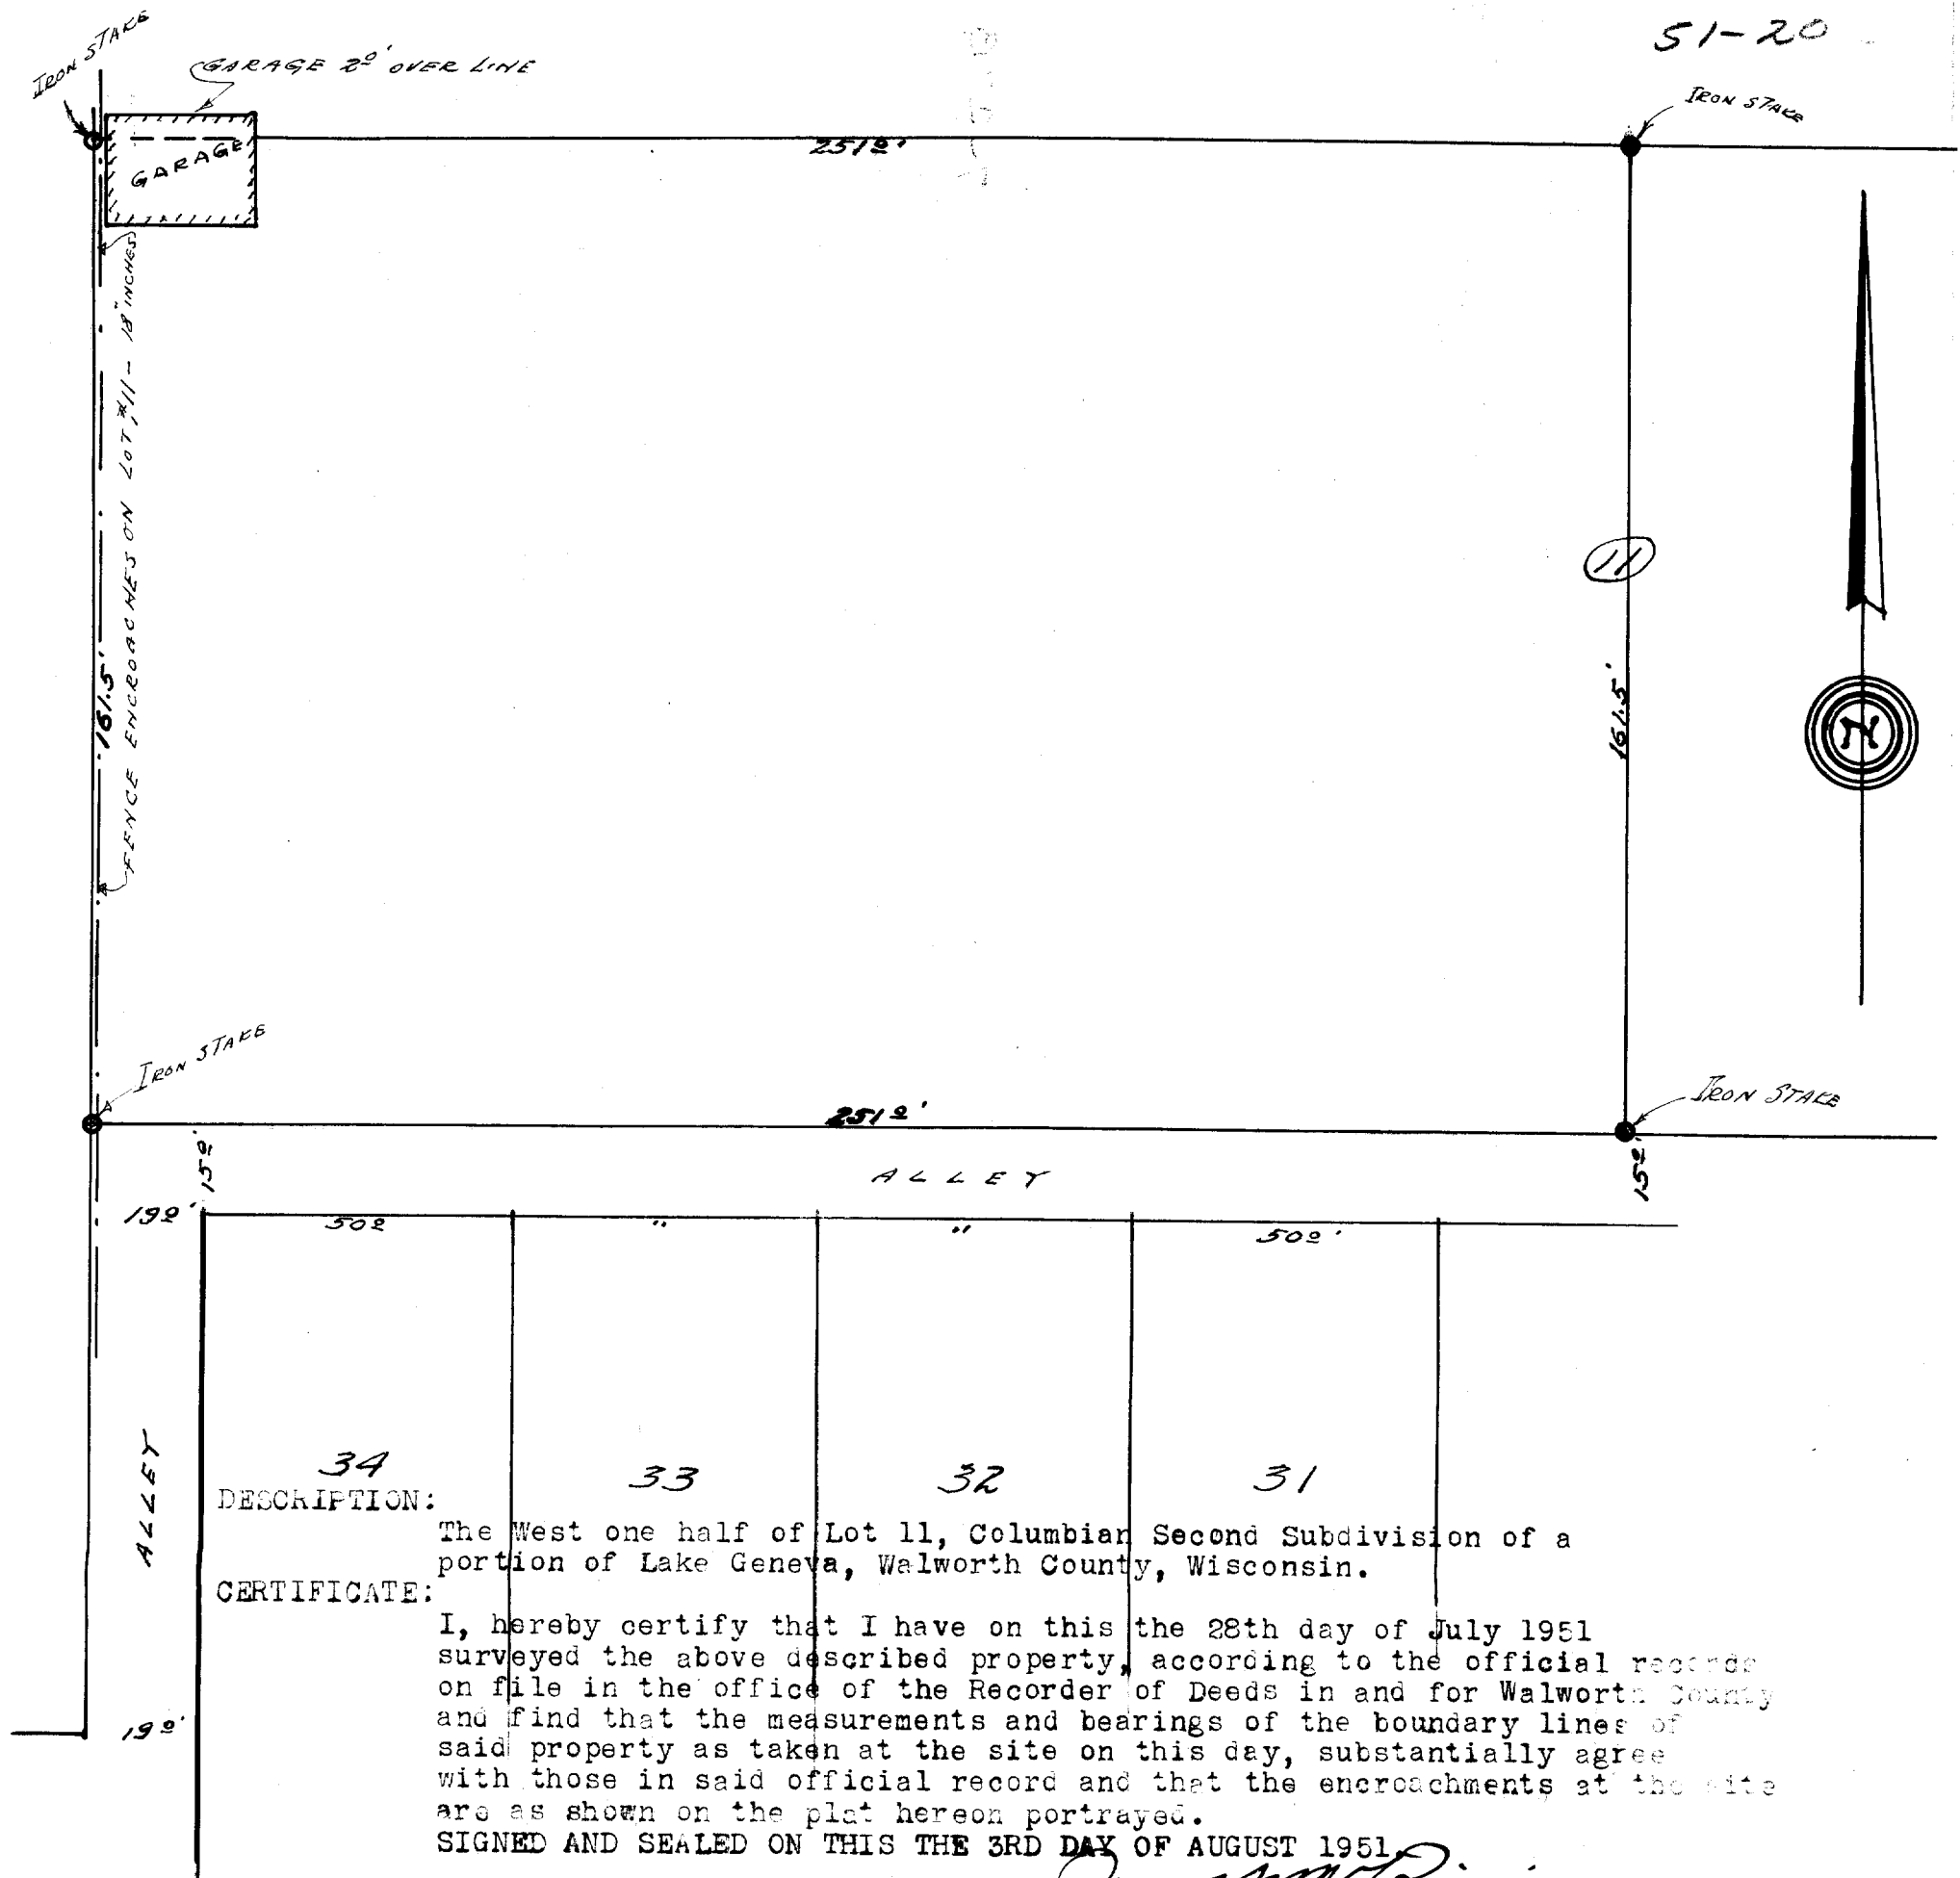

Joseph M. Biagi, Professional Engineer
Elkhorn Wisconsin.