

PREPARED FOR
JOHN LAW
REMAX GENEVA REALTY
101 BROAD ST.
LAKE GENEVA WI 53147




PLAT OF SURVEY

-OF-

UNIT 10 IN VICTORIAN SQUARE CONDOMINIUM, LOCATED IN
SECTION 1, TOWN 1 NORTH, RANGE 17 EAST, CITY OF LAKE GENEVA
WALWORTH COUNTY, WISCONSIN.

KROTT SURVEYING INC.

N3705 WILLOW BEND LANE
LAKE GENEVA WI. 53147
PHONE # (262)248-3697
FAX # (262)249-0639

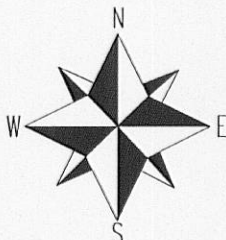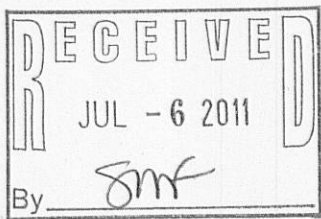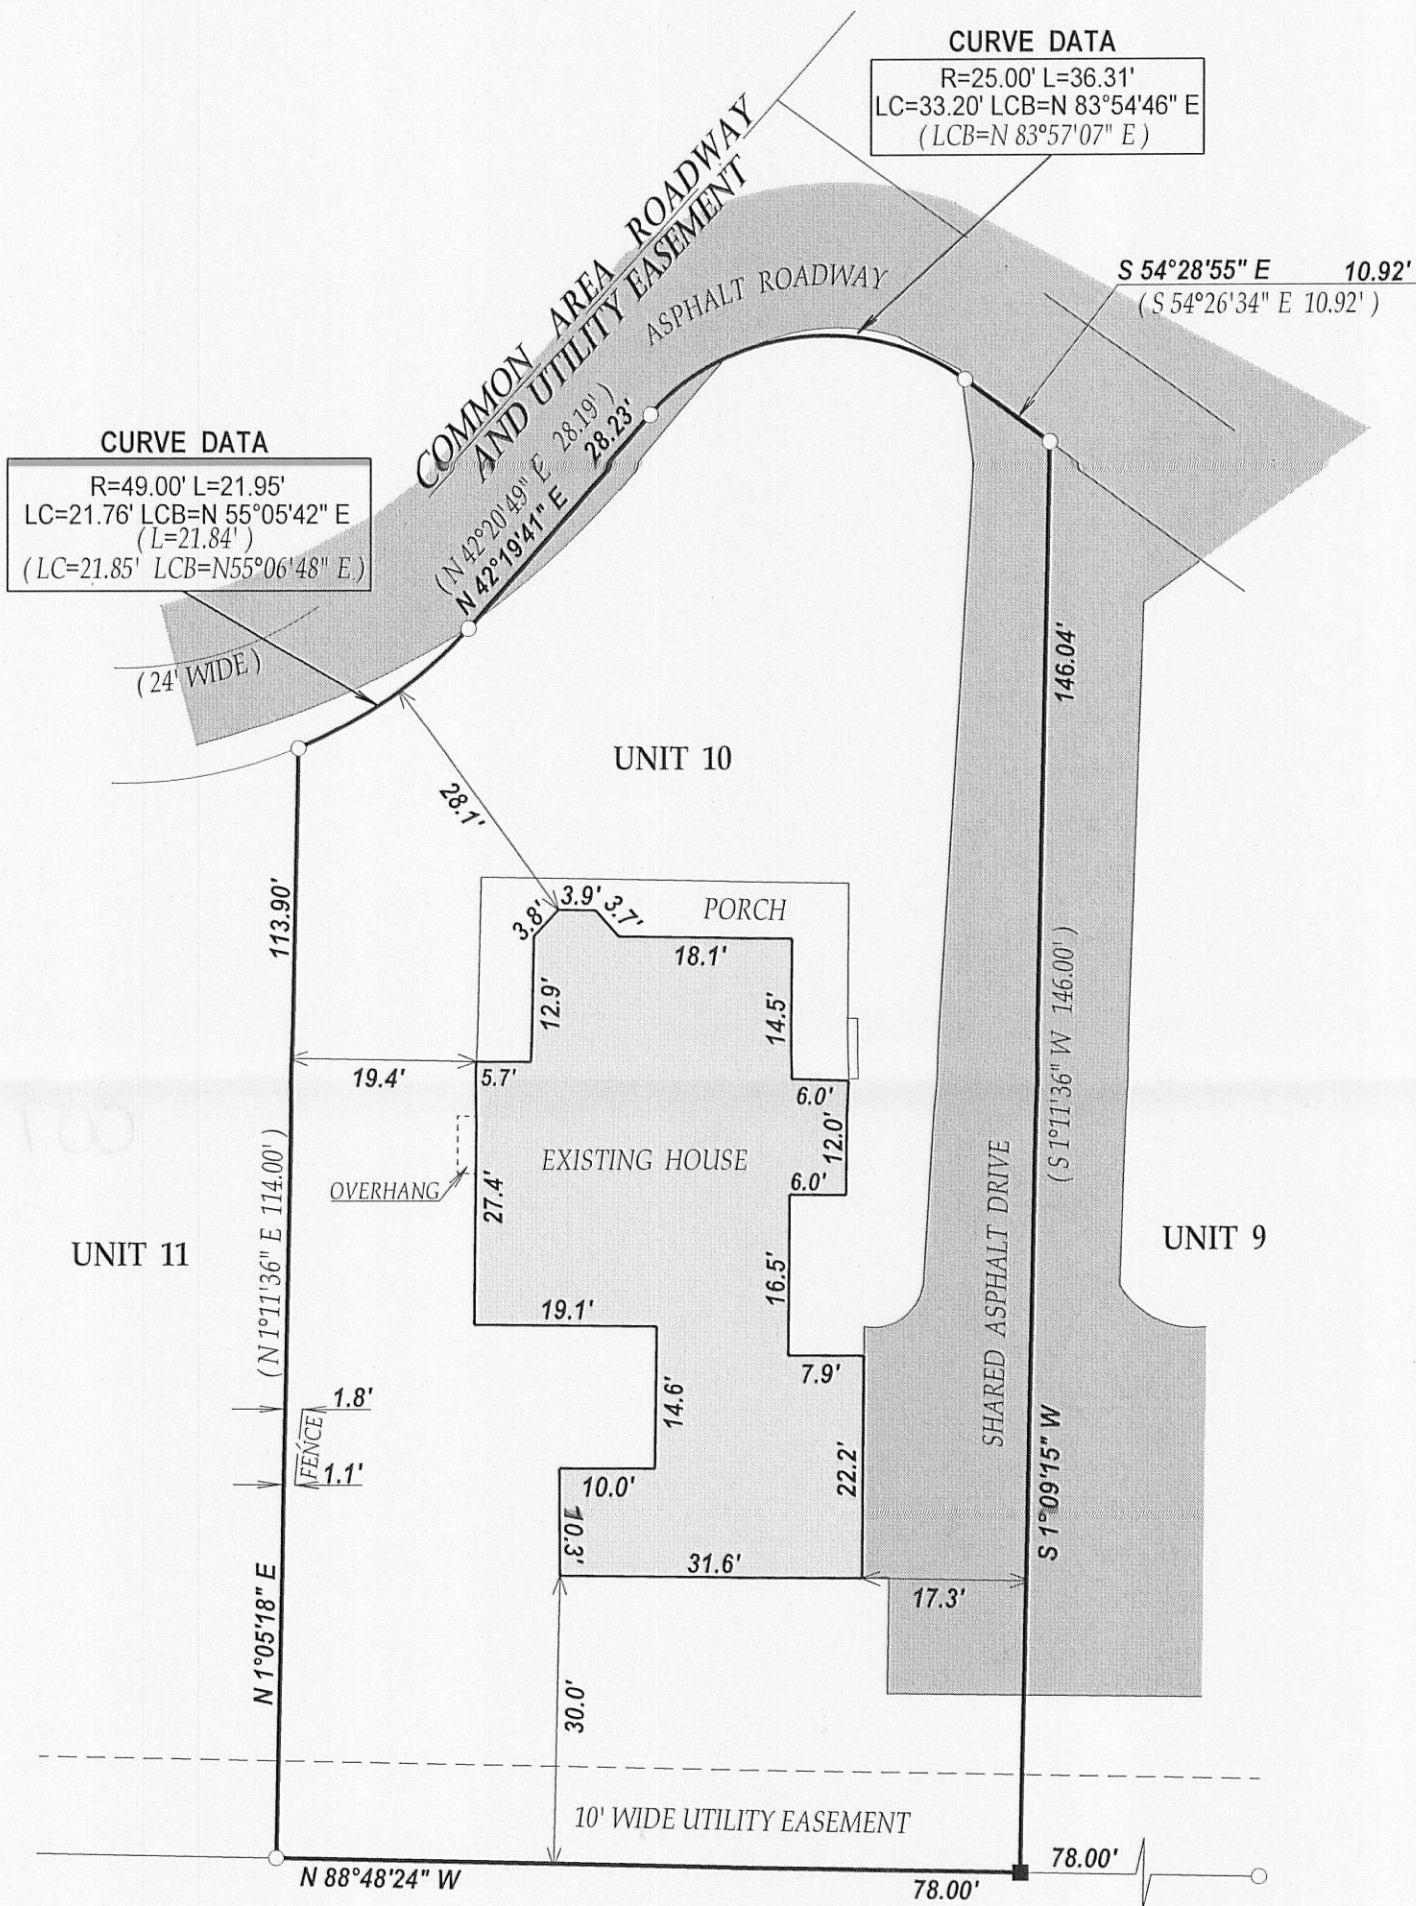


SCALE 1" = 20'



I have surveyed the above-described property and the above map is a true representation thereof and shows the size and location of the property, its exterior boundaries, the location and dimensions of all structures thereon, fences apparent easements and roadways and visible encroachments, if any.

This survey is made for the exclusive use of the present owners of the property, and also those who purchase, mortgage, or insure the title thereto within one (1) year from date hereof; and as to them I warrant the accuracy of said survey map.

NOTE: BEARINGS ARE REFERENCED TO THE RECORDED CONDO PLAT

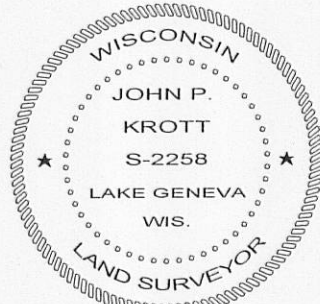

DATED THIS 18th DAY OF MAY 2011.

John P. Krott

JOHN KROTT S - 2258
Wisconsin Registered Land Surveyor
(original if signed in red)

LEGEND

○ FOUND IRON PIPE

■ SET IRON BAR

(xx) RECORDED AS

TAX ID # ZVS00010

JOB # 11-072

007-2815