


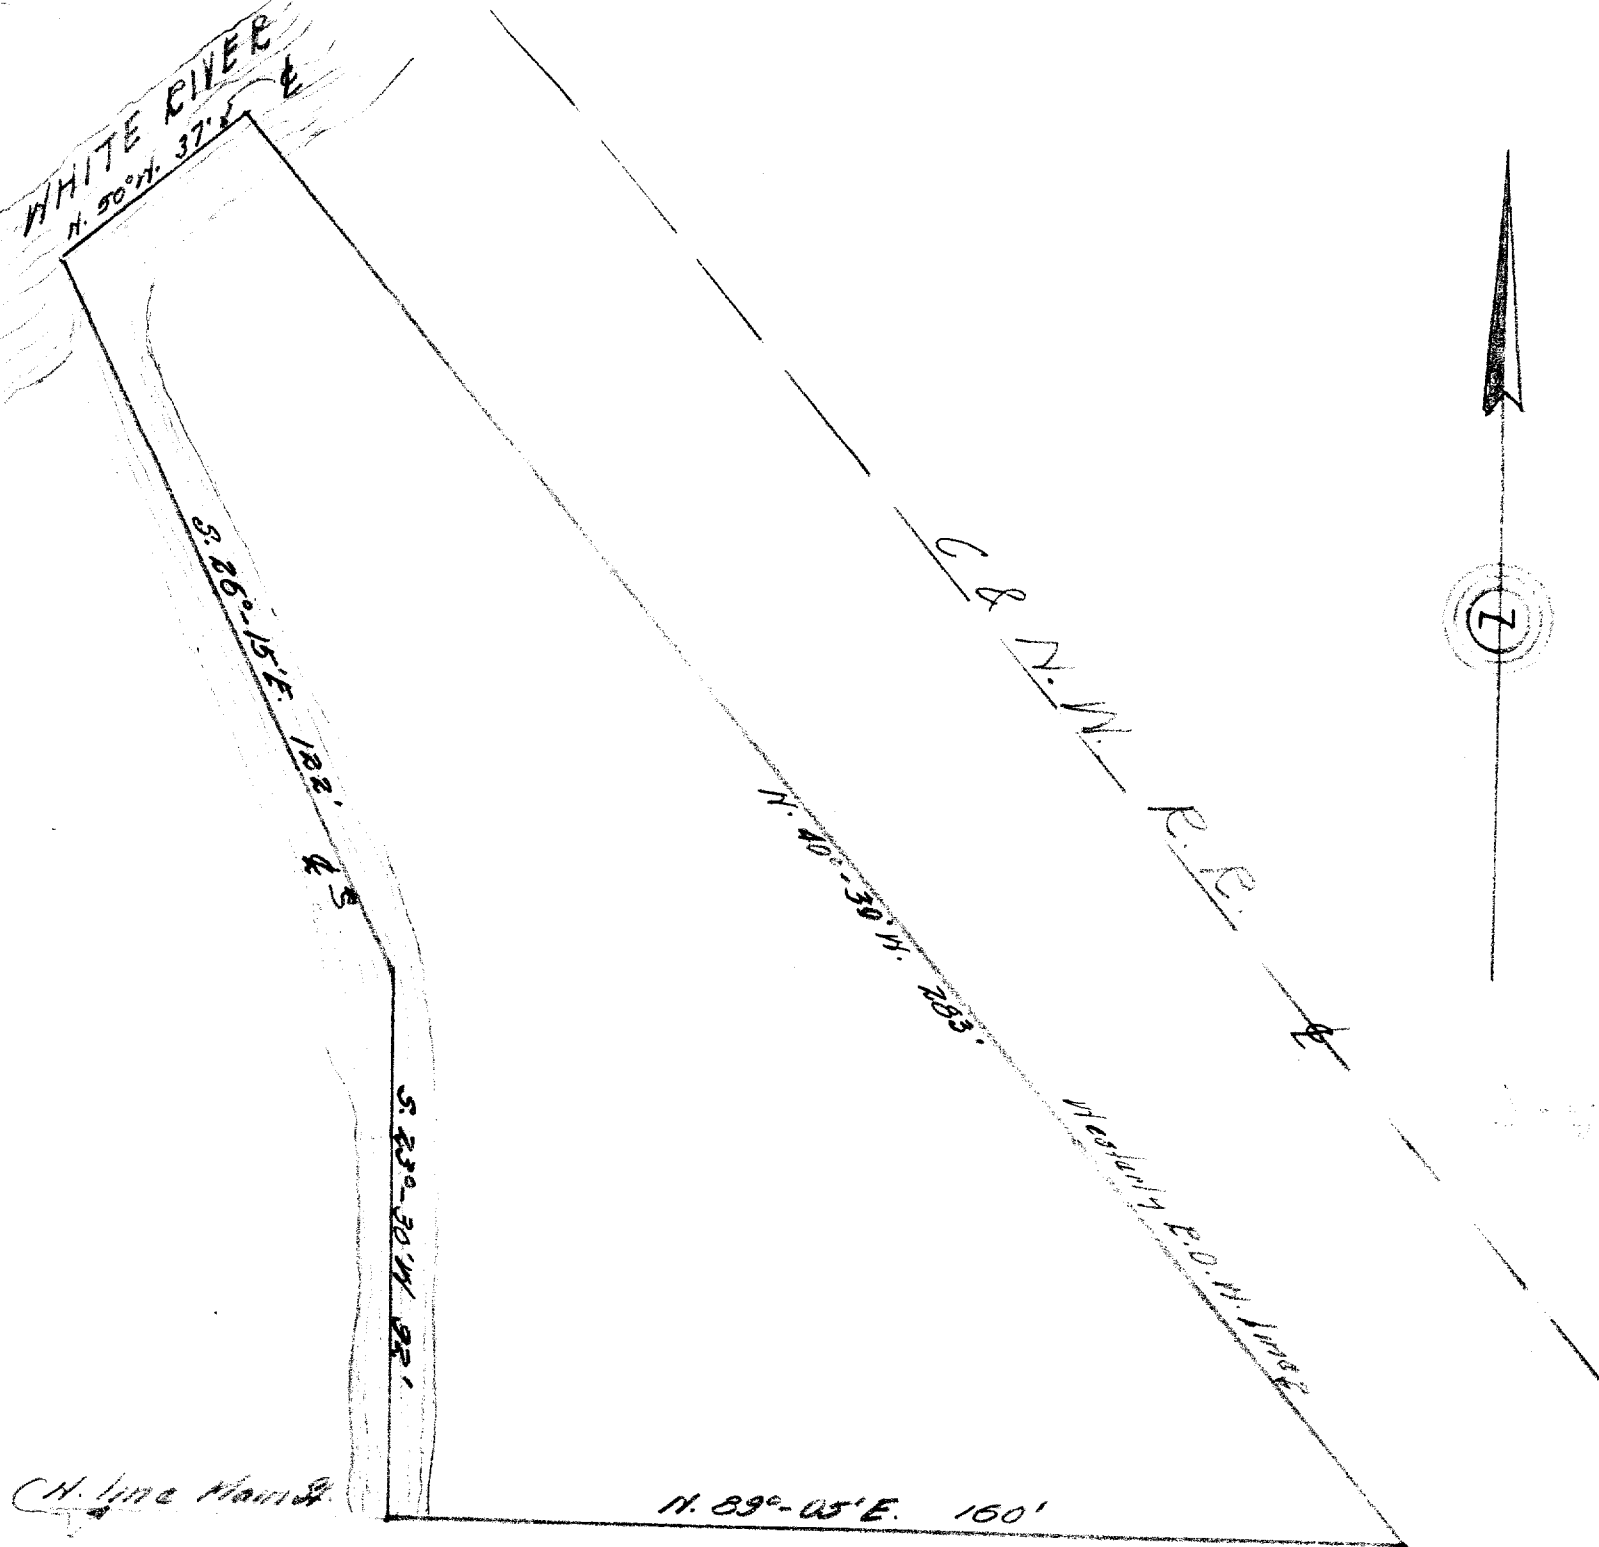

DESCRIPTION: Commencing at a point in the north line of Main Street in the City of Lake Geneva (formerly Village of Geneva) Walworth County, Wisconsin, where the westerly line of the Railway now operated as the Chicago Northwestern Railway, intersects the north line of said Main Street, thence N. 40° 30' W., along the westerly line of said railway right of way, 283 feet to a point, in the centerline of the White River, thence N. 51° W., along the centerline of said river 37 feet to a point, thence S. 26° 15' E., along the centerline of said river 122 feet to a point, thence S. 23° 30' W., along the centerline of said river 92 feet, to a point in the north line of said Main Street, thence N. 89° 05' E., along the north line of Main Street, 160 feet to the place of beginning.

CERTIFICATE: I, hereby certify that I have on this the 15th day of January 1946, surveyed the above described property according to the records on file in the office of the Recorder of Deeds in and for Walworth County, Wisconsin, and find that the measurements and bearings of the boundary lines of said property as taken on this day substantially agree with those in the above description, and that no encroachments exist.

SIGNED AND SEALED THIS 26TH DAY OF January 1946.

Joseph M. Biagi
Joseph M. Biagi.
Professional Engineer.
Elkhorn Wisconsin.