


RIPARIAN RIGHTS SURVEY

-OF-

LOT 6 IN BLOCK 1 IN GENEVA BAY ESTATES, LOCATED IN THE NORTHWEST 1/4 OF THE NORTHEAST 1/4 OF SECTION 2, TOWN 1 NORTH, RANGE 17 EAST, AND THE SOUTHWEST 1/4 OF THE SOUTHEAST 1/4 OF SECTION 35, TOWN 2 NORTH, RANGE 17 EAST, CITY OF LAKE GENEVA AND THE SOUTHEAST 1/4 OF THE SOUTHWEST 1/4 OF SECTION 35, TOWN 2 NORTH, RANGE 17 EAST, AND THE NORTHEAST 1/4 OF THE NORTHWEST 1/4 OF SECTION 2, TOWN 1 NORTH, RANGE 17 EAST, COUNTY OF WALWORTH, AND STATE OF WISCONSIN.

KROTT SURVEYING INC.


N3705 WILLOW BEND LANE
LAKE GENEVA WI 53147
PHONE # (262)248-3697
FAX # (262)249-0639

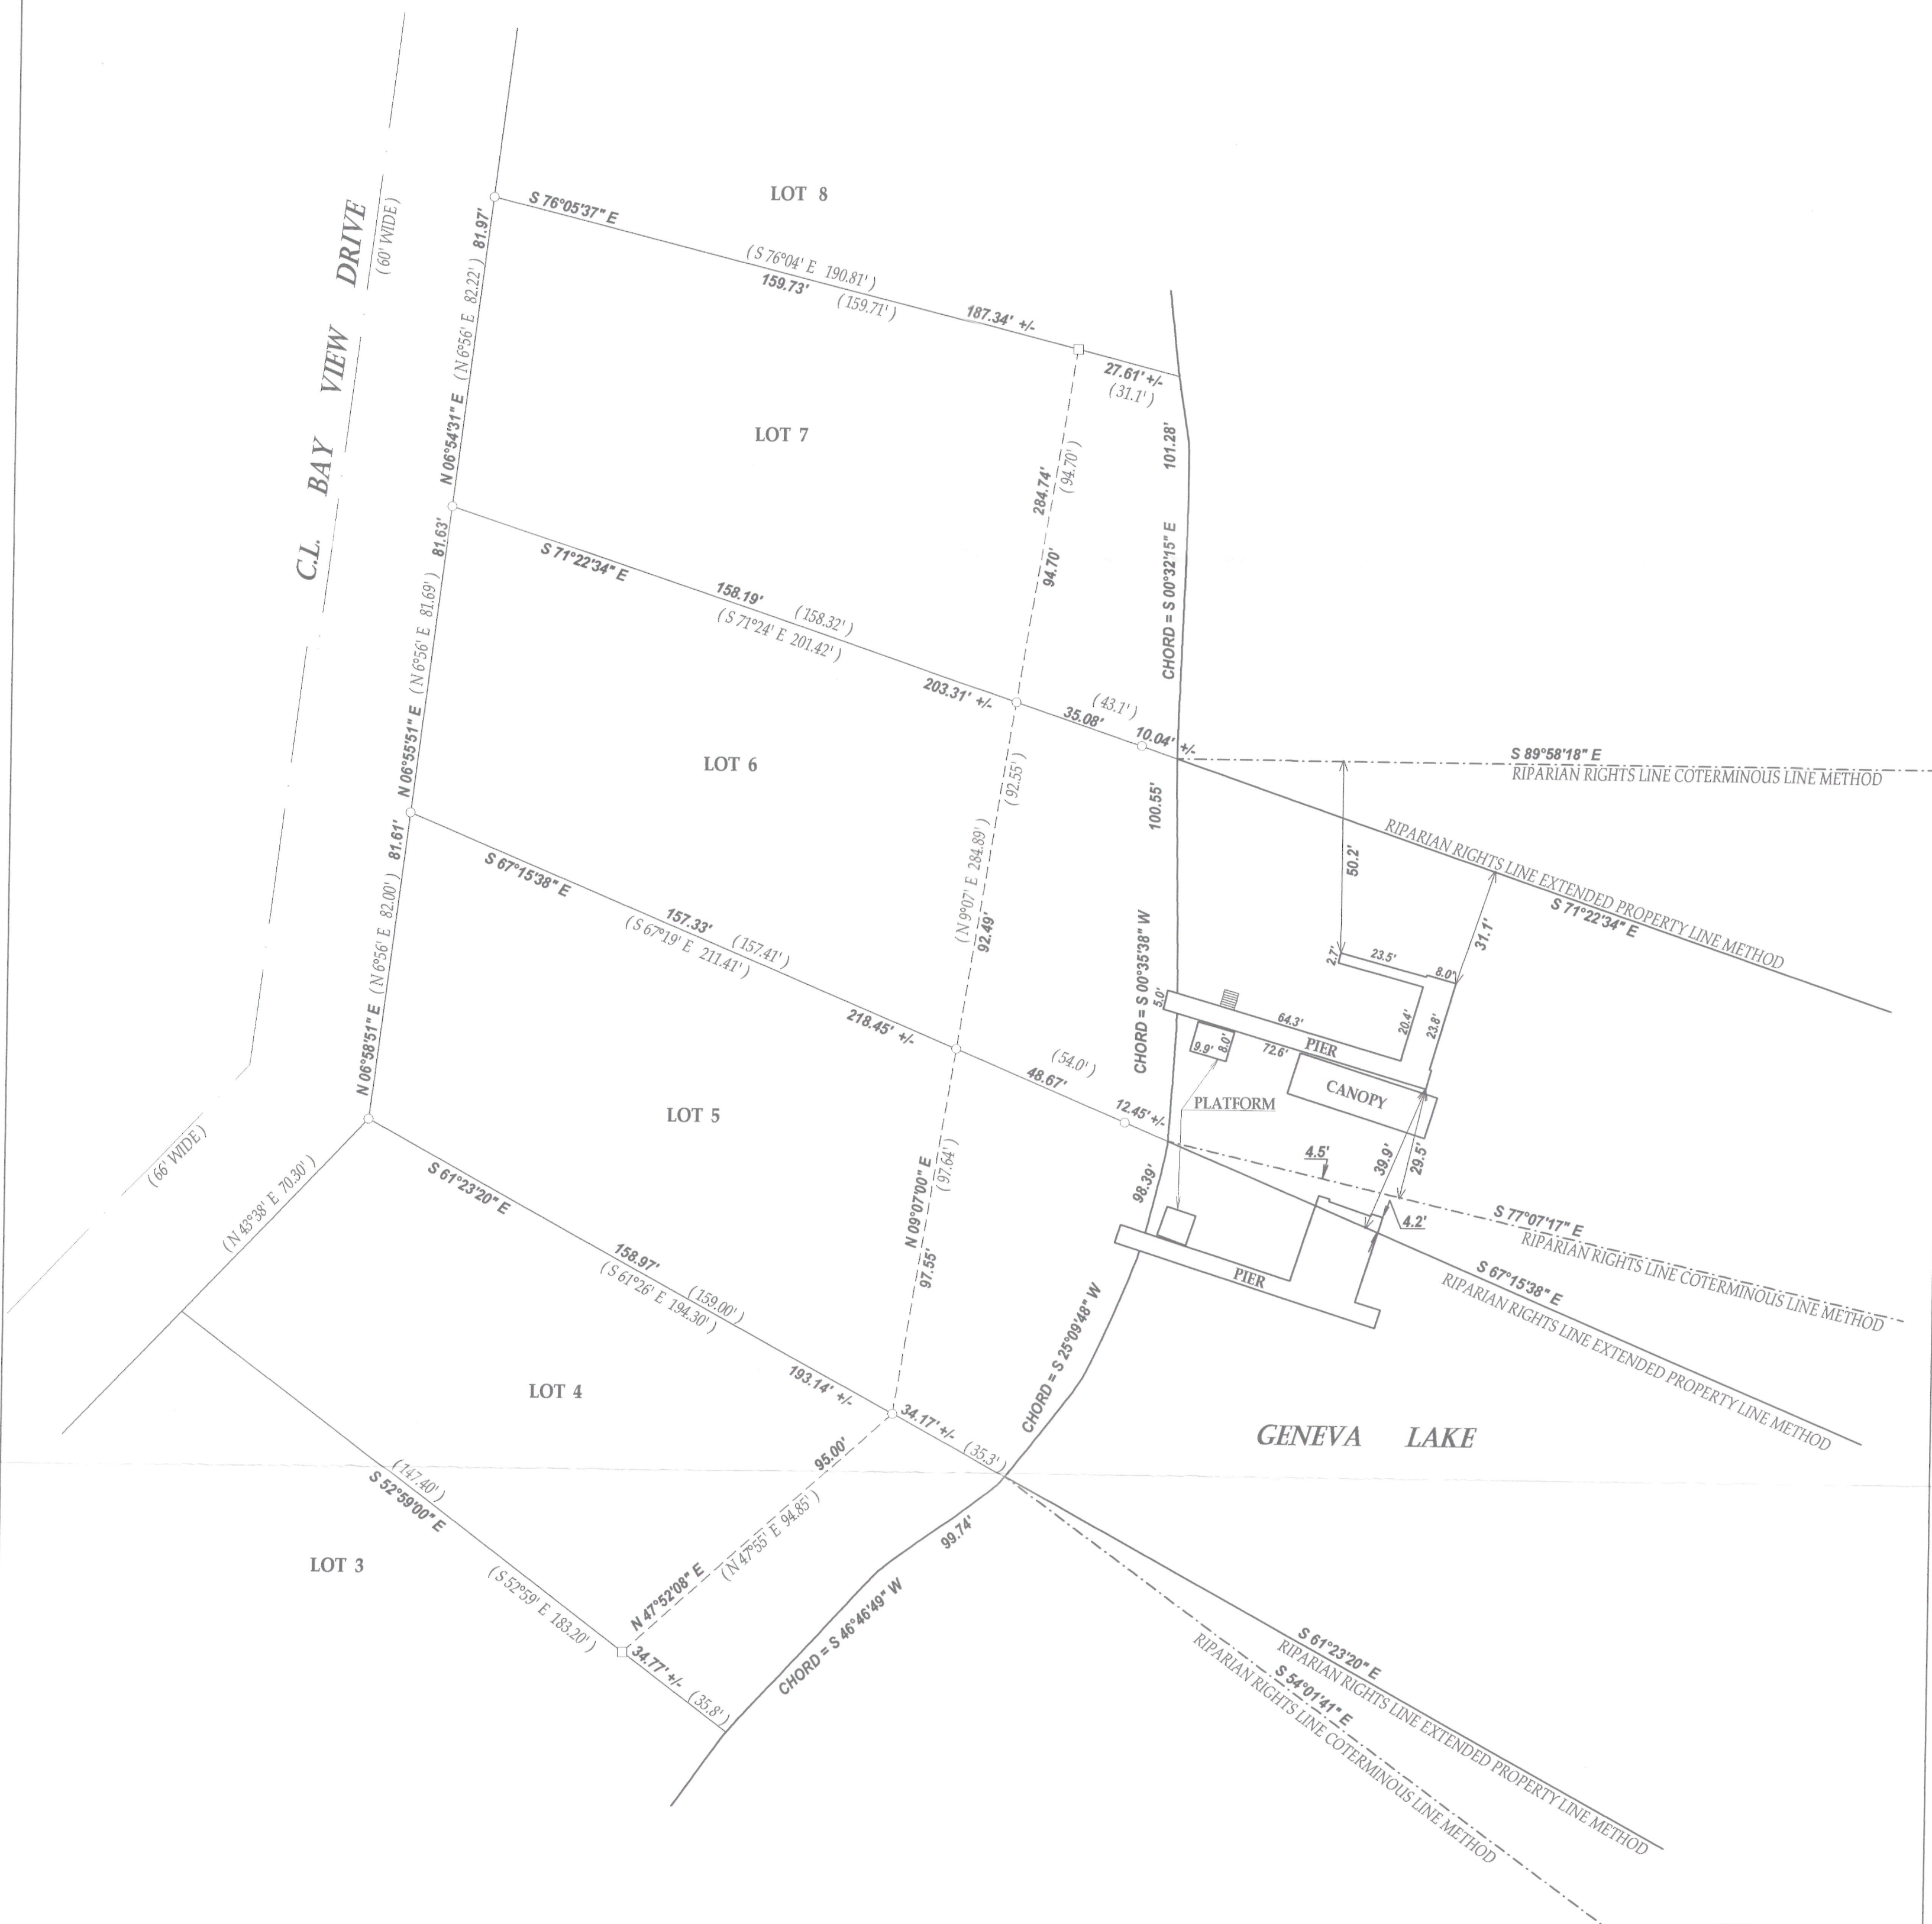

LEGEND


- FOUND IRON PIPE
- FOUND IRON BAR

(xx) RECORDED AS
TAX ID # ZGB00006
JOB # 12-048

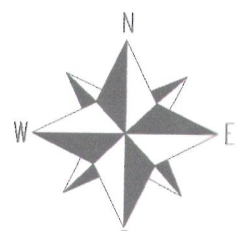

SCALE 1"=30'

NOTE: BEARINGS ARE REFERENCED TO THE RECORD PLAT.

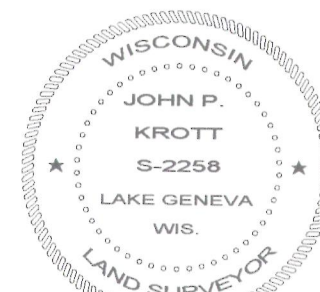

DATED THIS 1st DAY OF MAY 2012.

John P. Krott
JOHN KROTT S-2258
Wisconsin Registered Land Surveyor
(original if signed in red)



007-2878