


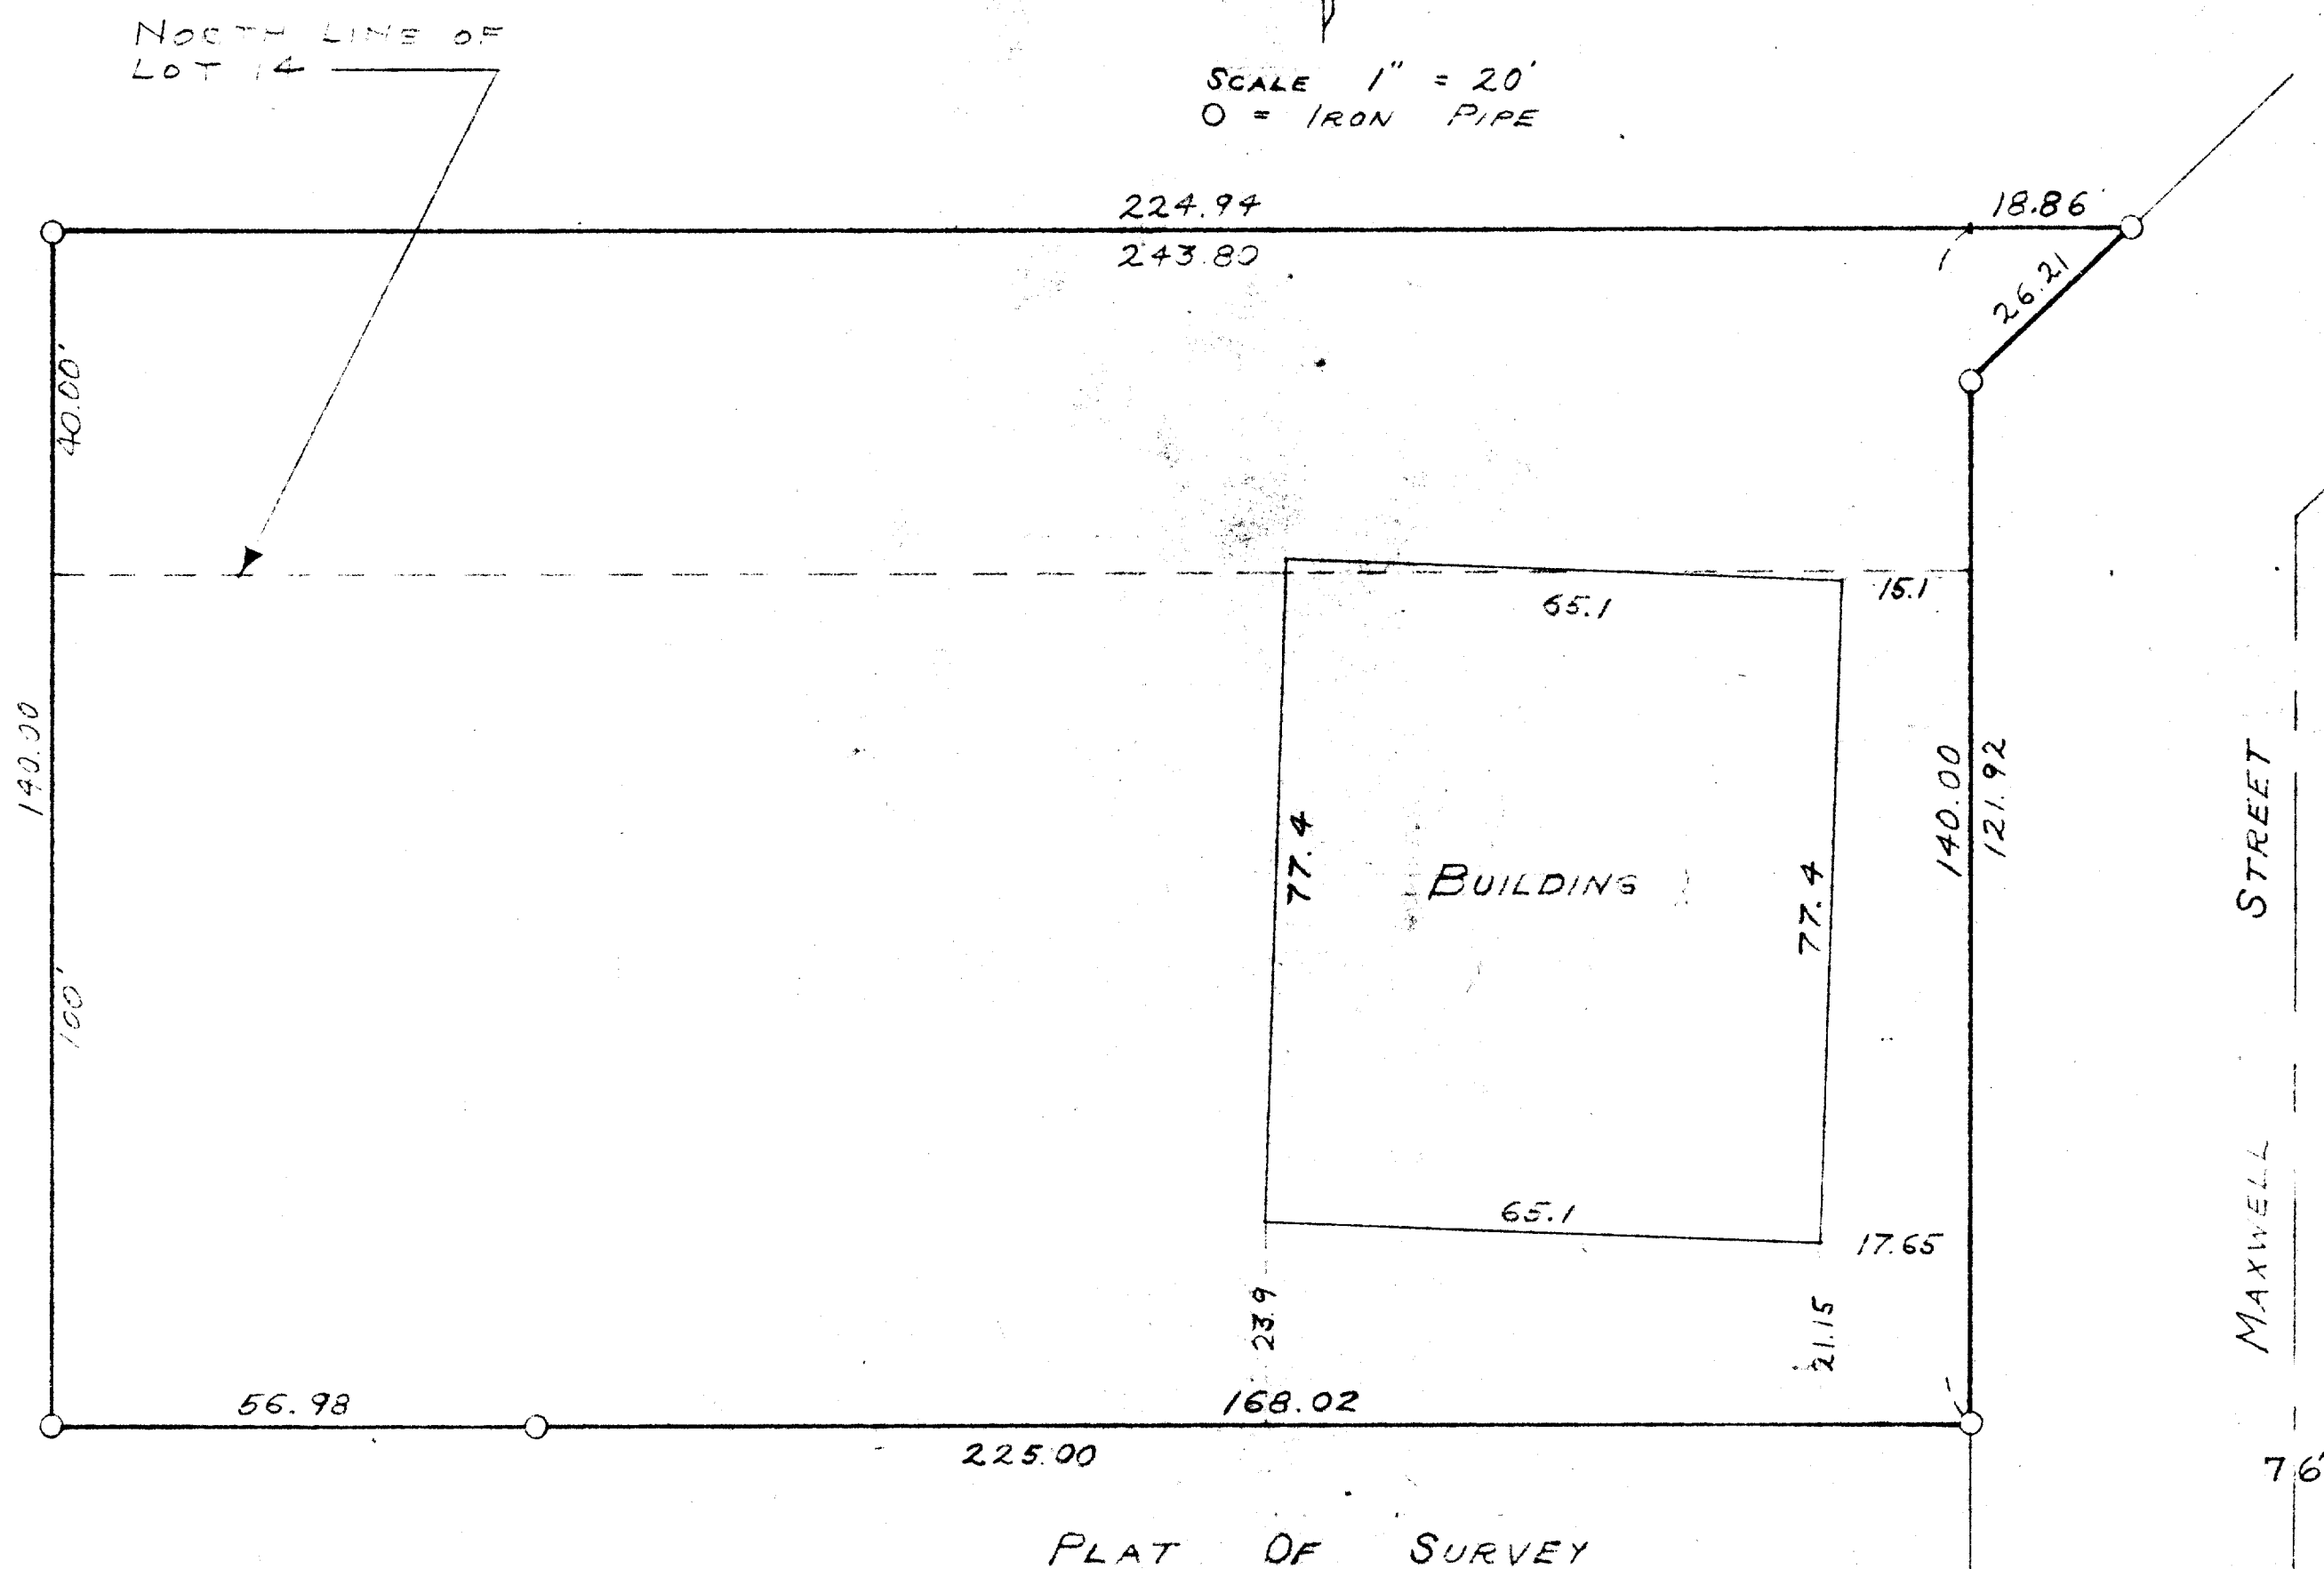

PLAT OF SURVEY

DESCRIPTION:

THE NORTH 100 FEET OF THE EAST 1/2 OF LOTS 13 AND 14 OF 2ND COLUMBIAN SUBDIVISION, AND THE SOUTH 40 FEET OF THE EAST 1/2 OF LOT 15 AND SO MUCH OF LOT 17 AS IS SOUTH OF THE NORTHERLY LINE OF SAID SOUTH 40 FEET OF THE EAST 1/2 OF LOT 15 WHEN SAID LINE IS CONTINUED EASTERLY TO MAXWELL STREET, IN 2ND. COLUMBIAN SUBDIVISION, LOCATED IN THE CITY OF LAKE GENEVA, WALWORTH COUNTY, WISCONSIN.

I, LLOYD L. JENSEN, HEREBY CERTIFY THAT I SURVEYED THE ABOVE DESCRIBED PROPERTY ON AUGUST 27, 1952 ACCORDING TO THE OFFICIAL RECORDS AND THAT THE ABOVE PLAT IS A TRUE REPRESENTATION OF THE BOUNDARY LINES THEREOF, AND THE PRINCIPAL LINES OF PRESENT BUILDINGS THEREON.

Lloyd L. Jensen (Lloyd L. Jensen)

WALWORTH COUNTY SURVEYOR

7-28 J