


44-6

Description: The north 60 feet of lot 12 - Block 31  
Original Plat of the City of Lake Geneva  
Walworth County, Wisconsin.

Certificate: This is to certify, that I have on the 25th day,  
of March, 1944, surveyed the above  
described property, and find that no  
encroachments exist, and that all parts  
of the building thereon and appurtenances  
thereto, are wholly within the boundaries  
of said description, and the measurements  
taken are in agreement with the measurements  
shown upon the recorded plat of said property  
on file in the office of the Recorder of Deeds in  
and for Walworth County, Wisconsin.

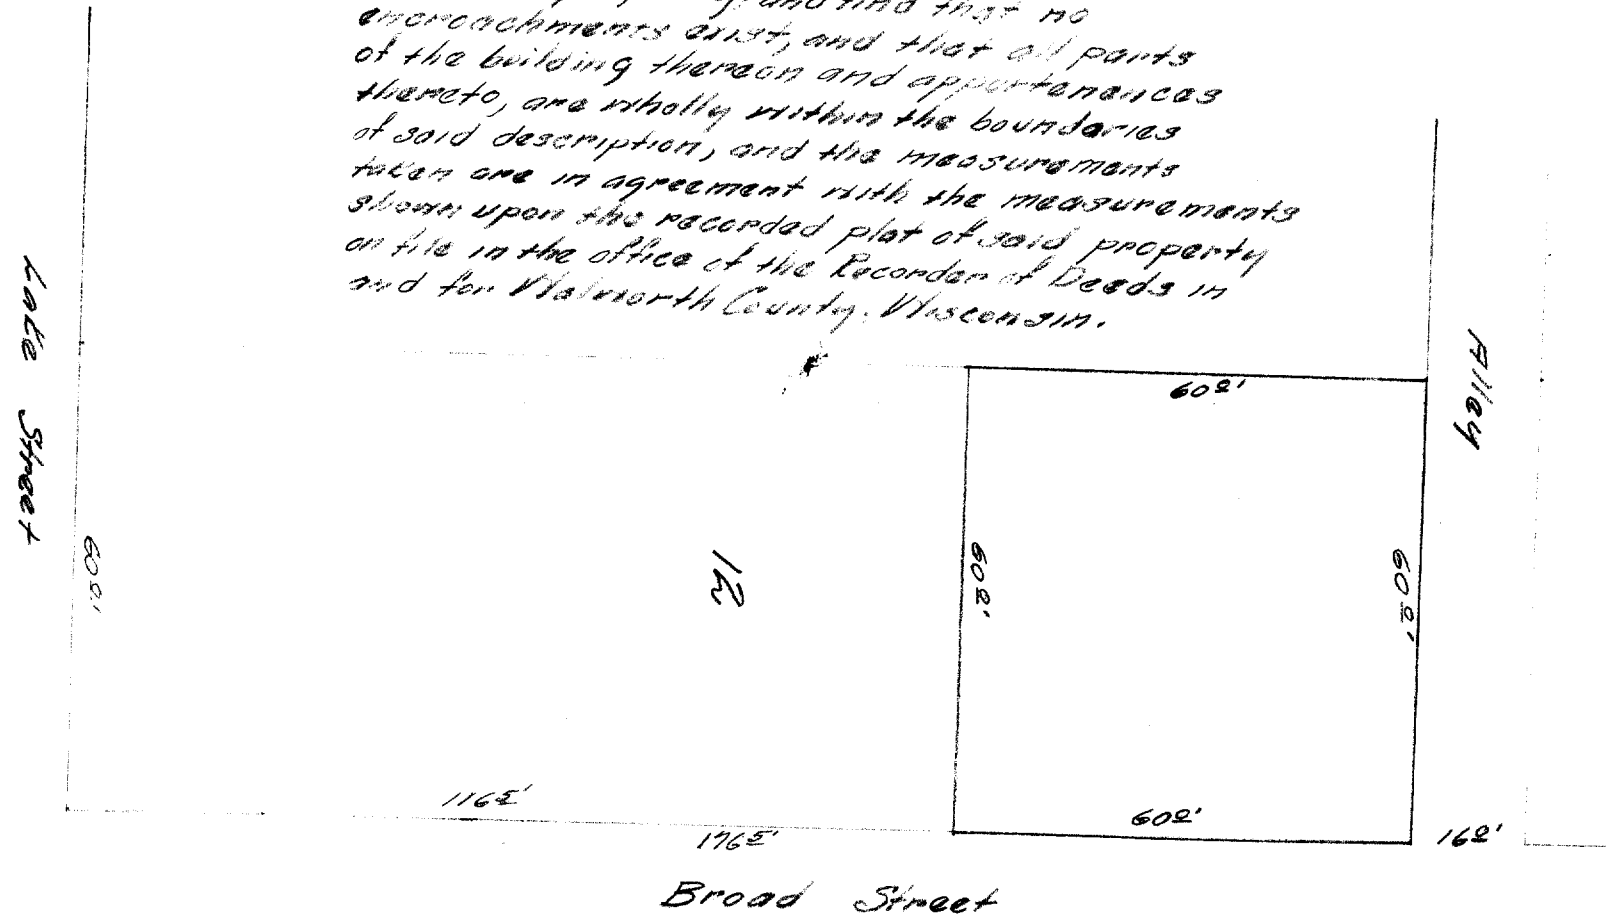

Signed on this the 25th day of April 1944.  
*Joseph M. Biagi.*

NORTH



OP-346

7-291B

Plat of Survey  
North 60 feet of Lot 12, Block 31  
Original Plat - City of Lake Geneva  
Walworth County, Wisconsin.  
By: Joseph M. Biagi  
Professional Eng.  
Eau Claire, Wisconsin.