


PREPARED FOR
JOHN LAW
REMAX GENEVA REALTY
101 BROAD ST.
SUITE 102
LAKE GENEVA WI. 53147

KROTT SURVEYING INC.
N3705 WILLOW BEND LANE
LAKE GENEVA WI. 53147
PHONE # (262)248-3697
FAX # (262)249-0639

PLAT OF SURVEY

-OF-

THE SOUTH 1/2 OF LOTS 11 AND 12, BLOCK 19, OF THE ORIGINAL
PLAT OF THE VILLAGE, NOW CITY OF LAKE GENEVA, WALWORTH
COUNTY, WISCONSIN.

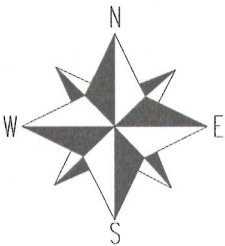

SCALE 1"=20'



I have surveyed the above-described property and the above map is
a true representation thereof and shows the size and location of the
property, its exterior boundaries, the location and dimensions of all
structures thereon, fences apparent easements and roadways and
visible encroachments, if any.

This survey is made for the exclusive use of the present owners of
the property, and also those who purchase, mortgage, or insure the
title thereto within one (1) year from date hereof; and as to them I
warrant the accuracy of said survey map.



DATED THIS 17th DAY OF JANUARY 2013

John P. Krott

JOHN KROTT S - 2258
Wisconsin Registered Land Surveyor
(original if signed in red)

LEGEND


○ FOUND IRON PIPE

△ FOUND P.K. NAIL

(xx) RECORDED AS

TAX ID # ZOP000183

JOB # 13-006

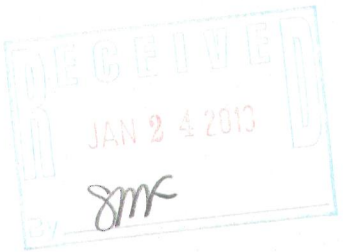

007 2920