



PREPARED FOR
LAEL VANDENBURGH
KEEFE REAL ESTATE
751 GENEVA PARKWAY
LAKE GENEVA WI. 53147

PLAT OF SURVEY


-OF-

KROTT SURVEYING INC.
N3705 WILLOW BEND LANE
LAKE GENEVA WI. 53147
PHONE # (262)248-3697
FAX # (262)249-0639

COMMENCING AT THE NORTHEAST CORNER OF LOT 1, BLOCK 1, WHEELER'S ADDITION TO THE CITY OF LAKE GENEVA, WALWORTH COUNTY, WISCONSIN; THENCE SOUTH 66 FEET TO THE PLACE OF BEGINNING; THENCE WEST 132 FEET TO THE WEST LINE OF LOT 2; THENCE SOUTH ALONG SAID WEST LINE 66 FEET; THENCE EAST 132 FEET TO THE EAST LINE OF LOT 1; THENCE NORTH 66 FEET TO THE PLACE OF BEGINNING, ACCORDING TO THE RECORD PLAT OF SAID ADDITION RECORDED IN VOLUME 4 OF PLATS, PAGE 12, IN THE OFFICE OF THE REGISTER OF DEEDS, IN AND FOR SAID COUNTY OF WALWORTH, WISCONSIN.

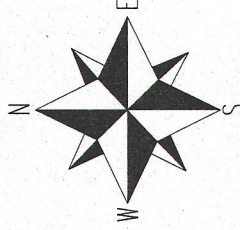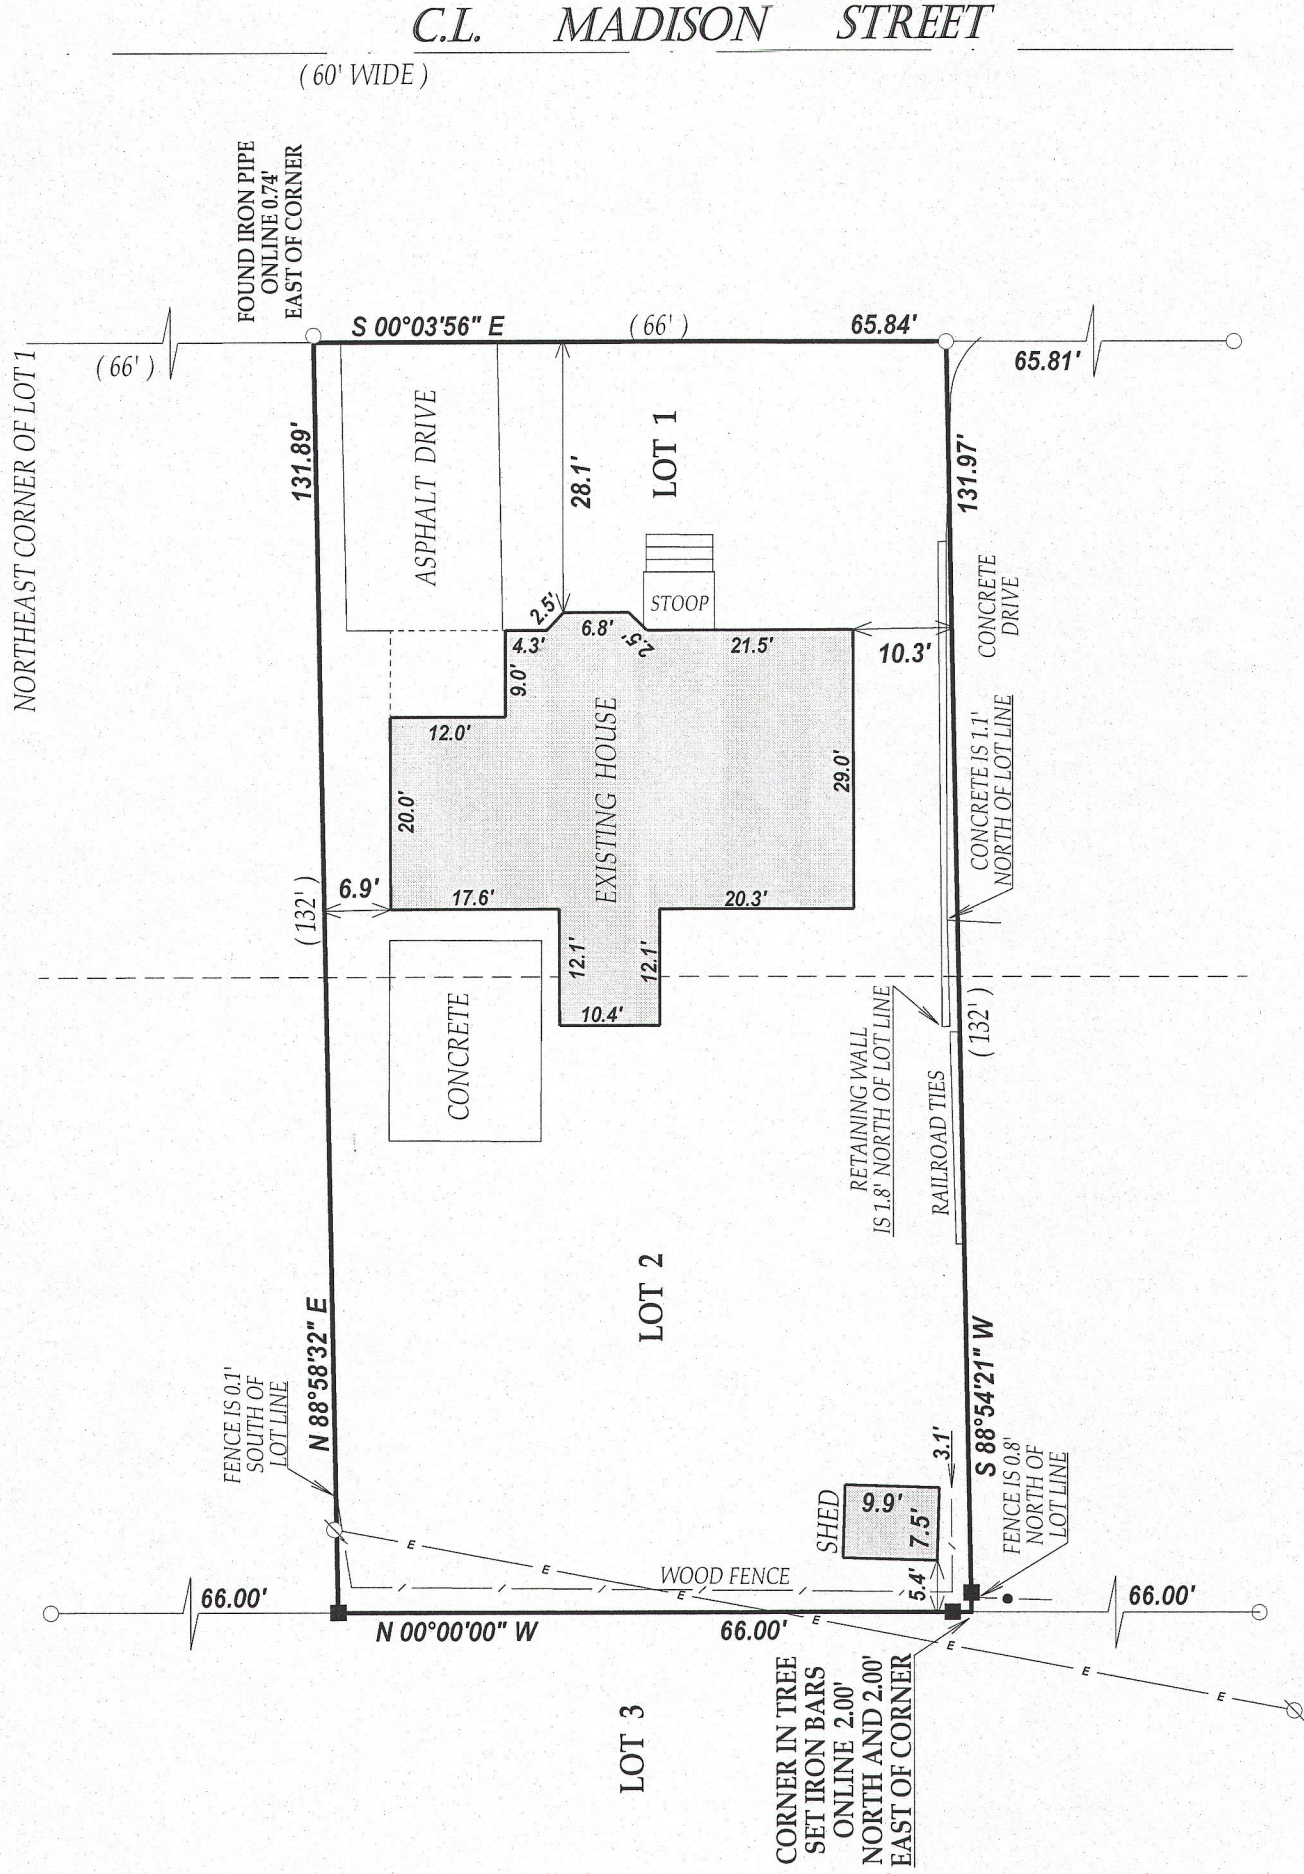

SCALE 1" = 20'

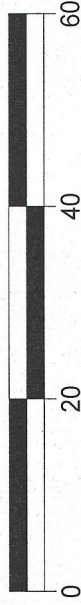

NOTE: THE WEST LINE OF LOT 2 WAS ASSUMED TO BEAR NORTH-SOUTH



LEGEND

- FOUND IRON PIPE
- SET IRON BAR
- ∅ UTILITY POLE
- E— OVERHEAD WIRES

(XX) RECORDED AS

TAX ID# ZVWH00001B

JOB # 13-015

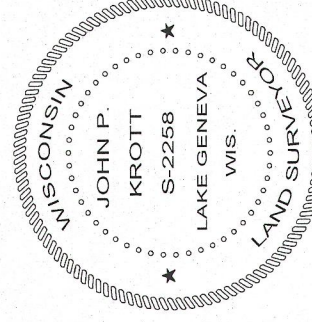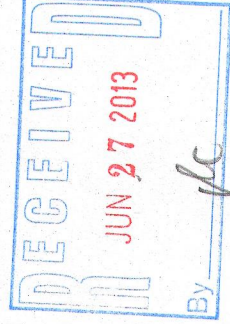

DATED THIS 30th DAY OF JANUARY 2013

John P. Krott

JOHN KROTT S - 2258
Wisconsin Registered Land Surveyor
(original if signed in red)

007-2953