


PLAT OF SURVEY

PATHFINDER SURVEYING INC.
(formerly)
J.K. SURVEYING INC.
P.O. BOX 322
LAKE GENEVA, WI. 53147
WWW.PATHFINDERSURVEYING.NET
262-248-8303

- OF -

LOT 19 WESTGATE SUBDIVISION, CITY OF LAKE GENEVA, AS PER
RECORDED PLAT THEREOF, RECORDED IN VOLUME 17 OF PLATS
ON PAGES 32 AND 33, WALWORTH COUNTY, WISCONSIN.

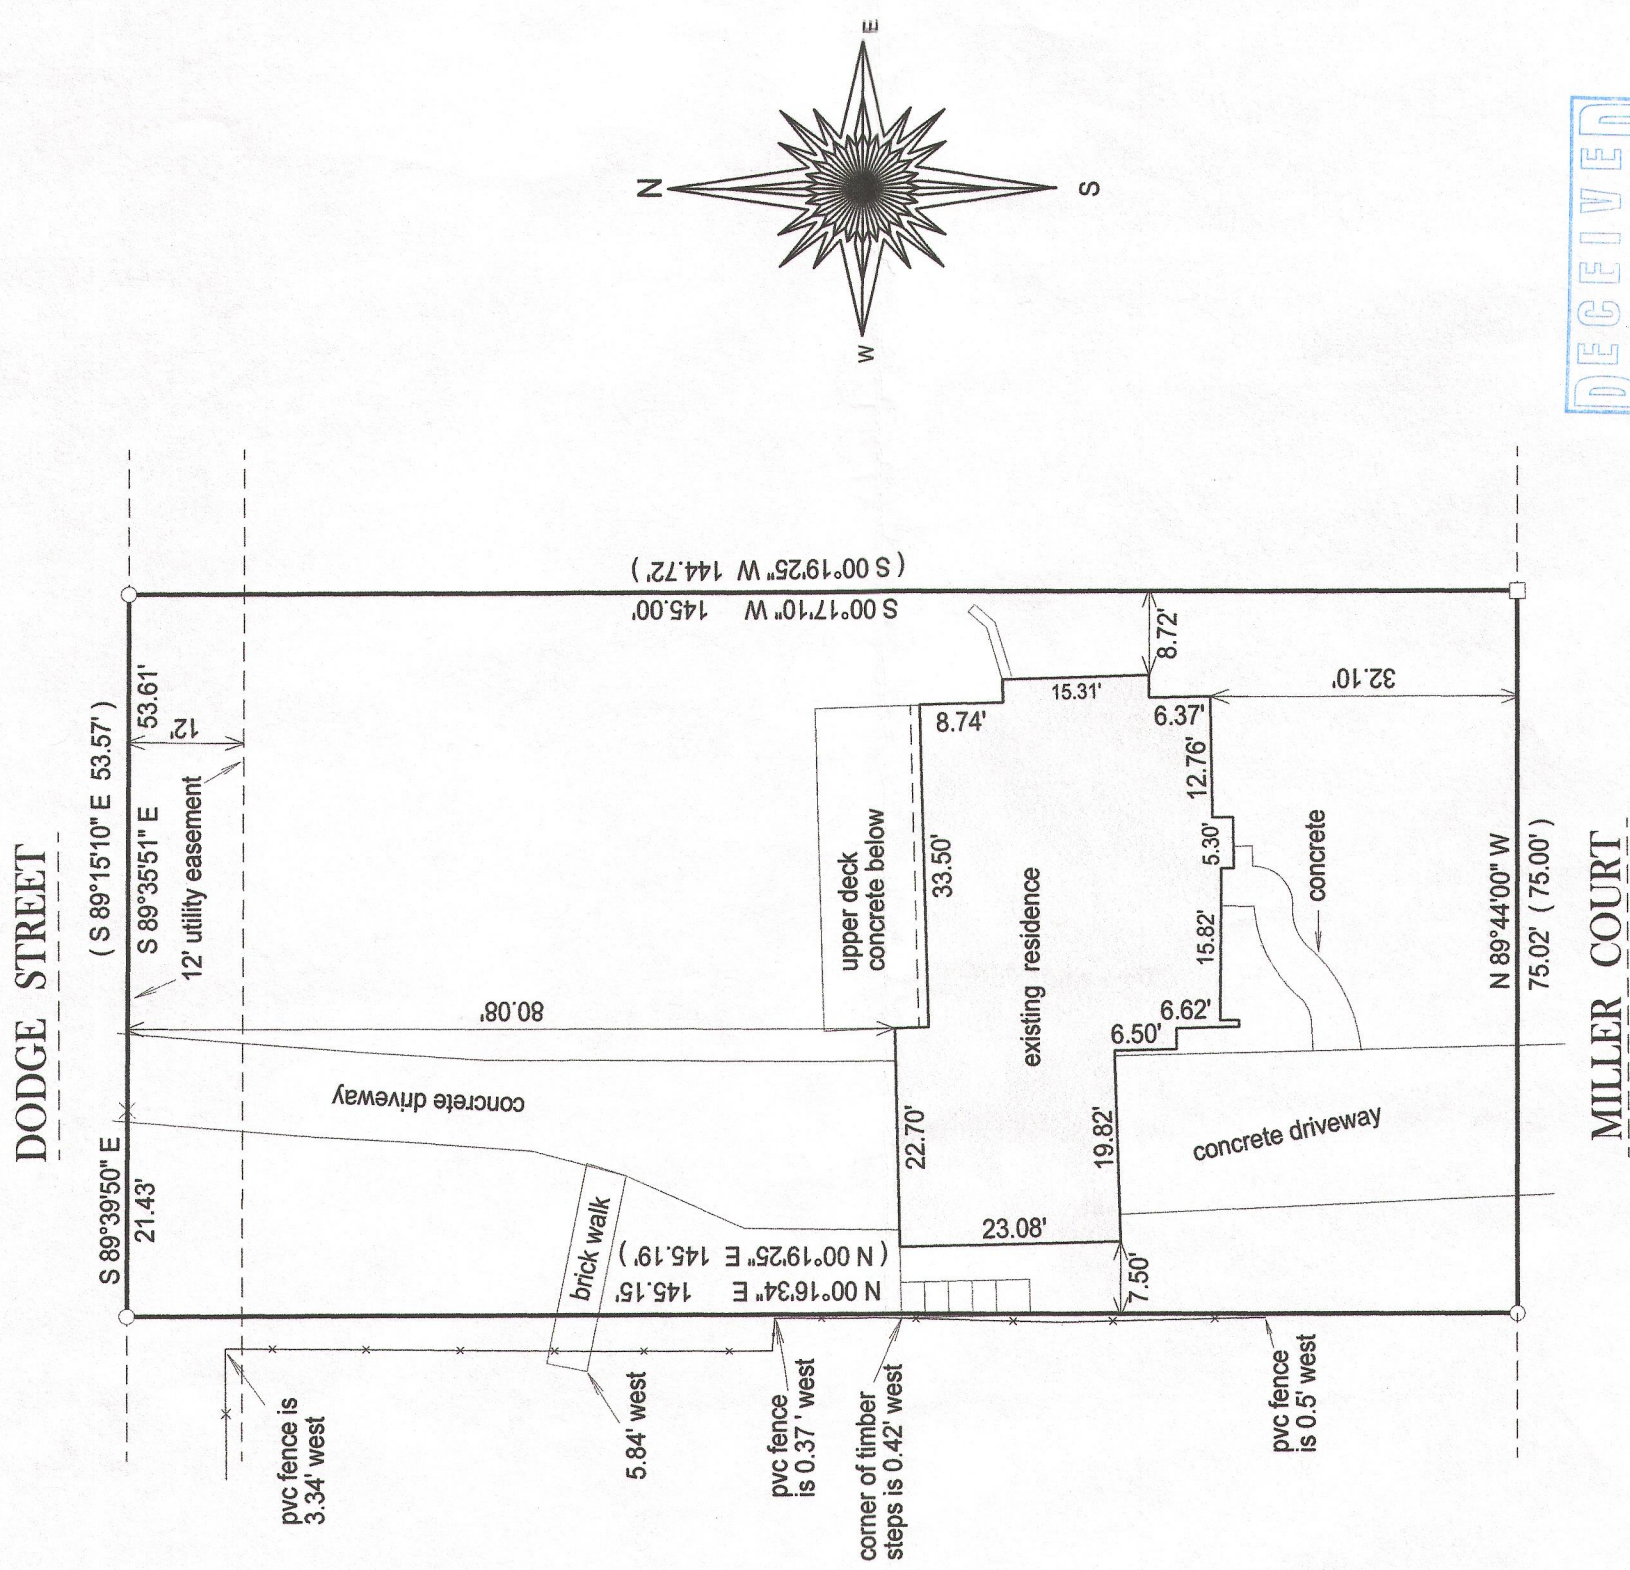

- () = recorded as
- = found iron bar
- = found iron pipe
- = set iron pipe
- = set iron bar

SCALE 1" = 20'

JOB # 13-123

TAX ID #

ZWG 00019

BASIS OF BEARING OF THIS PLAT: THE NORTH LINE OF MILLER CT. WAS ASSUMED TO BEAR N 89°44' W AS SHOWN ON THE RECORD PLAT OF WESTGATE.

I hereby certify that I have surveyed the above-described property and the above map is a true representation thereof and shows the size and location of the property, its exterior boundaries, the location and dimensions of all structures thereon, fences, apparent easements and roadways and visible encroachments if any.

This survey is made for the present owners of the property, and those who purchase, mortgage, or guarantee the title thereto, within one year from the date hereof.

DATED THIS 30TH DAY OF JULY, 2013.

JEFFREY L KIMPS S - 2436
Wisconsin Registered Land Surveyor
(original if signed in red)

007-2970