


PREPARED FOR
ANDREW KERWIN
1616 EVERGREEN LN.
LAKE GENEVA WI. 53147

PLAT OF SURVEY

KROTT SURVEYING INC.
N3705 WILLOW BEND LANE
LAKE GENEVA WI. 53147
PHONE # (262)248-3697
FAX # (262)249-0639

-OF-
LOT 1, BLOCK 14 IN THE MAP OF LAKE GENEVA MANOR TRACT
NO. 17, BEING A SUBDIVISION ON THE EAST 1/2 OF SECTION 35,
TOWN 2 NORTH, RANGE 17 EAST, IN THE CITY OF LAKE GENEVA,
WALWORTH COUNTY, WISCONSIN.

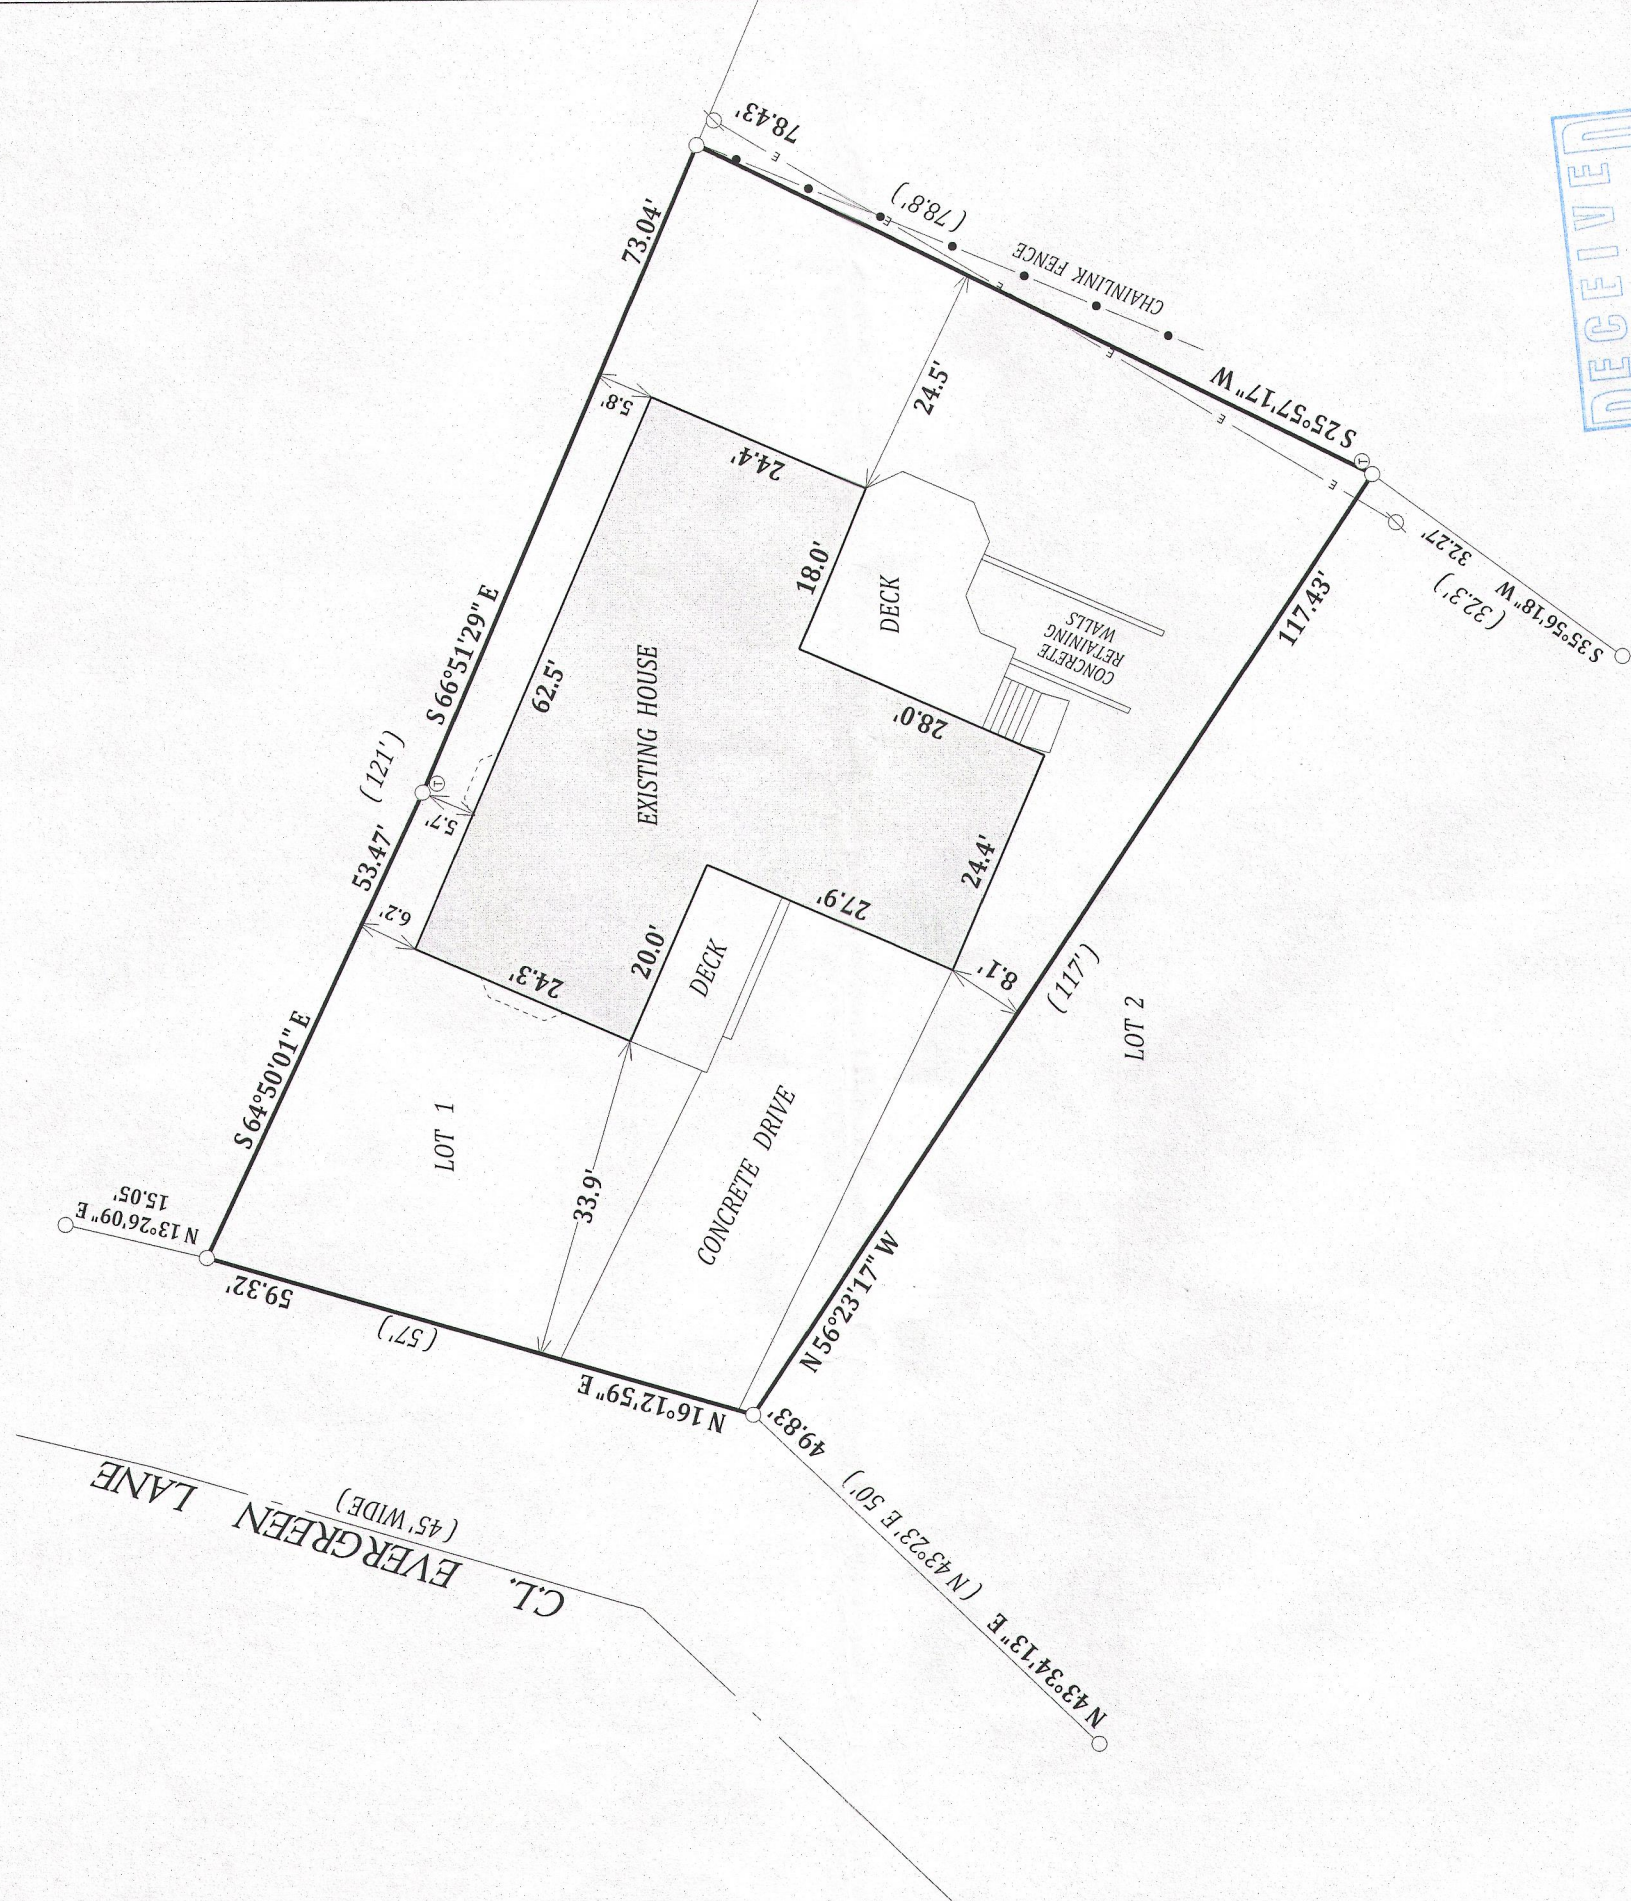

LEGEND

- FOUND IRON PIPE
- FOUND IRON BAR
- ⊙ TELEPHONE PEDESTAL
- ∅ UTILITY POLE
- OVERHEAD WIRES

(XX) RECORDED AS

TAX ID # ZLM00013

JOB # 13-103



SCALE 1" = 20'



NOTE: BEARINGS ARE REFERENCED TO PREVIOUS SURVEY RECORDS

I have surveyed the above-described property and the above map is a true representation thereof and shows the size and location of the property, its exterior boundaries, the location and dimensions of all structures thereon, fences apparent easements and roadways and visible encroachments, if any.

This survey is made for the exclusive use of the present owners of the property, and also those who purchase, mortgage, or insure the title thereto within one (1) year from date hereof; and as to them I warrant the accuracy of said survey map.

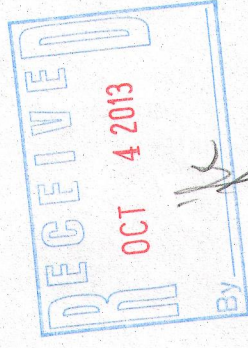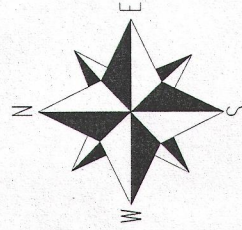

DATED THIS 16th DAY OF JULY 2013

John P. Krott

JOHN KROTT S - 2258
Wisconsin Registered Land Surveyor
(original if signed in red)

007-2976