


Wisconsin Registered Land Surveyor S-2582

**N9330 Knuteson Drive
Whitewater, WI 53190
Phone: (262) 495-3284
FAX : (262) 495-8421
LAND-MARKSURVEYING.COM**

LOTS 8, 9 AND 10 OF BOULEVARD SUBDIVISION TOGETHER WITH THE EAST 10 FEET OF THE VACATED ALLEY, LOCATED IN PART OF THE NORTHEAST 1/4 OF SECTION 1, TOWN 1 NORTH, RANGE 17 EAST, CITY OF LAKE GENEVA, WALWORTH COUNTY, WISCONSIN.

**ORDERED BY: JACQUELINE G. HROVAT
MALLERY & ZIMMERMAN
731 NORTH JACKSON ST.
SUITE 900
MILWAUKEE, WI 53202-4697**

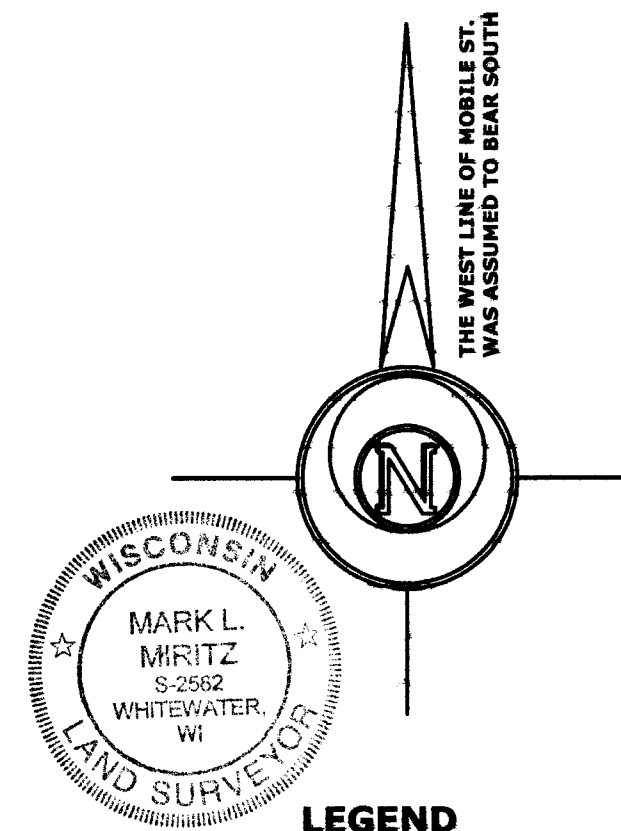

	FOUND IRON PIPE 1.25"
	FOUND IRON ROD .75"
(X X)	RECORDED AS DIMENSION

SCALE: 1 INCH = 30 FEET

"I hereby certify that the above described property has been surveyed by me or under my direction and that the above map is a true representation thereof and shows the size and location of the property, its exterior boundaries, the location of all visible structures and dimensions of all principal buildings thereon, boundary fences, apparent easements, roadways and visible encroachments, if any."

"This survey is made for the use of the present owners of the property, and also those who purchase, mortgage, or guarantee the title thereto within one year from date hereof."

Mark L. Miritz
MARK L. MIRITZ
WISCONSIN REGISTERED
LAND SURVEYOR S-2582

DATE: NOV. 20, 2013 JOB NO. 13.1102

DEC 1 2 2013

g

ZBL - 12
ZBL - 12A

007-2989