


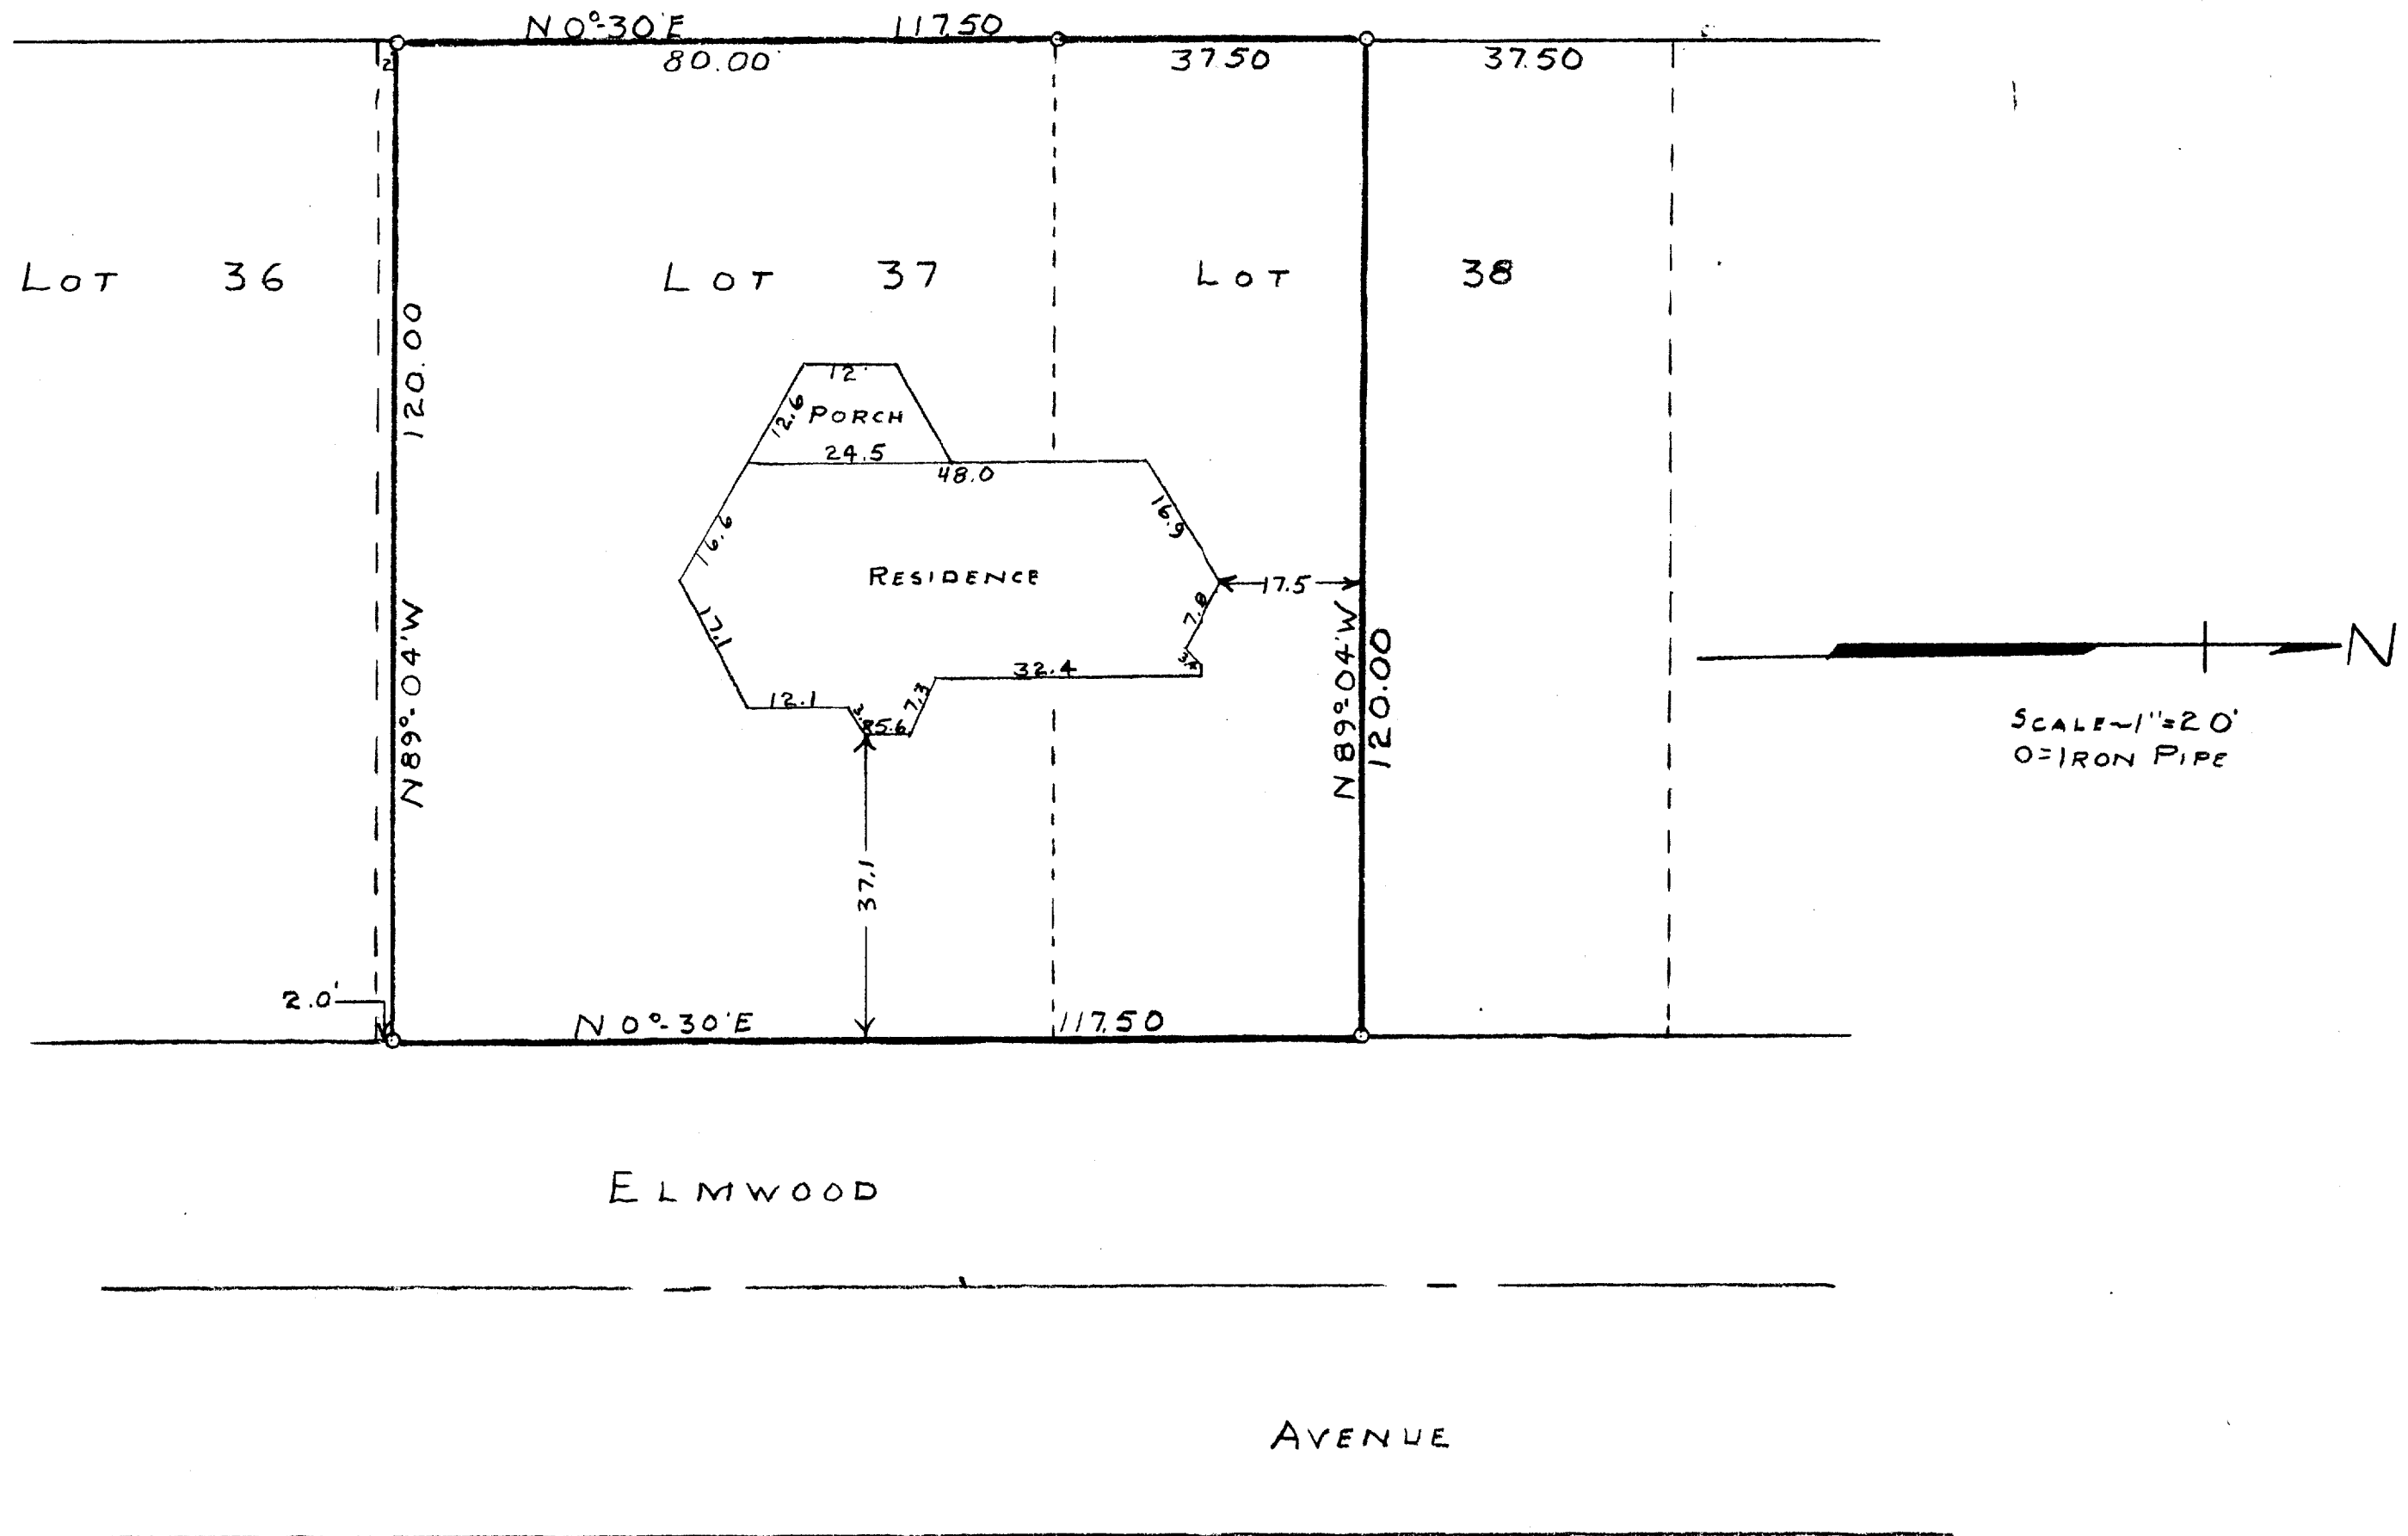

STATE OF WISCONSIN)^{SS}
COUNTY OF WALWORTH)

I, GEORGE T. DUNHAM, DO HEREBY CERTIFY THAT I HAVE SURVEYED THE
PROPERTY DESCRIBED AS FOLLOWS:

LOT 37 AND THE SOUTH 1/2 OF OF LOT 38 OF STURWOOD ADDITION,
LOCATED IN THE CITY OF LAKE GENEVA, WALWORTH COUNTY, WISCONSIN
EXCEPTING THEREFROM THE SOUTH 2.00 FEET OF SAID LOT 37.

AND THAT THE PLAT SHOWN ABOVE IS A CORRECT REPRESENTATION OF THE
PROPERTY LINES
MARCH 26, 1956

George T. Dunham
GEORGE T. DUNHAM, SURVEYOR
DELAN, WISCONSIN

7-30