
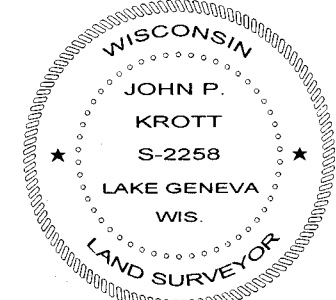


PREPARED FOR
DAN DRAPER
BRADEN, OLSON & DRAPER LLP
716 WISCONSIN ST.
PO BOX 940
LAKE GENEVA WI. 53147

KROTT SURVEYING INC.
(262) 248-3697
N 3705 WILLOW BEND LANE
LAKE GENEVA WI. 53147

PLAT OF SURVEY OF

LOTS 89, 90, 91, 92 AND 93 EXCEPTING THE EASTERLY 35 FEET OF LOT 89 IN THE COLUMBIAN SUBDIVISION IN THE CITY OF LAKE GENEVA, WALWORTH COUNTY, WISCONSIN, ACCORDING TO THE PLAT THEREOF RECORDED IN THE OFFICE OF THE REGISTER OF DEEDS FOR WALWORTH COUNTY, WISCONSIN, IN VOLUME 5 OF PLATS AT PAGE 45.

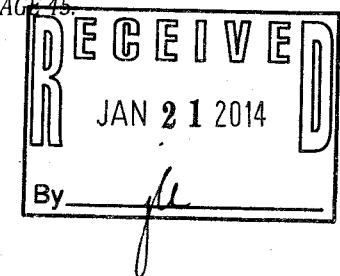


DATED THIS 5th DAY OF NOVEMBER 2013

John P. Krott
JOHN P. KROTT S-2258
WISCONSIN REGISTERED LAND SURVEYOR
(NOTE: THIS IS NOT A CERTIFIED COPY
UNLESS SIGNED IN RED INK)

I have surveyed the above-described property and the above map is a true representation thereof and shows the size and location of the property, its exterior boundaries, the location and dimensions of all structures thereon, fences apparent easements and roadways and visible encroachments, if any.

This survey is made for the exclusive use of the present owners of the property, and also those who purchase, mortgage, or insure the title thereto within one (1) year from date hereof; and as to them I warrant the accuracy of said survey map.

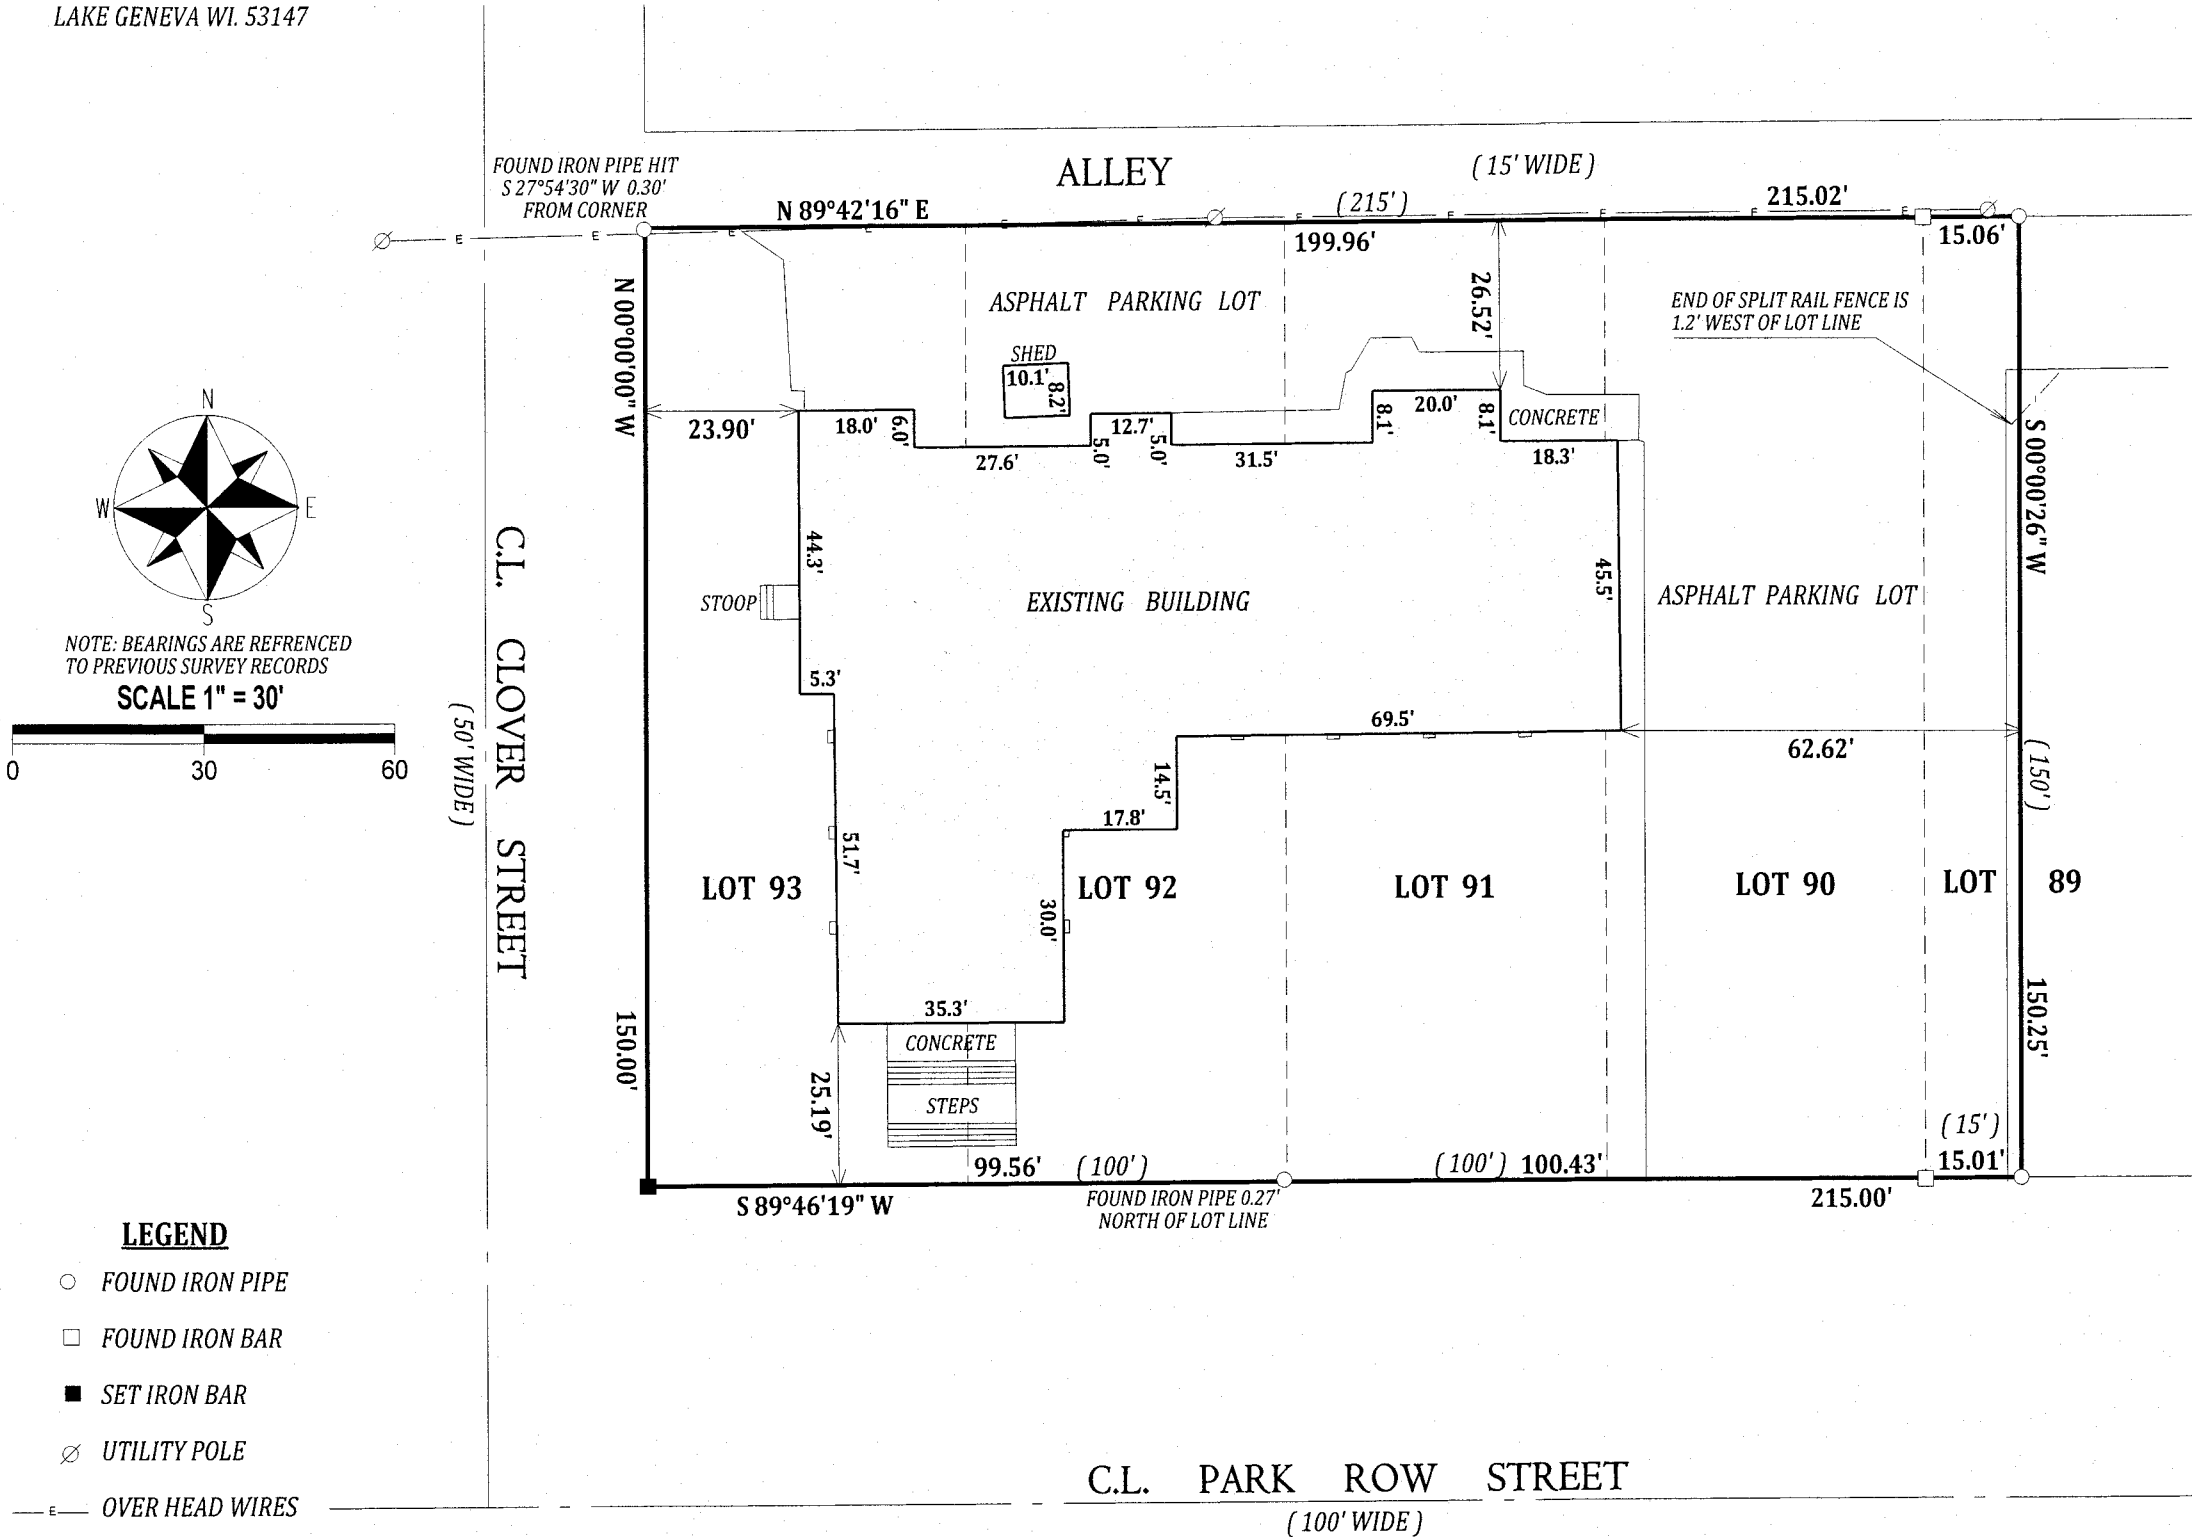

ZCL -75
ZCL -75A

007-3006