


PREPARED FOR
JAMES BRUGGER
429 THEATRE RD.
WILLIAMS BAY WI. 53191

PLAT OF SURVEY OF
LOT 23 IN COLUMBIAN SUBDIVISION, BEING A PART OF THE NORTHEAST 1/4 OF
SECTION 26, IN TOWN 2 NORTH, RANGE 17 EAST, IN THE CITY OF LAKE GENEVA
WALWORTH COUNTY, WISCONSIN.

KROTT SURVEYING INC.
(262) 248-3697
N 3705 WILLOW BEND LANE
LAKE GENEVA WI. 53147

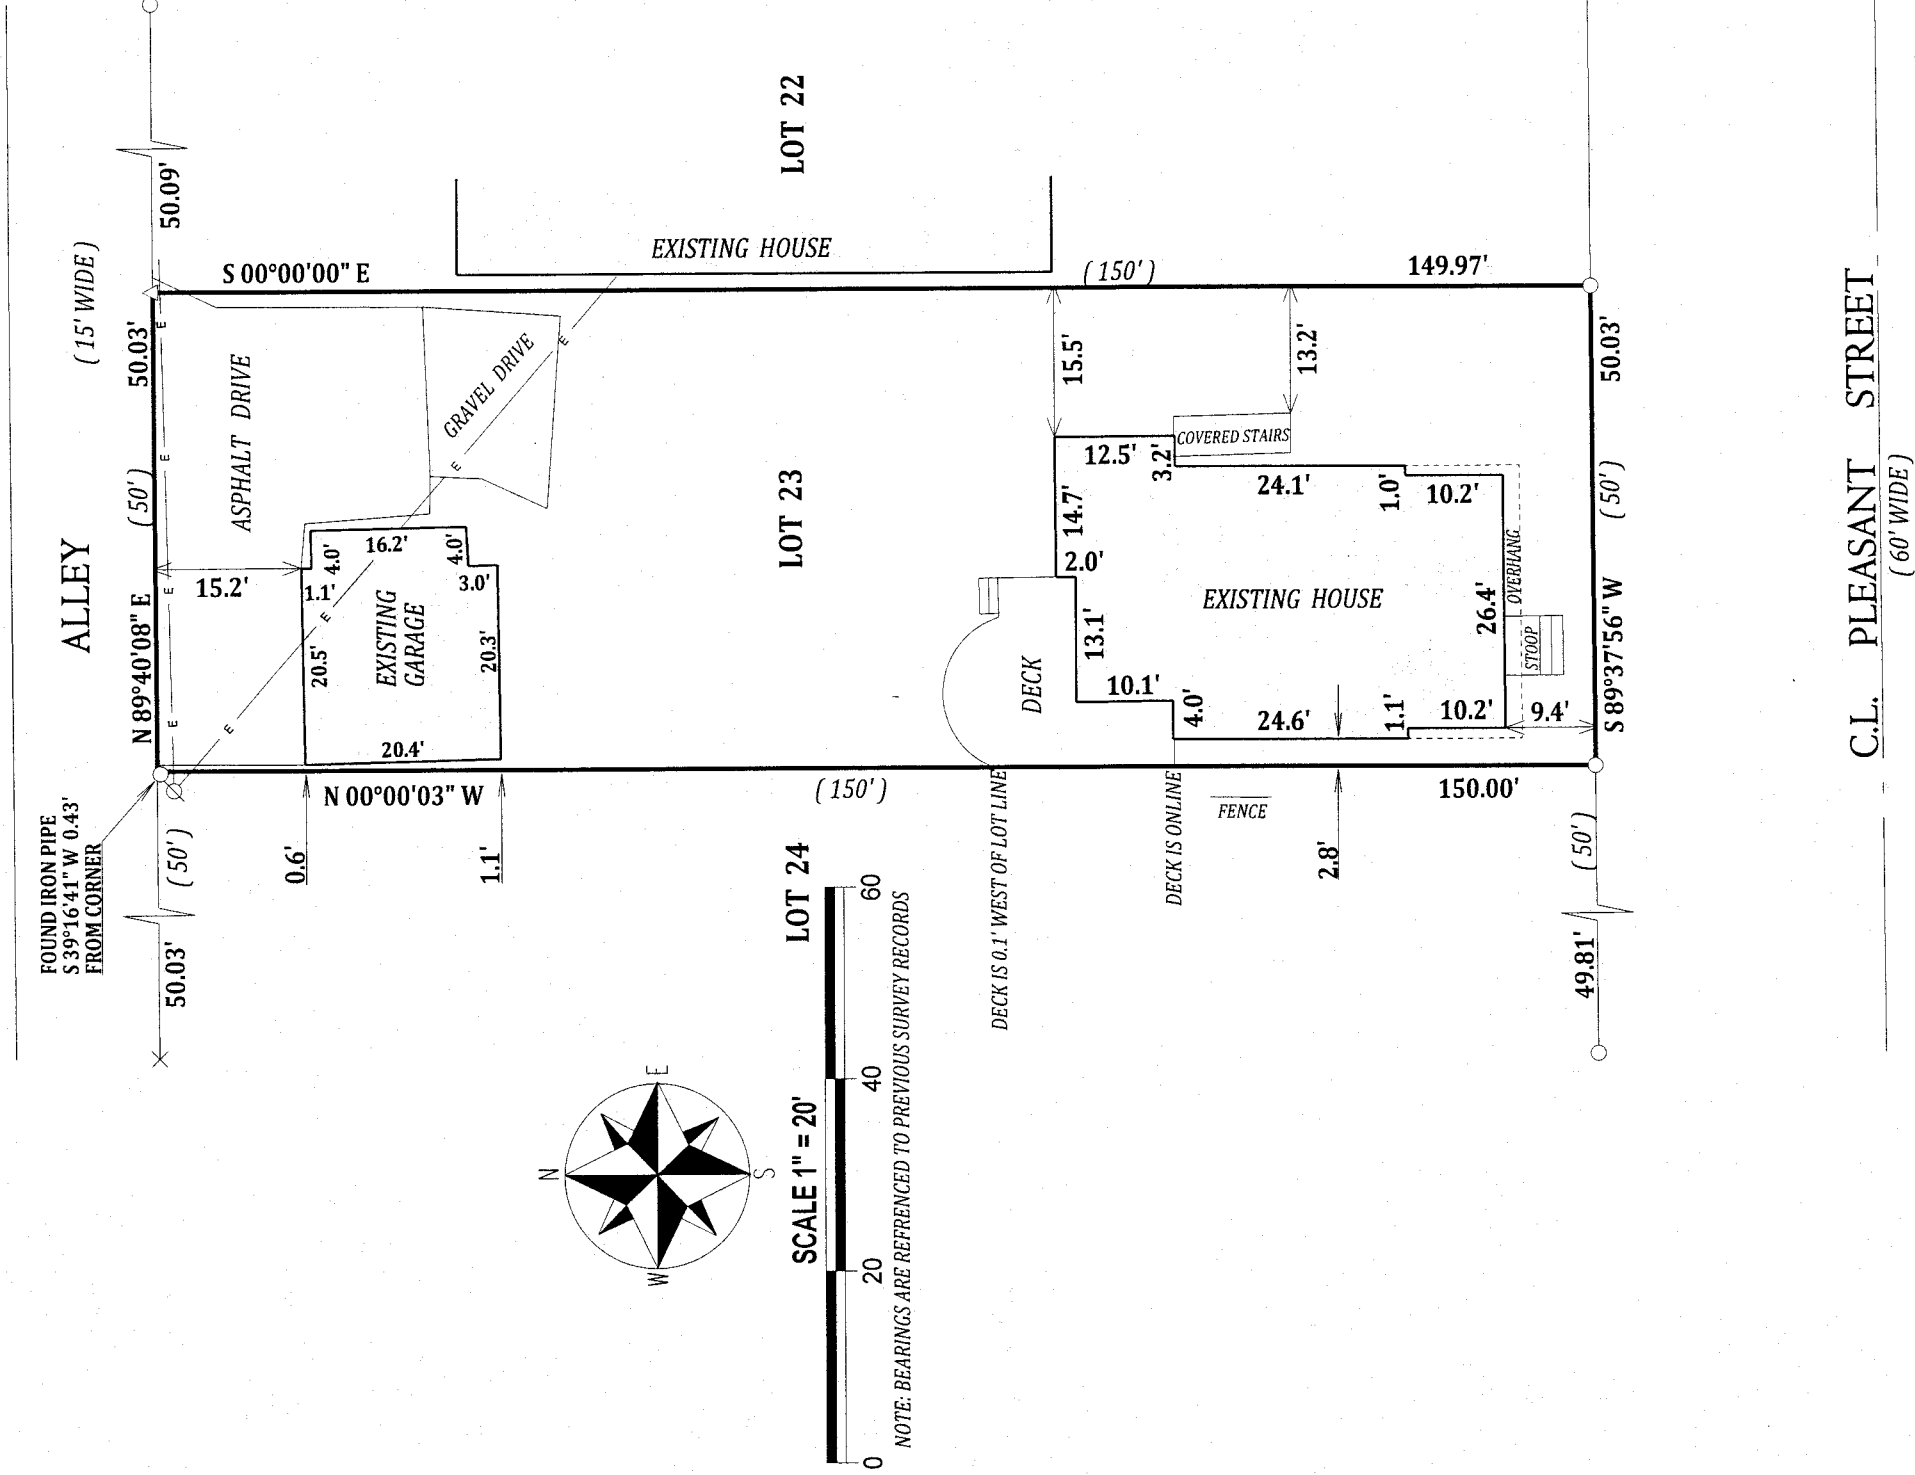


LEGEND

- FOUND IRON PIPE
- × FOUND CUT CROSS
- △ FOUND P.K. NAIL
- ∅ UTILITY POLE
- e— OVER HEAD WIRES

(XX) RECORDED AS


TAX ID # ZCL00022

JOB # 13-166

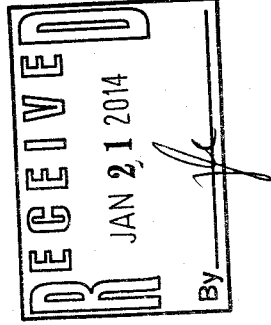

I have surveyed the above-described property and the above map is a true representation thereof and shows the size and location of the property, its exterior boundaries, the location and dimensions of all structures thereon, fences apparent easements and roadways and visible encroachments, if any.

This survey is made for the exclusive use of the present owners of the property, and also those who purchase, mortgage, or insure the title thereto within one (1) year from date hereof; and as to them I warrant the accuracy of said survey map.

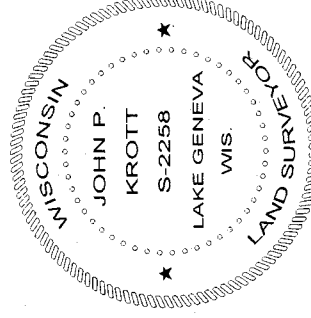

DATED THIS 4th DAY OF NOVEMBER 2013

John P. Krott

JOHN P. KROTT S-2258
WISCONSIN REGISTERED LAND SURVEYOR
(NOTE: THIS IS NOT A CERTIFIED COPY
UNLESS SIGNED IN RED INK)

ZCL -22 007-3008