

PREPARED FOR
LOWELL KENDALL
KEEFE REAL ESTATE
751 GENEVA PARKWAY
LAKE GENEVA WI. 53147



PLAT OF SURVEY OF

LOT 2 BLOCK 24, IN THE CITY OF LAKE GENEVA (FORMERLY VILLAGE OF LAKE GENEVA), WALWORTH COUNTY, WISCONSIN. ACCORDING TO THE PLAT OF RECORD.

KROTT SURVEYING INC.
(262) 248-3697
N 3705 WILLOW BEND LANE
LAKE GENEVA WI. 53147

C.L. GENEVA STREET

(80' WIDE)

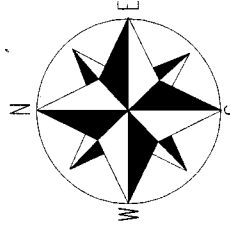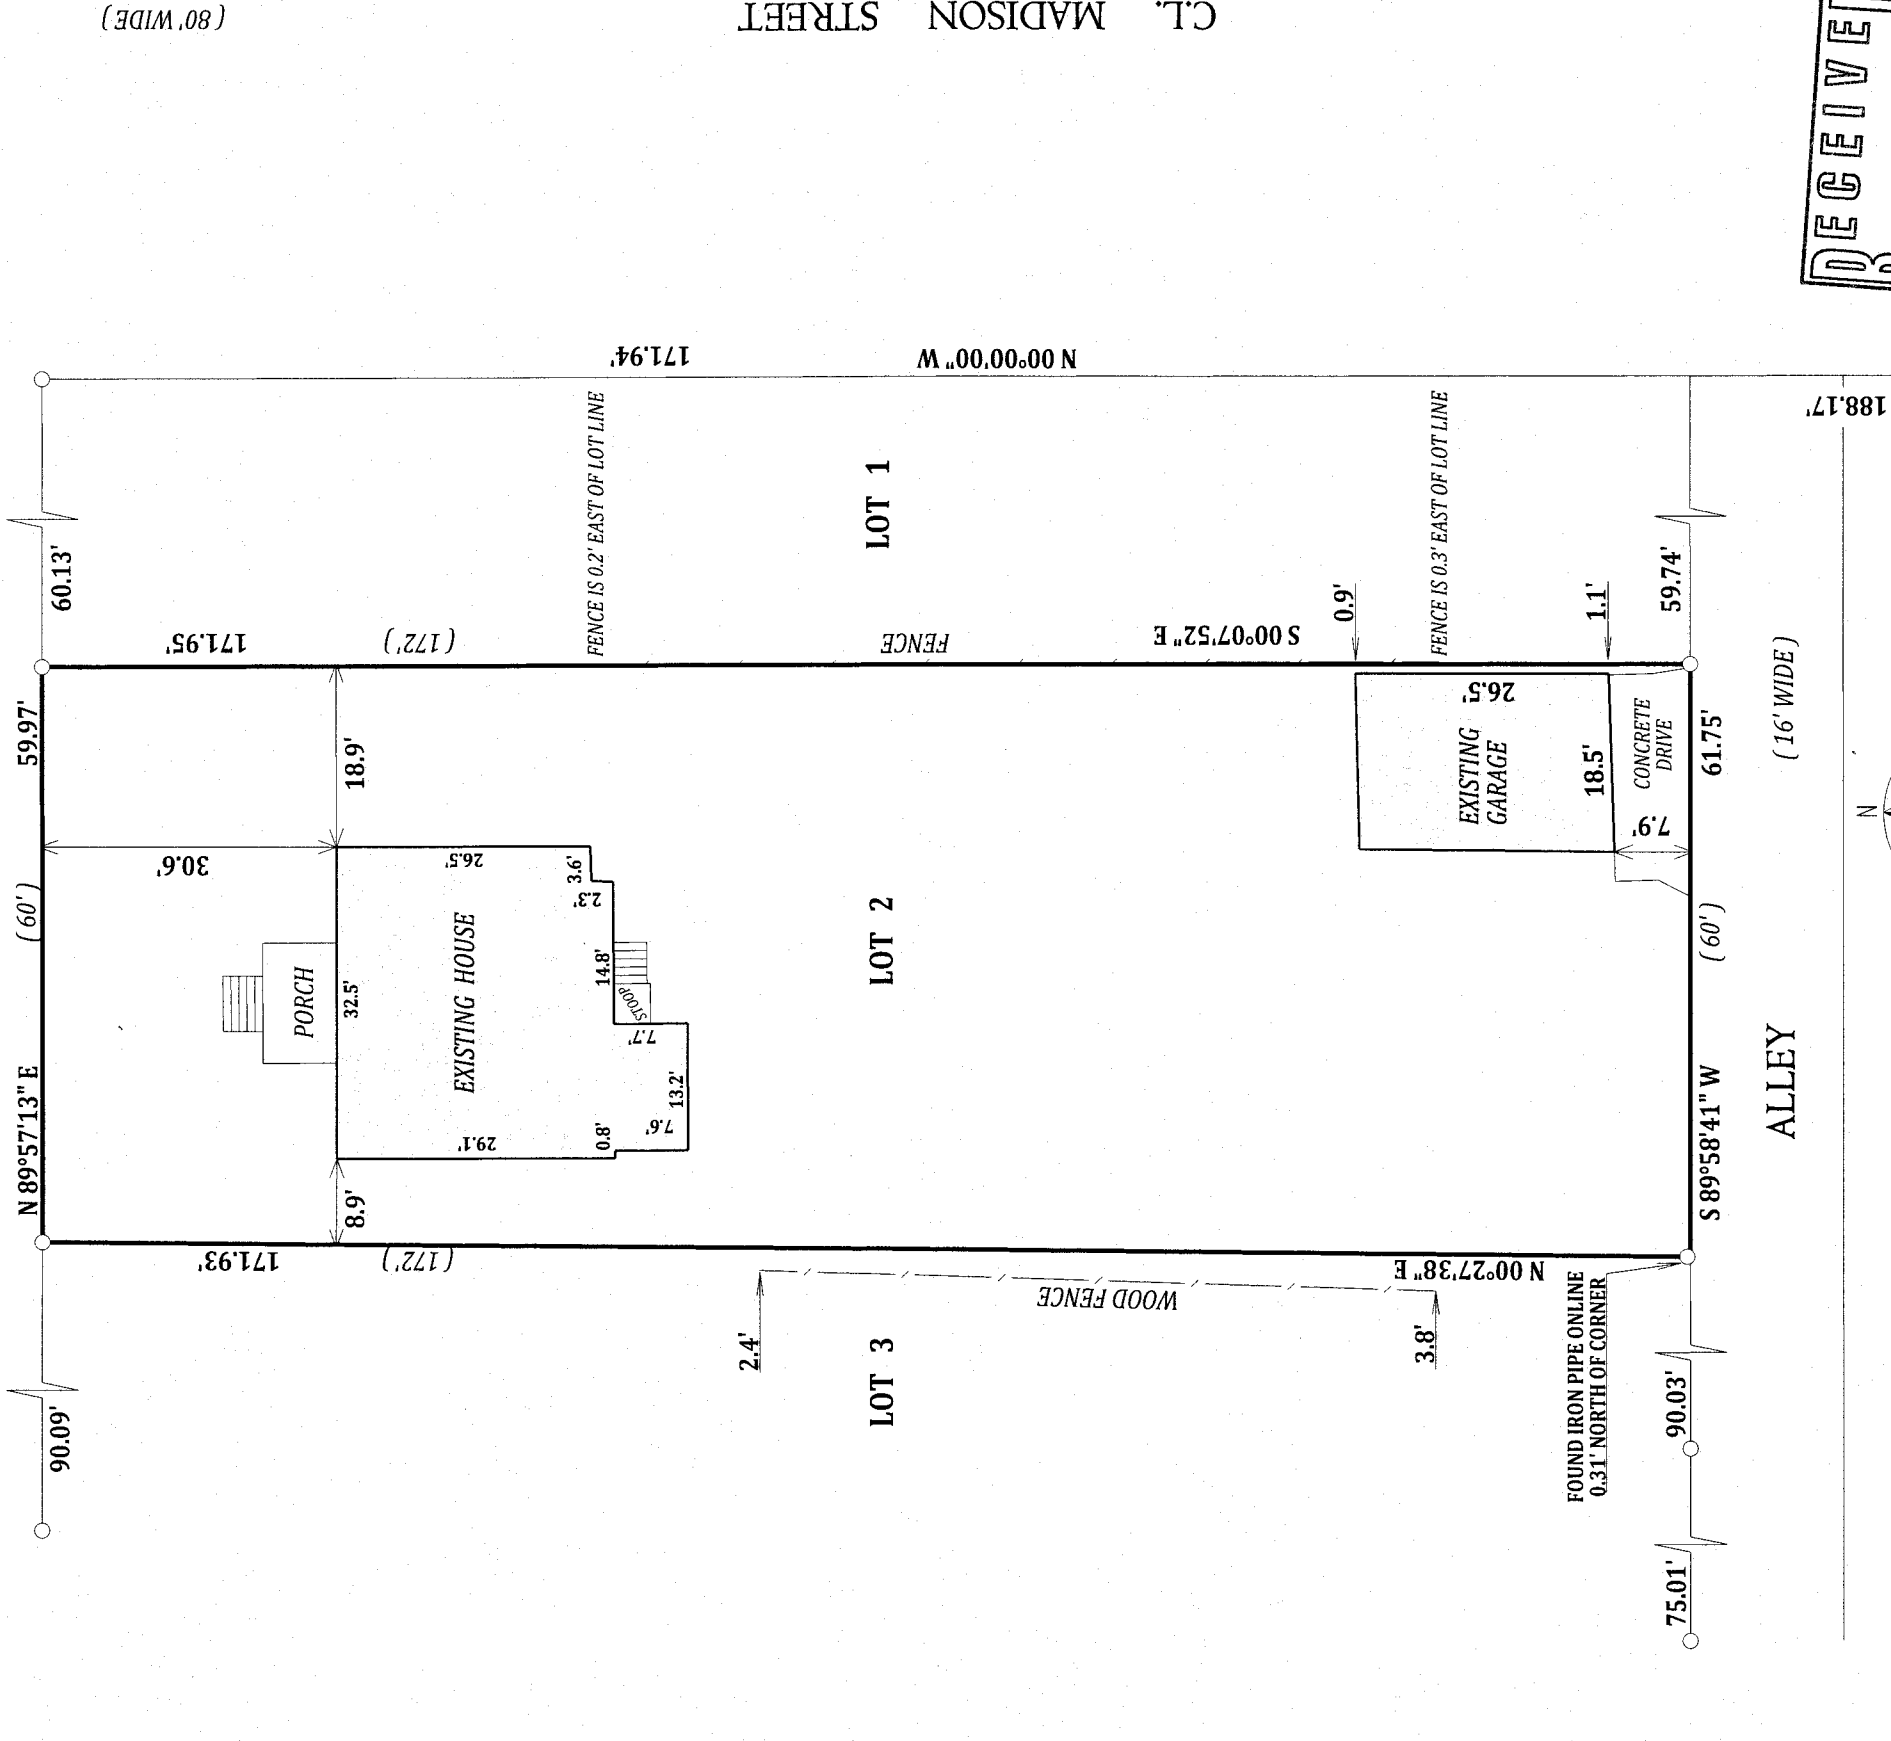

NOTE: BEARINGS ARE REFERENCED TO PREVIOUS SURVEY RECORDS

I have surveyed the above-described property and the above map is a true representation thereof and shows the size and location of the property, its exterior boundaries, the location and dimensions of all structures thereon, fences apparent easements and roadways and visible encroachments, if any.


LEGEND

○ FOUND IRON PIPE

(XX) RECORDED AS

TAX ID # ZOP000225

JOB # 13-181

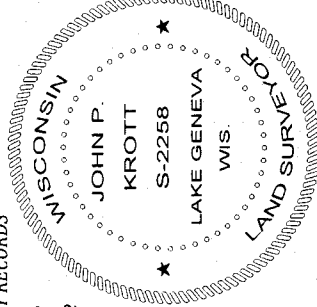

DATED THIS 3rd DAY OF DECEMBER 2013

JOHN P. KROTT S-2258
WISCONSIN REGISTERED LAND SURVEYOR
(NOTE: THIS IS NOT A CERTIFIED COPY
UNLESS SIGNED IN RED INK)

ZOP -225 007-3010