


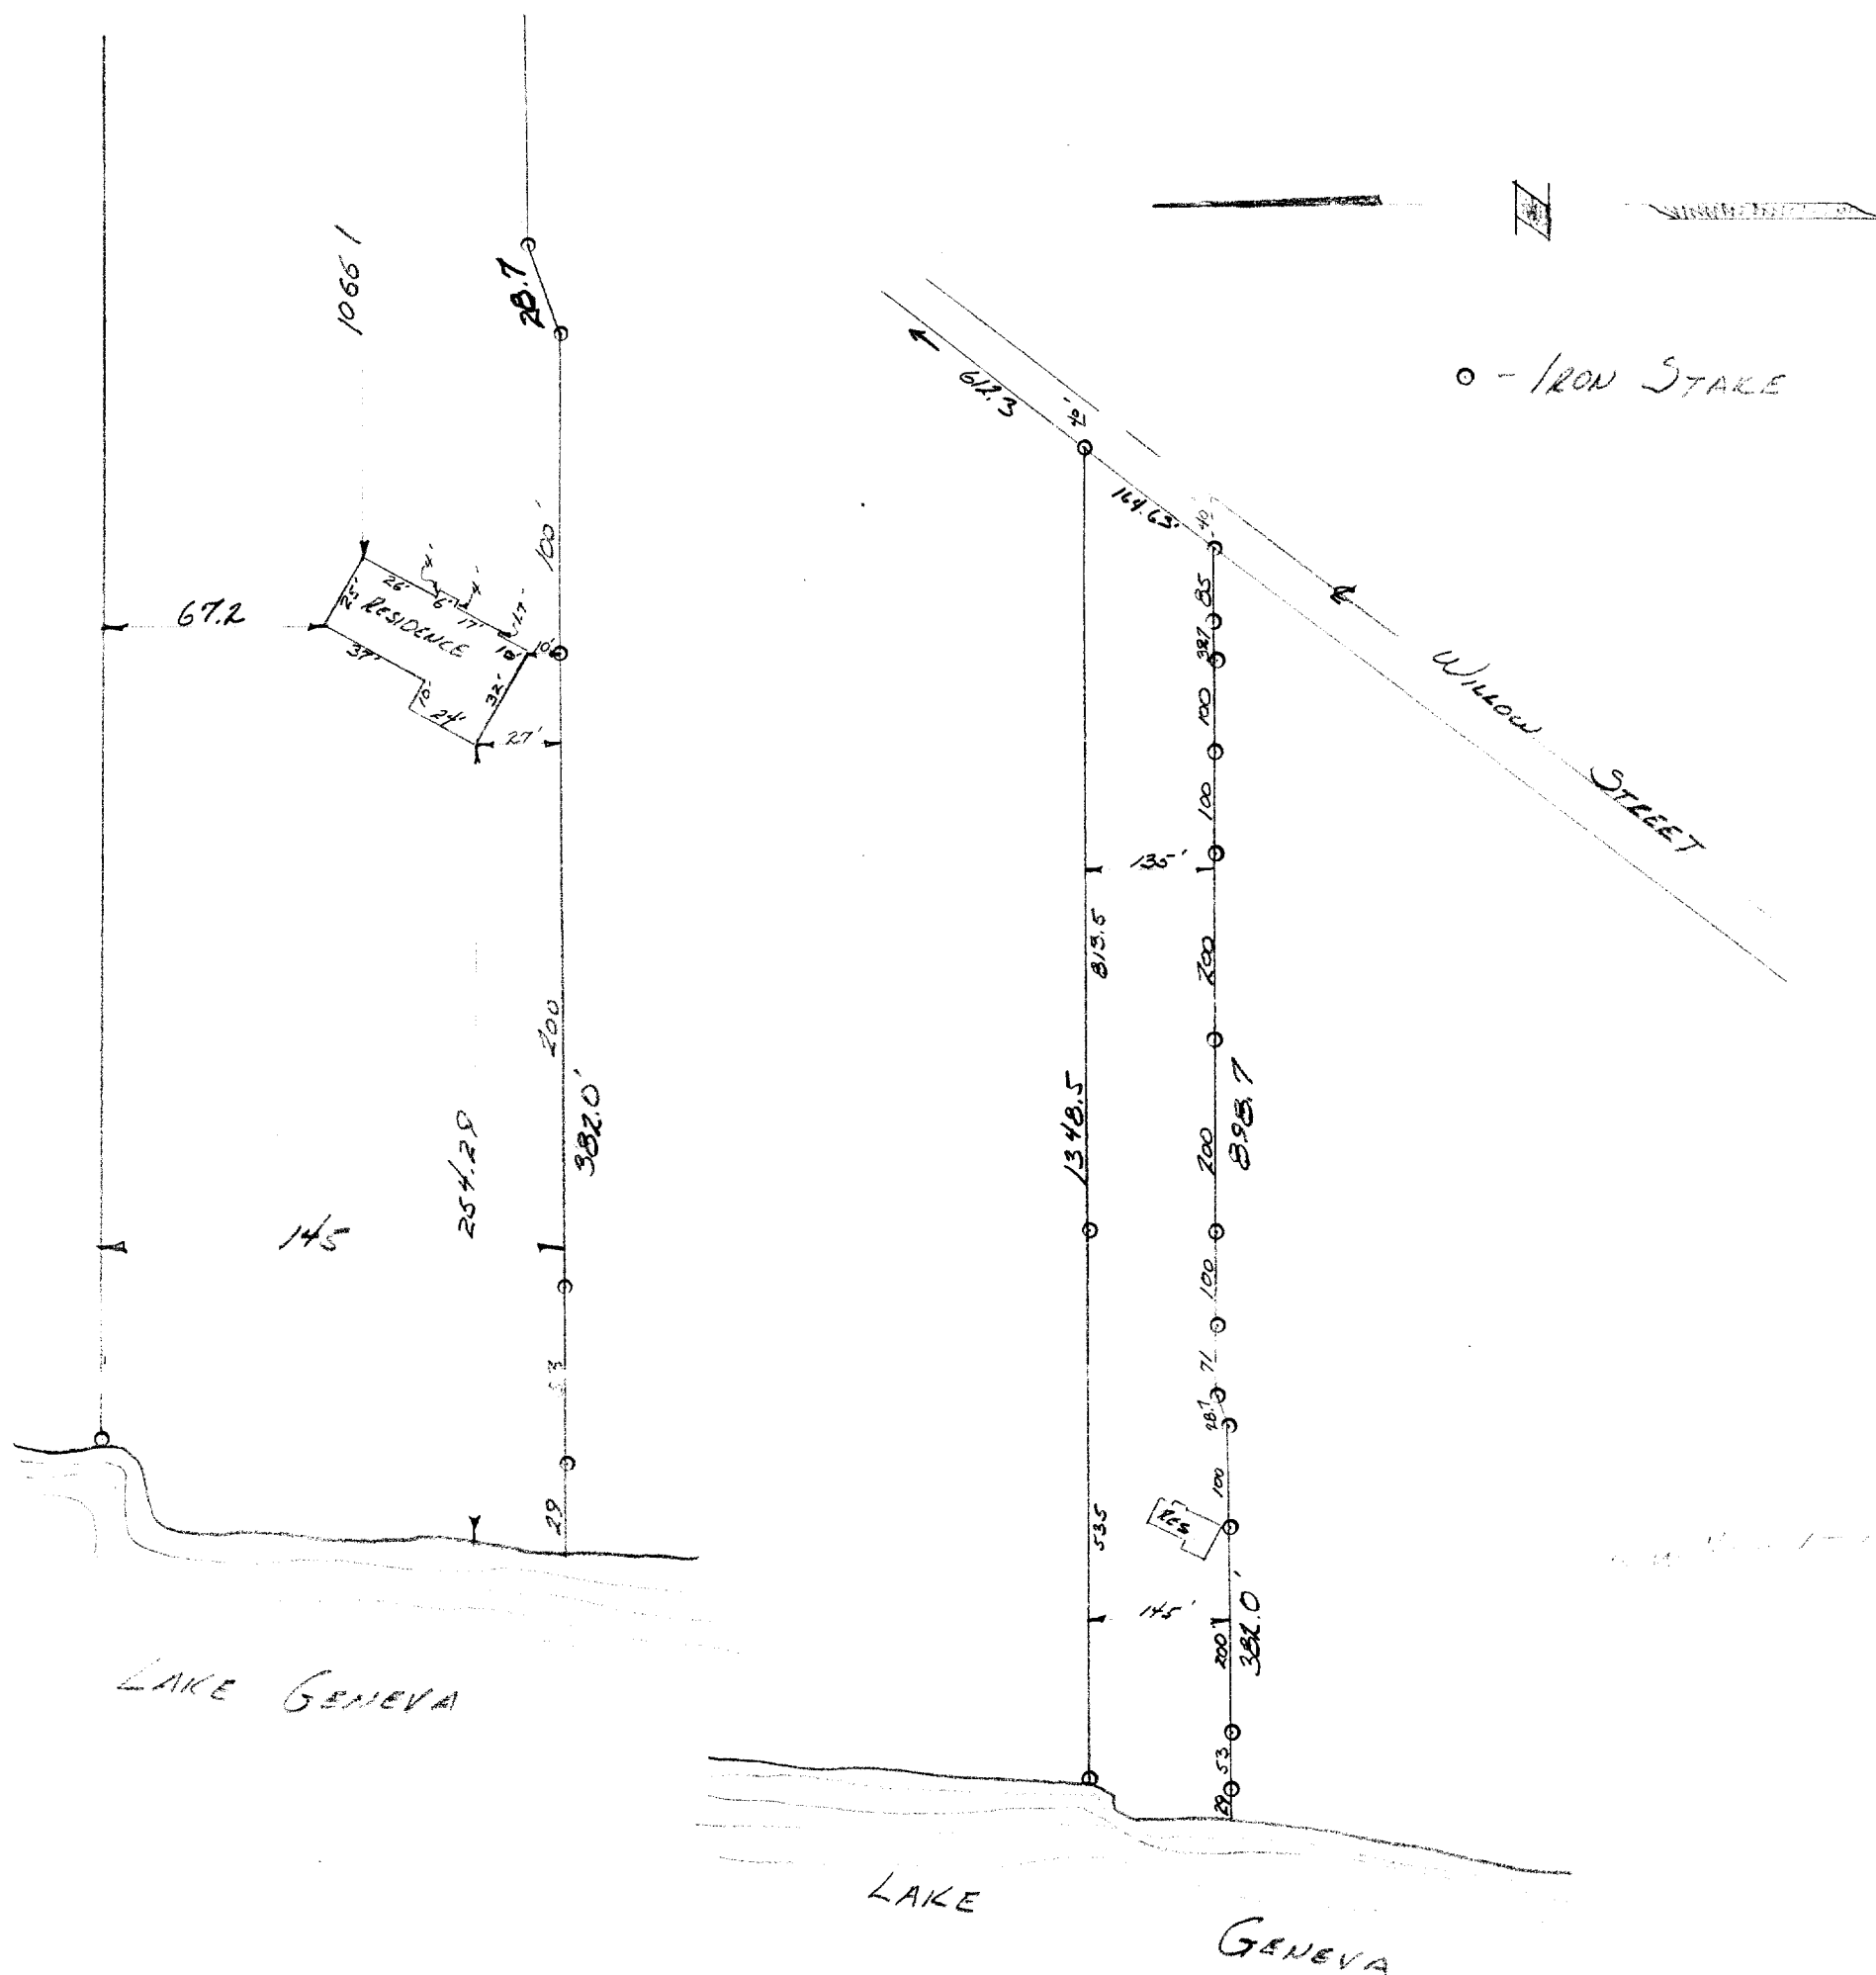

DESCRIPTION: Commencing at an iron stake in the Westerly line of Willow Street, which is 612.3 feet S. $36^{\circ} 30'$ W. of the Northeast corner of Greenridge Downs Subdivision, thence S. $36^{\circ} 30'$ W. 164.63 feet to an iron stake, thence West parallel to the South line of the subdivision 898.7 feet to an iron stake, thence S. $69^{\circ}-37'$ W. 28.7 feet to an iron stake, thence West parallel to the South line of the Subdivision 332.0 feet to the low water-line of the lake, thence along the shoreline of the lake to a concrete monument this point being 145.0 feet North of the South line of the parcel, thence East along a line which is parallel to the South line of the subdivision 1348.5 feet to the place of beginning.

CERTIFICATE: I hereby certify that I have on this the 24th day of March surveyed the above property and that the above description and drawing are correct, and the residence shown hereon is shown as it exists on the lot.

SIGNED AND SEALED ON THIS THE 26TH DAY OF MARCH, 1956.

James F. Biagi
Registered Land Surveyor.
Elkhorn, Wisconsin.