

Mark L. Miritz

Wisconsin Registered Land Surveyor S-2582

**N9330 Knuteson Drive
Whitewater, WI 53190
Phone: (262) 495-3284**

**MARKMIRITZ@
LAND-MARKSURVEYING.COM**

PLAT OF SURVEY


ORDERED BY: HOME DESIGN MFG. CORP.

P.O. BOX 527

FONTANA, WI 53125

SITE ADDRESS: 1115 GENEVA ST., LAKE GENEVA, WI 53147

THE LOCATION OF A GARAGE "AS BUILT" ON LOT 10, BLOCK 20, OF THE ORIGINAL PLAT OF THE VILLAGE (NOW CITY) OF LAKE GENEVA, WALWORTH COUNTY, WISCONSIN.

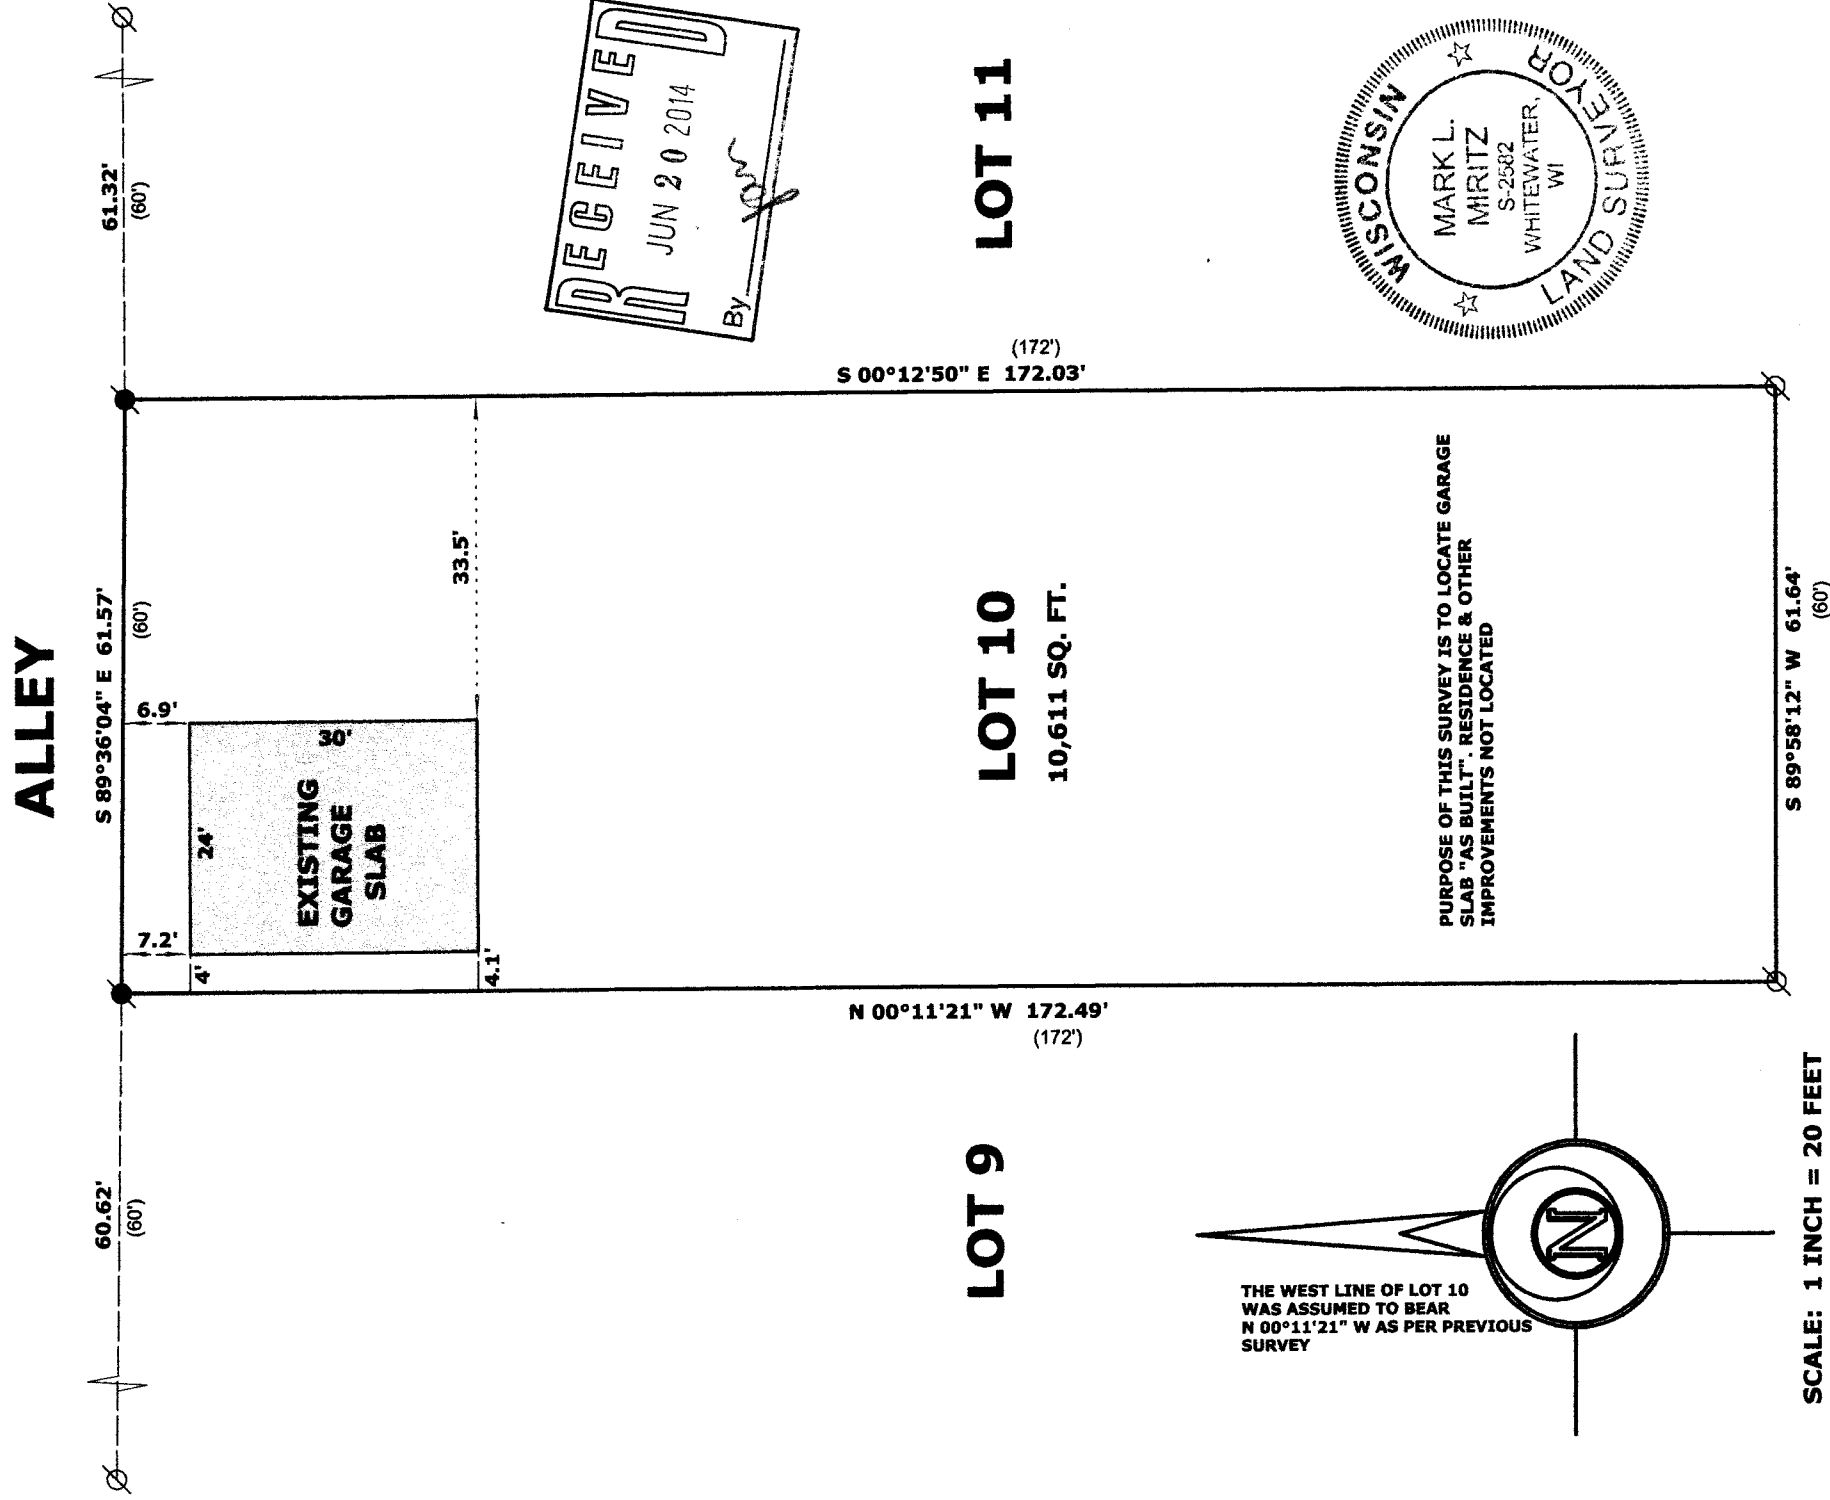

"I hereby certify that the above described property has been surveyed by me or under my direction in full compliance with the owner's/agent's instructions and Chapter A-E-7 of the Wisconsin Administrative Code "Minimum Standards for property surveys"; that the above map is correct to the best of my knowledge and belief."

Mark L. Mintz
MADK: MIDT7

**MARK L. MIRITZ
WISCONSIN REGISTERED
LAND SURVEYOR S-2582**

DATE: JUNE 4, 2014 JOB NO. 14.411

GENEVA STREET

LEGEND

FOUND IRON PIPE 1 1/4"

FOUND IRON ROD 1/2"

RECORDED AS DIMENSION

 (xx)

20P-194

007-3033