





LAND-MARK SURVEYING
Mark L. Miritz
Wisconsin Registered Land Surveyor S-2582

N9330 Knuteson Drive
Whitewater, WI 53190
Phone: (262) 495-3284
MARKMIRITZ@
LAND-MARKSURVEYING.COM

PLAT OF SURVEY

UNIT 13, MAYTAG ESTATES CONDOMINIUM, PART OF THE SOUTHWEST 1/4
OF THE NORTHEAST 1/4 AND PART OF THE SOUTHEAST 1/4 OF THE NORTH-
WEST 1/4 OF SECTION 1, TOWN 1 NORTH, RANGE 17 EAST, CITY OF LAKE
GENEVA, WALWORTH COUNTY, WISCONSIN.

ORDERED BY: BASSO BUILDERS, INC.
405 SKYLINE DRIVE
LAKE GENEVA, WI 53147

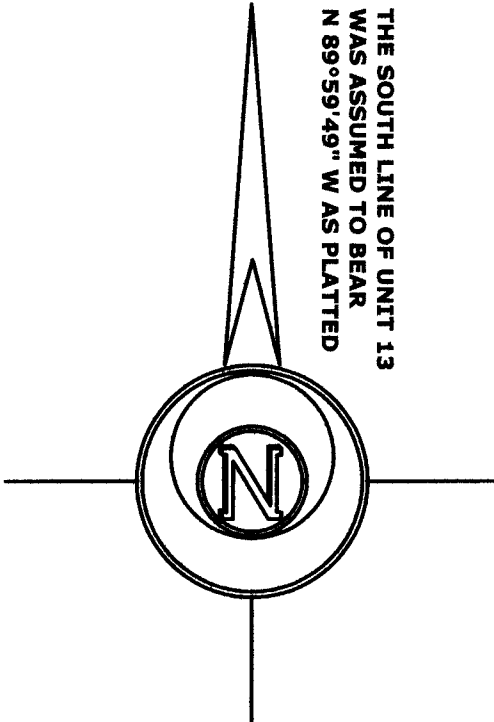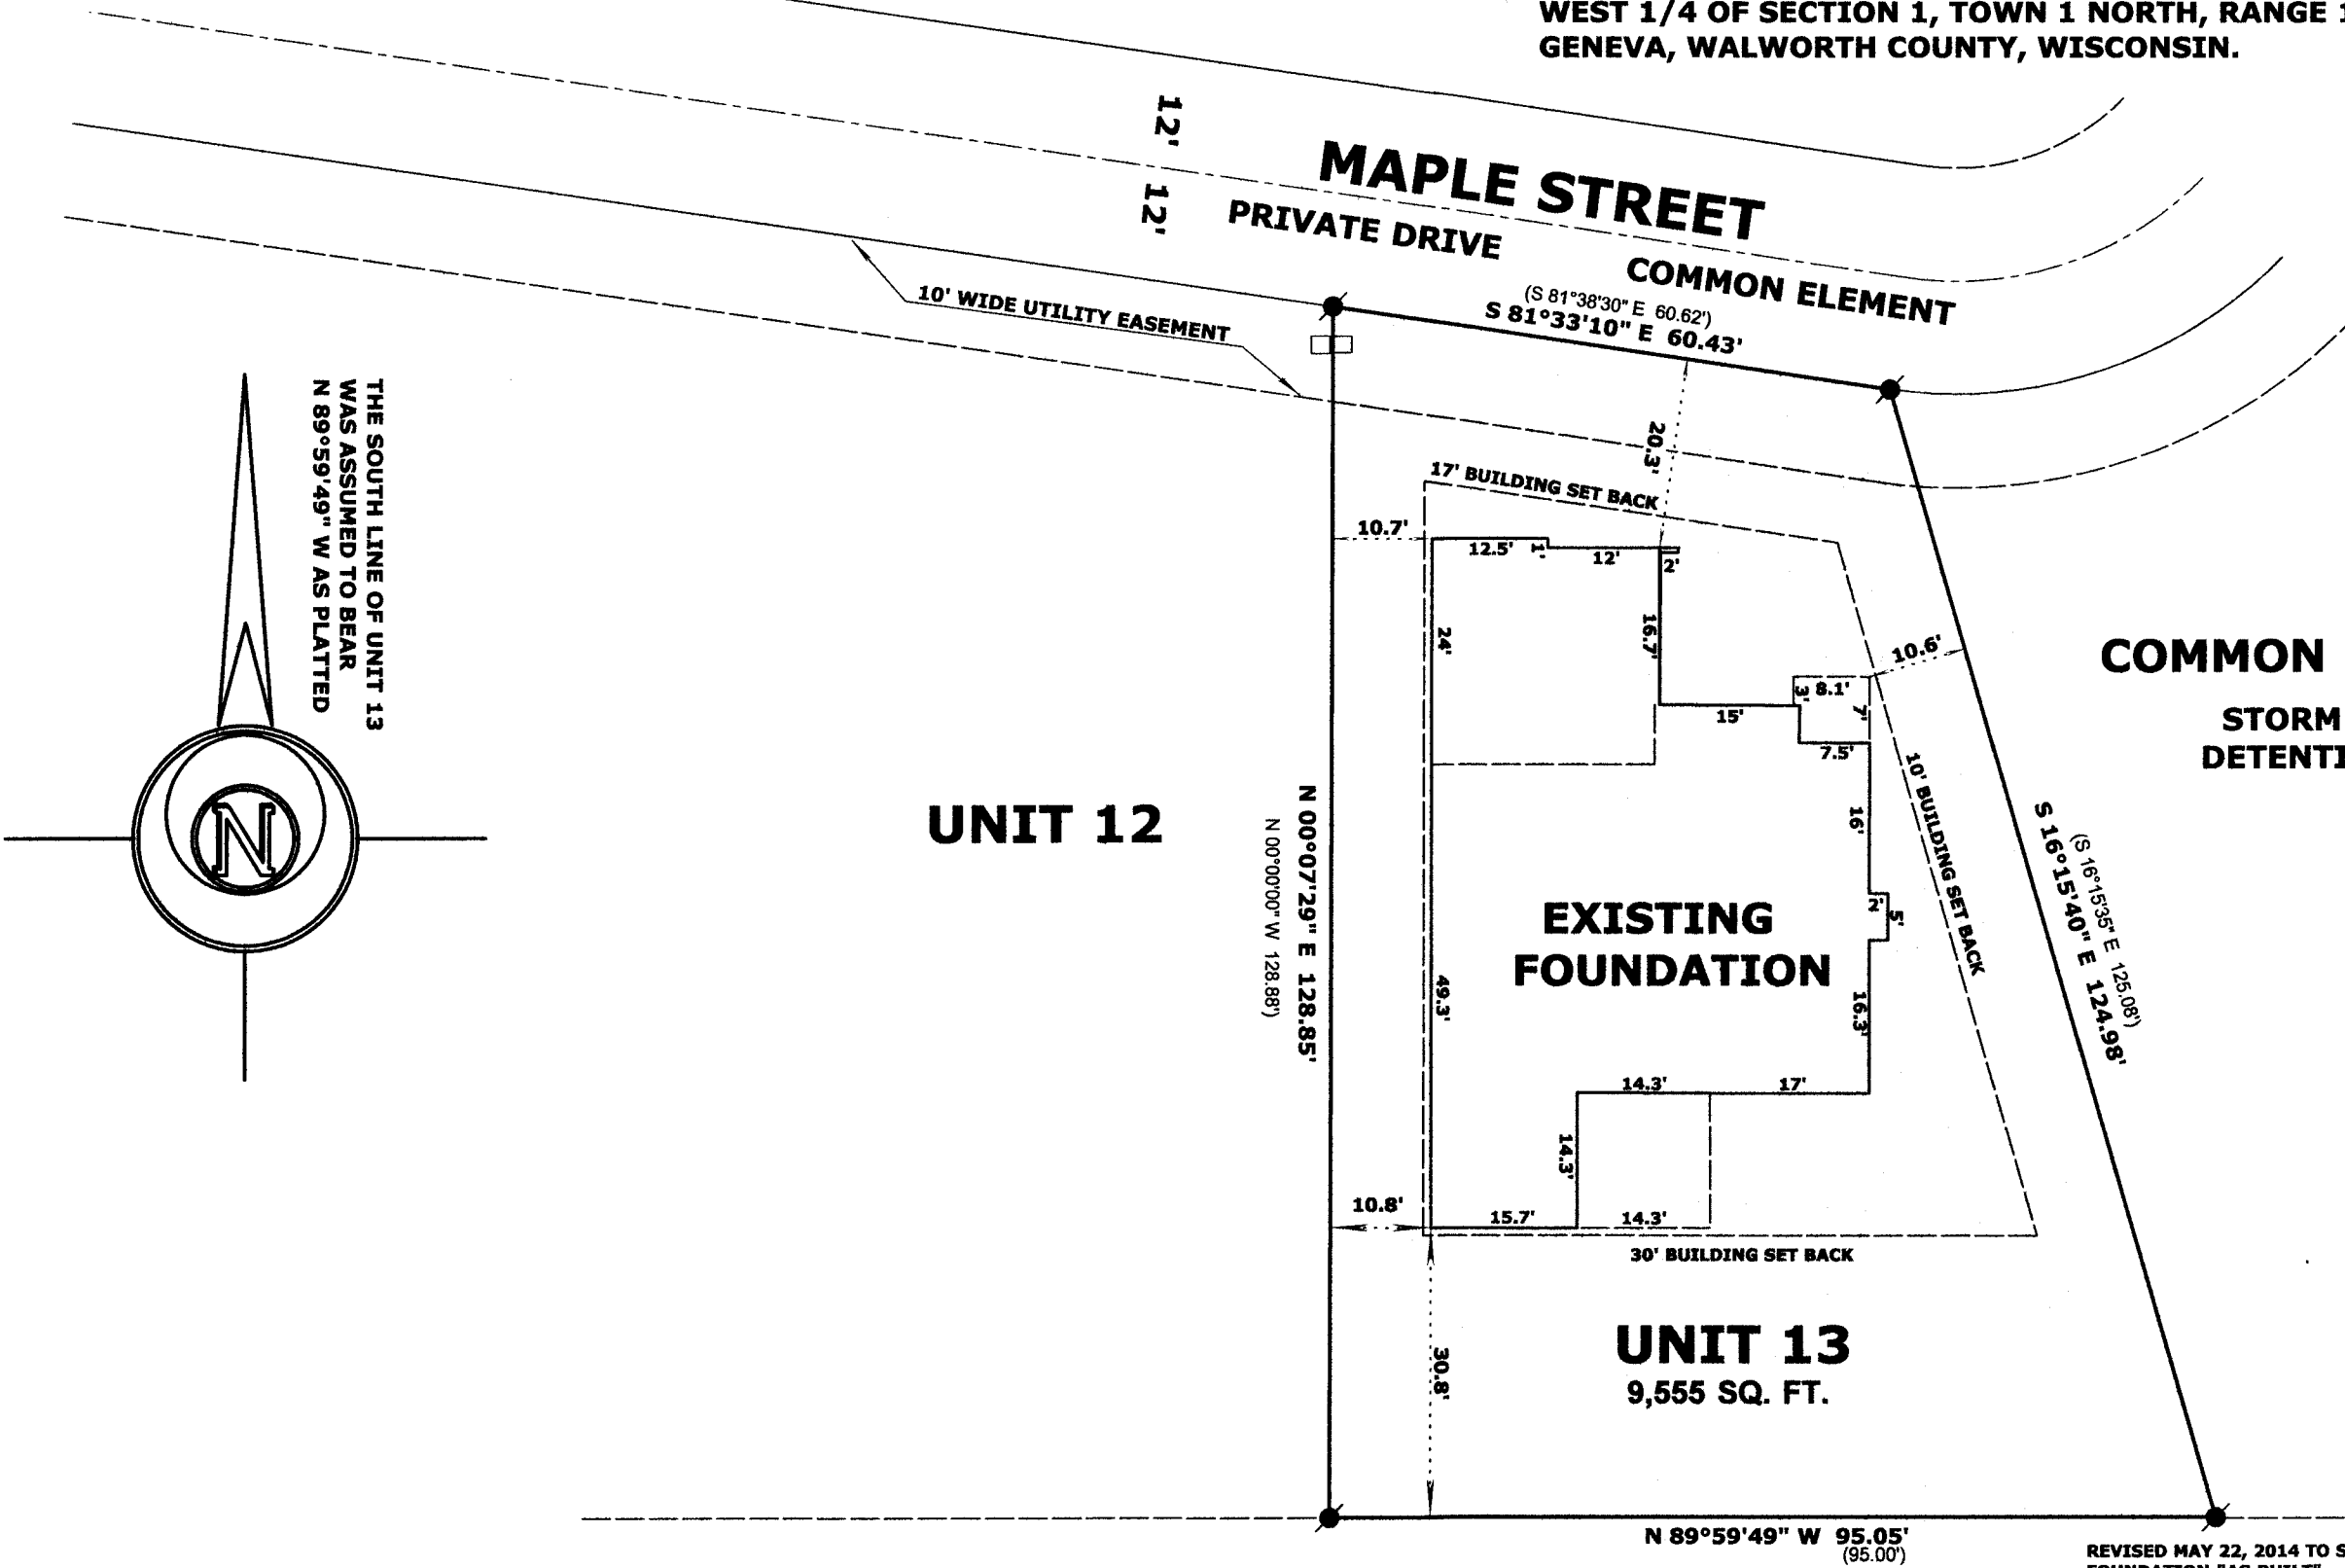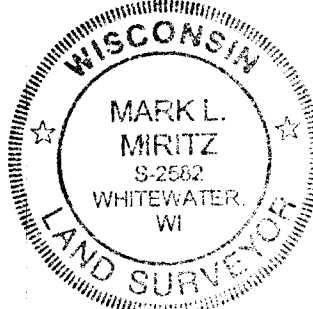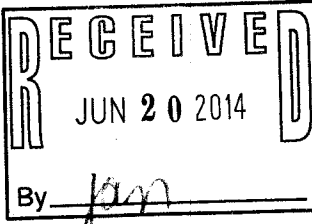

COMMON ELEMENT
STORM WATER
DETENTION AREA

- LEGEND**
- FOUND IRON ROD 3/4"
 - (x x) RECORDED AS DIMENSION

SCALE: 1 INCH = 20 FEET

"I hereby certify that the above described property has been surveyed by me or under my direction and that the above map is a true representation thereof and shows the size and location of the property, its exterior boundaries, the location of all visible structures and dimensions of all principal buildings thereon, boundary fences, apparent easements, roadways and visible encroachments, if any."
"This survey is made for the use of the present owners of the property, and also those who purchase, mortgage, or guarantee the title thereto within one year from date hereof."

Mark L. Miritz
MARK L. MIRITZ
WISCONSIN REGISTERED
LAND SURVEYOR S-2582

DATE: MARCH 5, 2014 JOB NO. 14.206

REVISED MAY 22, 2014 TO SHOW
FOUNDATION "AS BUILT"

2 MAY -13 007-3036