



PREPARED FOR
DORTHY GERBER
SHOREWEST REALTY
LAKE GENEVA WI

PLAT OF SURVEY

- OF -

LOT 7, BLOCK 12, LAKE GENEVA MANOR SUBDIVISION,
CITY OF LAKE GENEVA, WALWORTH COUNTY, WISCONSIN.

PATHFINDER SURVEYING INC.
(formerly)
J.K. SURVEYING INC.
P.O. BOX 322
LAKE GENEVA, WI 53147
WWW.PATHFINDERSURVEYING.NET
262-248-8303

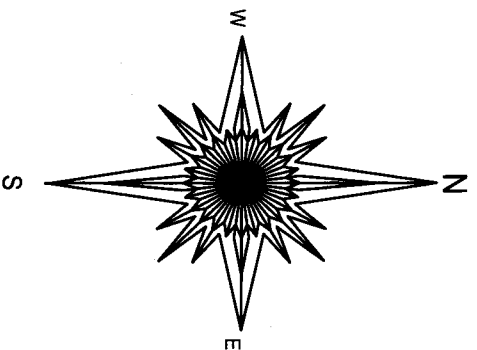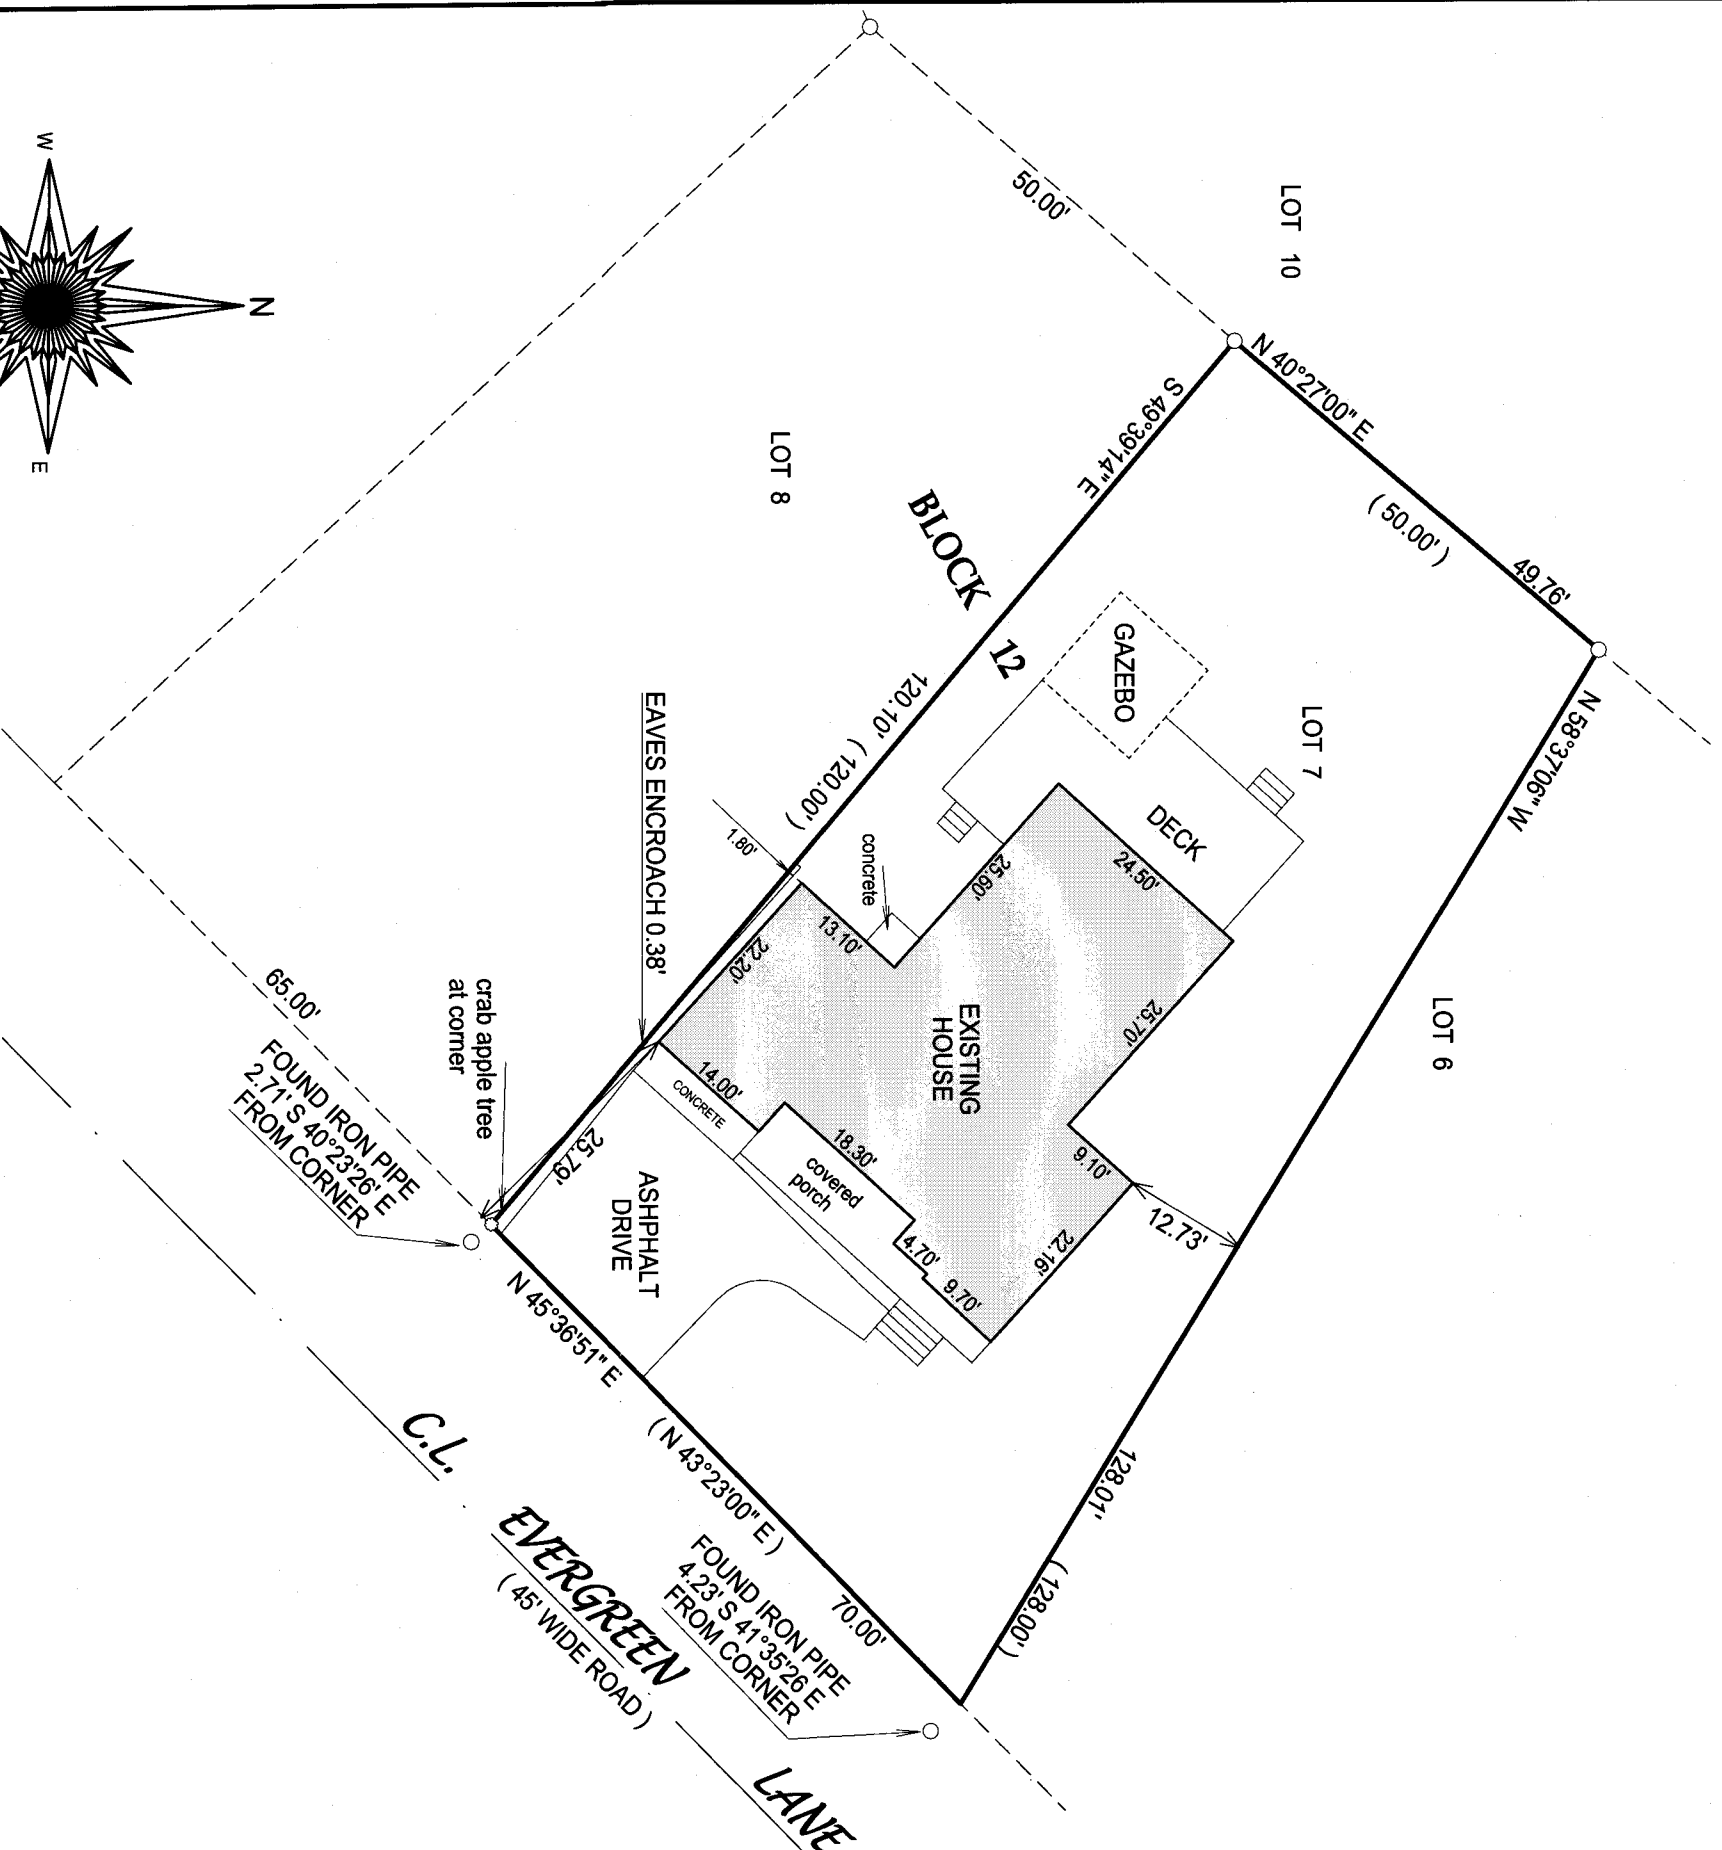

- () = recorded as
- = found iron bar
- = found iron pipe
- = set iron pipe
- = set iron bar

SCALE 1" = 20'

JOB # 02-457 / 14-50

TAX ID # ZLM00009




NOTE: BEARINGS REFERENCED FROM PREVIOUS SURVEY OF RECORD


"I hereby certify that I have surveyed the above described property and that the above map is a true representation thereof and shows the size and location of all visible structures, apparent easements and encroachments if any."

This survey is made for the present owners of the property, and those who purchase, mortgage, or guarantee the title thereto, within one year from the date hereof.

DATED THIS 8TH DAY OF APRIL, 2014.

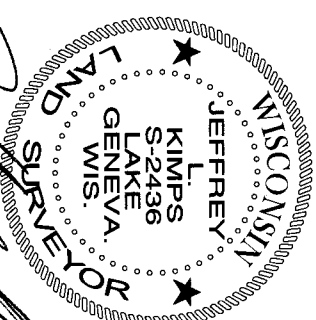

JEFFREY L. KIMPS S - 2436
Wisconsin Registered Land Surveyor
(original if signed in red)

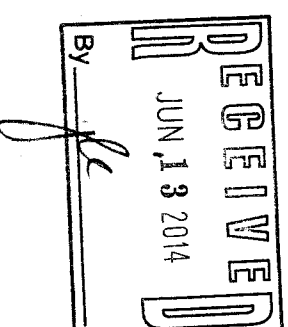

ZLM-9 007-3038