

PLAT OF SURVEY

PATHFINDER SURVEYING INC.


J.K. SURVEYING INC.

LAKE GENEVA, WI. 53147

262-248-8303

262-248-8303

262-248-8303

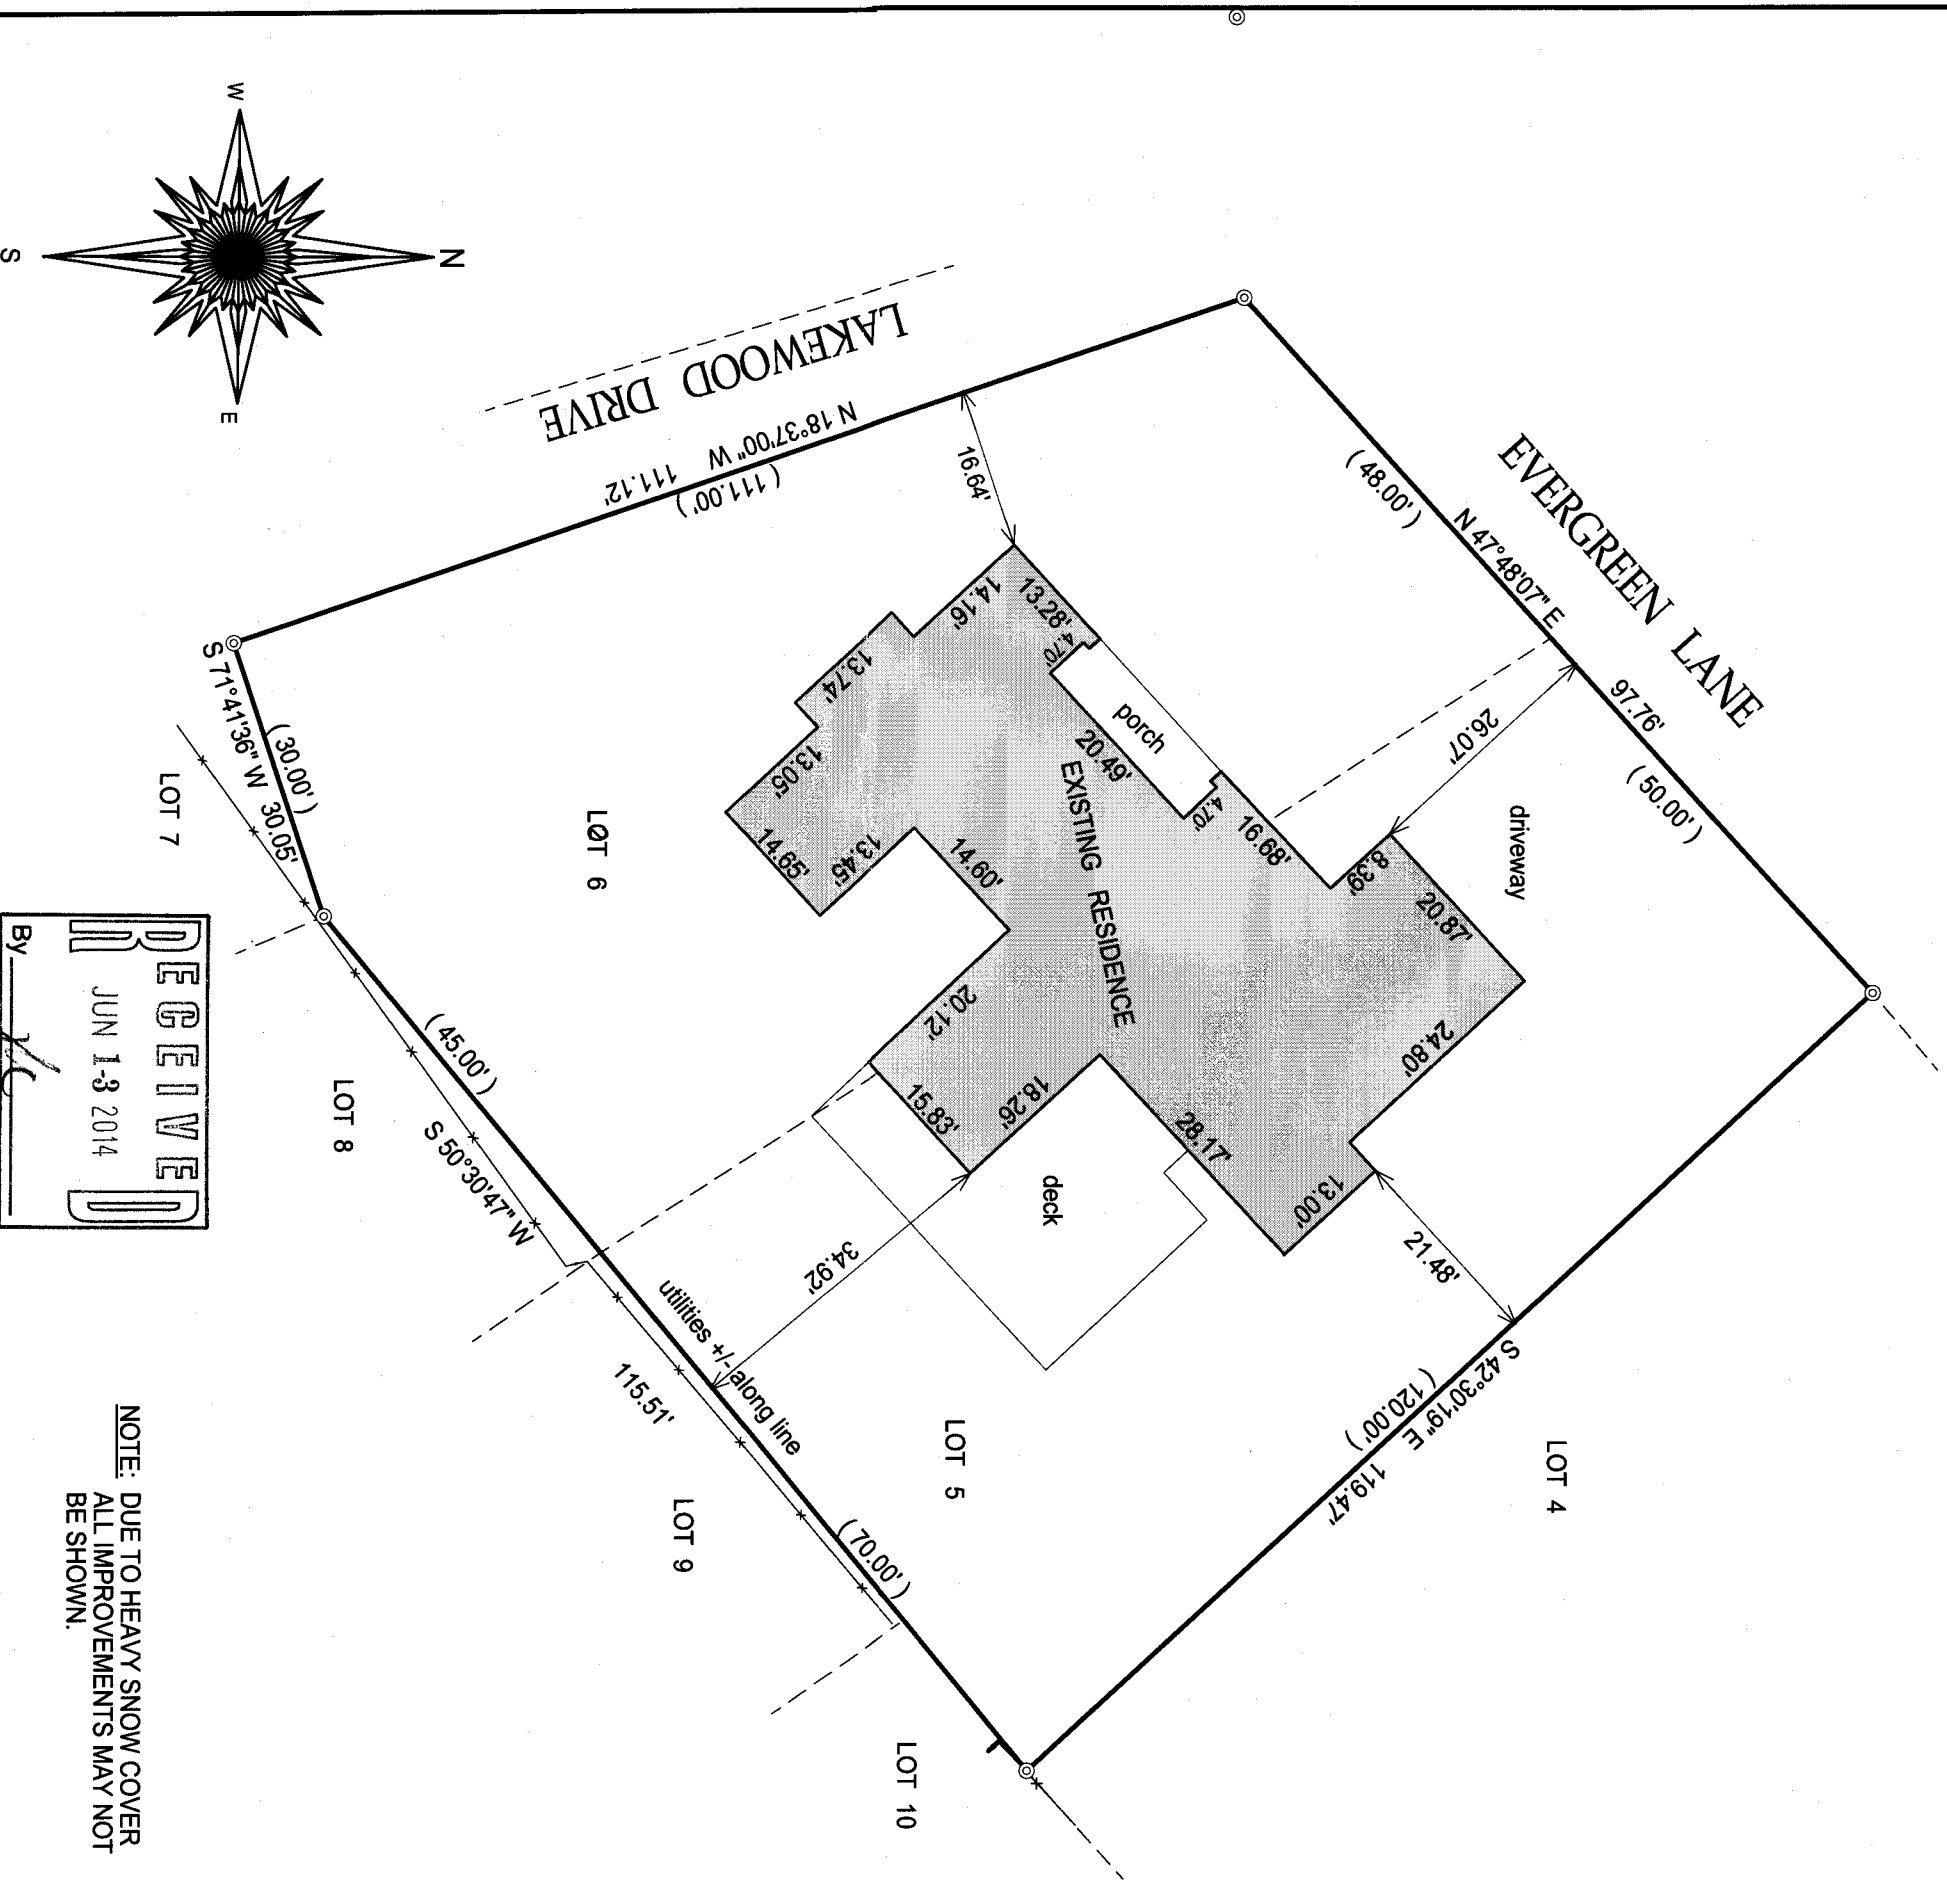

NOTE: DUE TO HEAVY SNOW COVER, ALL IMPROVEMENTS MAY NOT BE SHOWN.

☐ = found iron bar

○ = found iron pipe

● = set iron pipe

■ = set iron bar

SCALE 1" = 20'

JOB # 13-251

TAX ID # ZLM 00017

[illegible]

BASIS OF BEARING OF THIS PLAT: THE EAST LINE OF LAKEWOOD DRIVE WAS ASSUMED TO BEAR N 18°37'W AS SHOWN ON THE RECORD PLAT OF LAKE GENEVA MANOR.

I hereby certify that I have surveyed the above-described property and the above map is a true representation thereof and shows the size and location of the property, its exterior boundaries, the location and dimensions of all structures thereon, fences, apparent easements and roadways and visible encroachments if any.

This survey is made for the present owners of the property, and those who purchase, mortgage, or guarantee the title thereto, within one year from the date hereof.

DATED THIS 23rd day of December, 2013.

JEFFREY L KIMPS S - 2436
Wisconsin Registered Land Surveyor
(original if signed in red)