


Lot 18, Columbian Subdivision March 18, 1914

Begin at a point 1' North and 1' East of N.E. corner of Pleasant and 9th Sts. 250' to the S.W. corner of lot 18 (Set line of cement walk east intersects south line of alley at alley 300' to N.W. corner of lot 18. measured 150' N. from E line of lot 18 was measured at to be 4' from wall of her house W. P. Hagan told her that her house

Mar. 19, 1914

By request of John Allen measured Mrs. Davis's lot N.E. corner Geneva & Sage Sts.

R. R. Plat makes N.B. 134' B.E. 84' C.D. 71' & D.X. 94' survey shows A.B. as occupied 150' B.E. 120' B.E. 84'

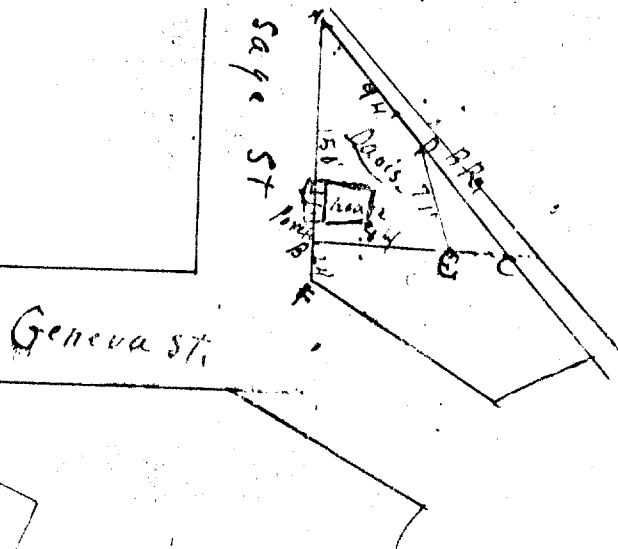

east of inner corner of cement walk corner Sts. which is the S.W. corner of lot 18. along said N. line of Pleasant (Set 1" gas pipe) thence east 50' to 1" gas pipe. At a point E. of inner side of Clover St. where same thence east along said south line of lot 18, also measured 150' north from 1" gas pipe; thence east 50' to N.E. cor. S.E. corner of lot 18. set 1" gas pipe. Mrs. McLarnie's house and thence which distance Mrs. McLarnie said was from the line

J. G. Shells, Surveyor

E. line of Sage St. passes about midway of Davis's west property

Land not occupied as shown on R. R. Plat.
B. H. L. H.

J. G. S.