

LAND-MARK SURVEYING

Mark L. Miritz

Wisconsin Registered Land Surveyor S-2582

N9330 Knuteson Drive  
Whitewater, WI 53190  
Phone: (262)495-3284  
MARKMIRITZ@  
LAND-MARKSURVEYING.COM

PLAT OF SURVEY


LOT 12 IN GARRISON GLEN SUBDIVISION, LOCATED  
IN NORTHEAST 1/4 OF SECTION 1, TOWN 1 NORTH,  
RANGE 17 EAST, CITY OF LAKE GENEVA, WALWORTH  
COUNTY, WISCONSIN.

ORDERED BY:  
IRENE A. HORODECKI  
LEGAL ASSISTANT  
OHALLORAN KOSOFF GEITNER & COOK, LLC  
EDENS CORPORATE CENTER  
650 DUNDEE ROAD, FOURTH FLOOR  
NORTHBROOK, IL 60062

GARRISON DRIVE


(60' WIDE)

LOT 3, C.S.M. NO. 4004

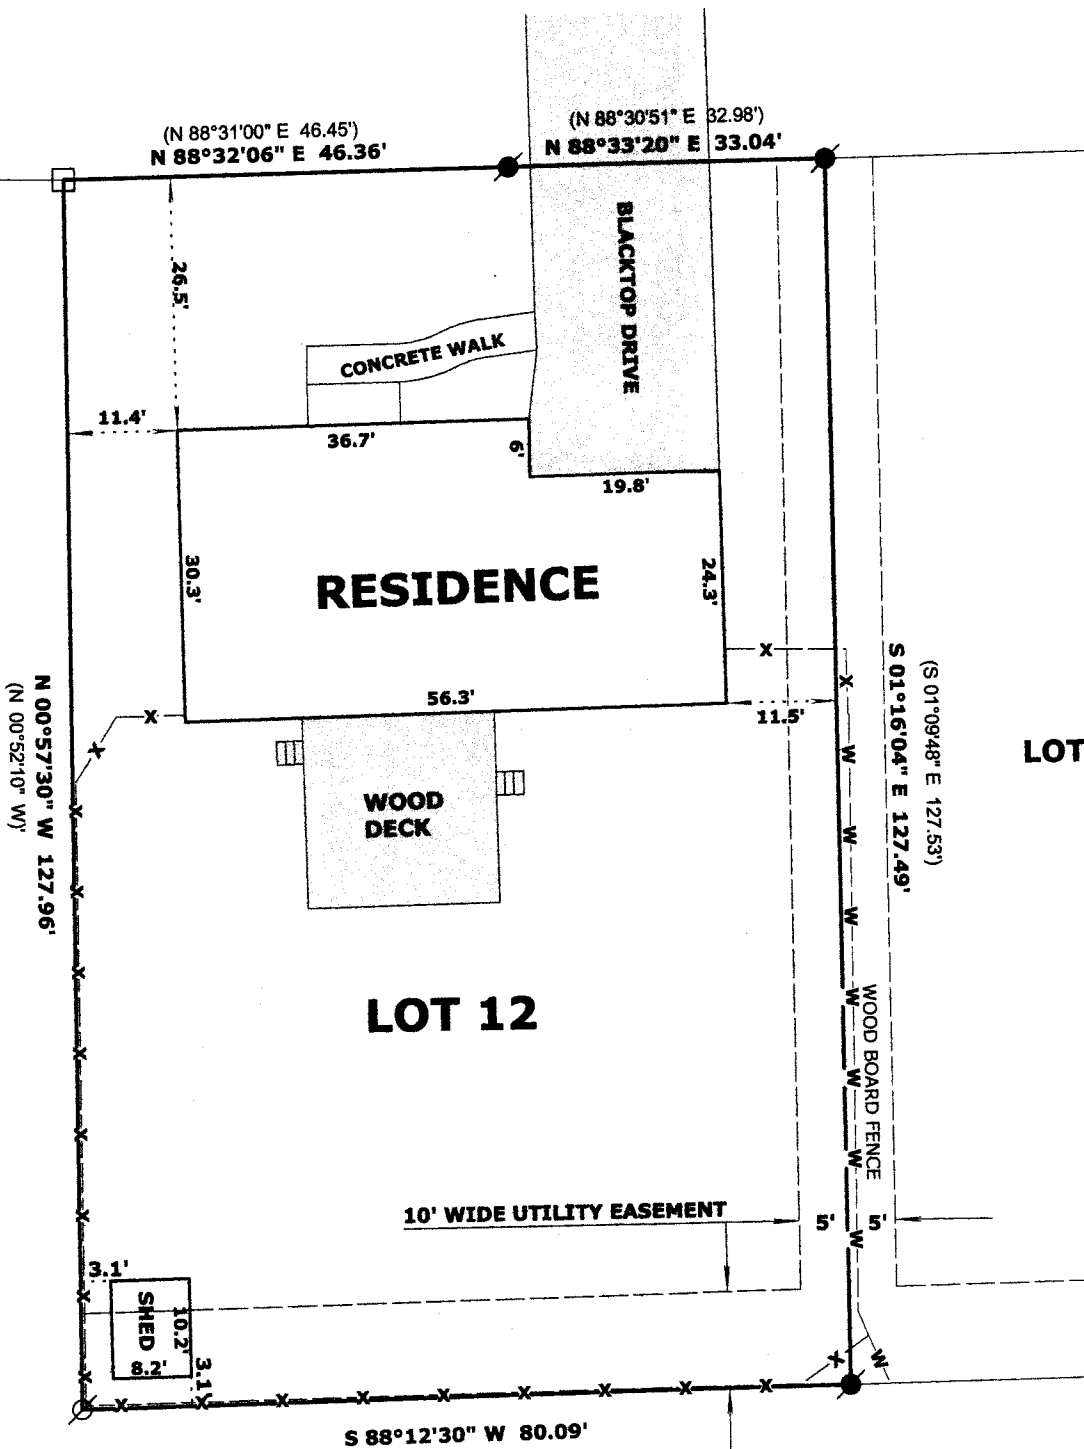

LOT 13

THE SOUTH LINE OF LOT 12 WAS  
ASSUMED TO BEAR S 88°12'30" W  
AS PLATTED

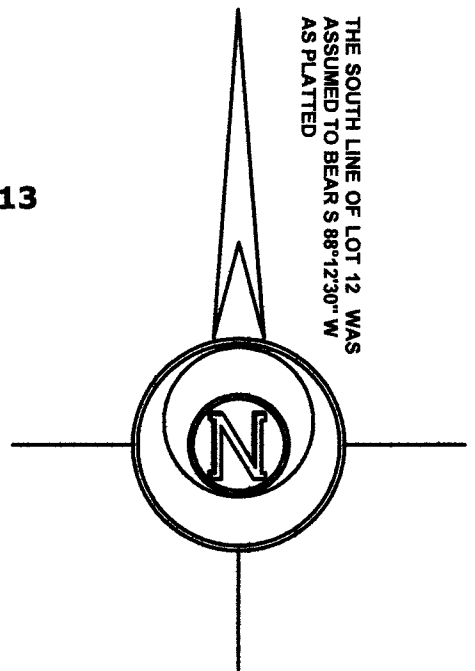


LEGEND

- FOUND IRON PIPE
- FOUND IRON ROD
- FOUND STONE MONUMENT
- RECORDED AS DIMENSION
- EXISTING RAIL FENCE

SCALE: 1 INCH = 20 FEET

"I hereby certify that the above described property has been surveyed by me or under my direction and that the above map is a true representation thereof and shows the size and location of the property, its exterior boundaries, the location of all visible structures and dimensions of all principal buildings thereon, boundary fences, apparent easements, roadways and visible encroachments, if any."  
"This survey is made for the use of the present owners of the property, and also those who purchase, mortgage, or guarantee the title thereto within one year from date hereof."

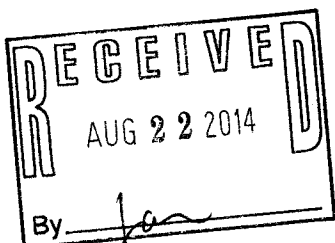

Mark L. Miritz  
MARK L. MIRITZ  
WISCONSIN REGISTERED  
LAND SURVEYOR S-2582  
DATE: JULY 29, 2014 JOB NO. 14.712

ZGAR -12

007-3052