


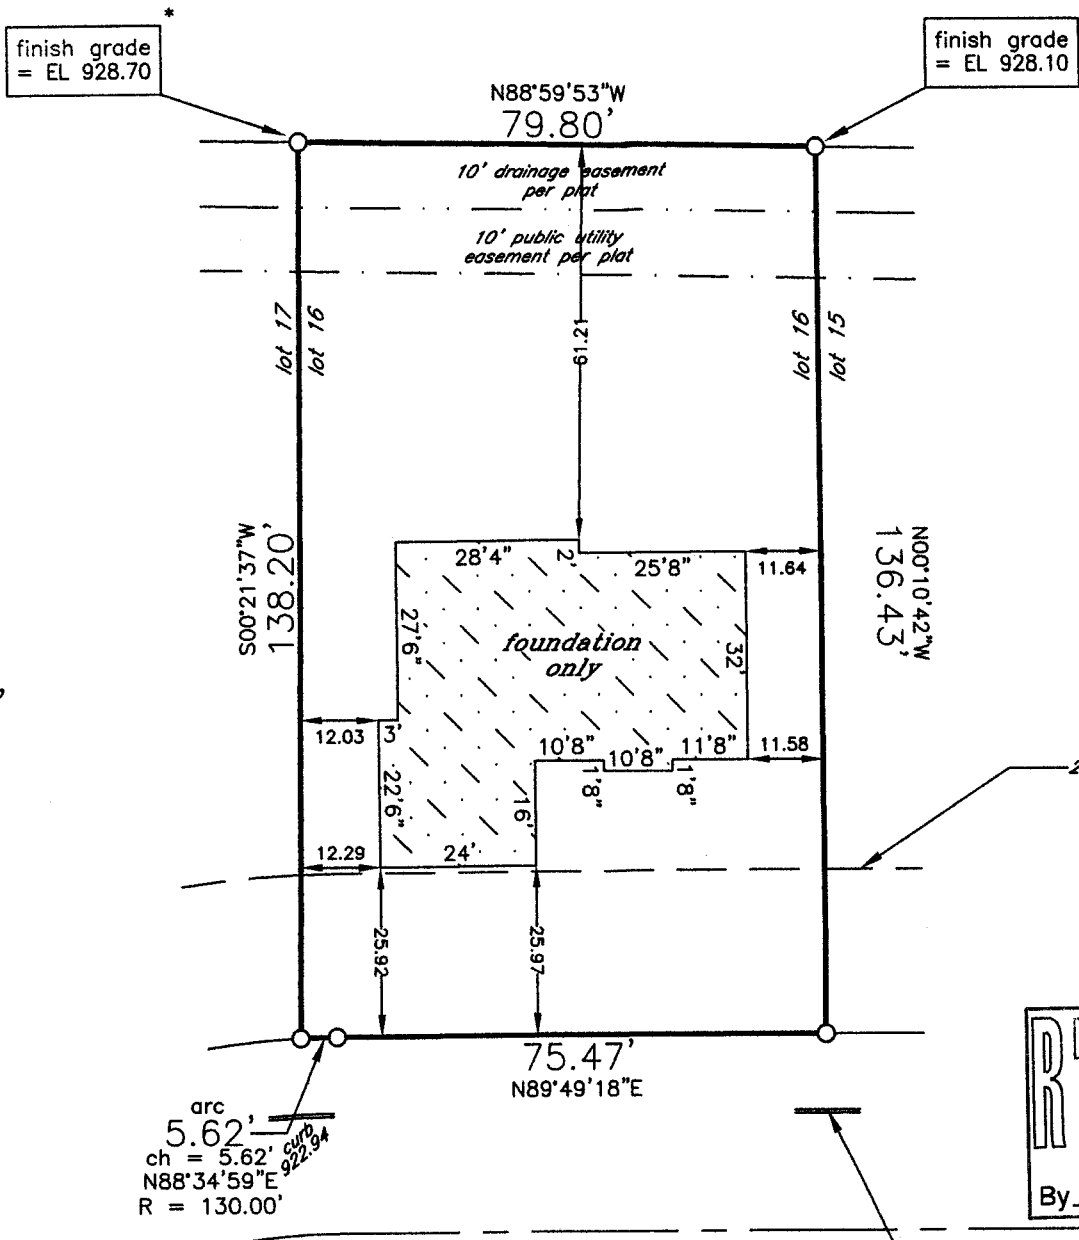

RECEIVED
SEP 22 2014
By *[Signature]*

☞ Sky Line Drive

* top of foundation elevation = 927.62

* outside finish grade = EL 927.00 (advisory only) - top of foundation = EL 927.67 (advisory only) unless otherwise determined in writing by City Engineering Department


lot area = 11,040 S.F.

* Verify exact number with City Engineering Department

Proposed building field staked true size. Contractor to verify all dimensions before building by same and adhere to drainage plan in effect for this subdivision. Refer to a current title report for easements or restrictions which may affect the use of this site that are not shown on the recorded subdivision plat.

J.K.R. SURVEYING, INC.
8121 22ND AVENUE
KENOSHA, WI 53143

Plat of Survey of
LOT 16 IN
THE HIGHLANDS OF LAKE GENEVA
in SW1/4 Section 31-2-18
CITY OF LAKE GENEVA
WALWORTH COUNTY, WIS.

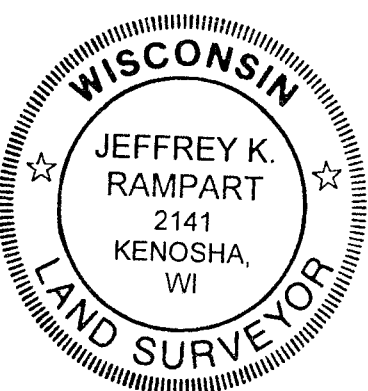

I hereby certify that this property was surveyed under my direction and this plat is a true representation thereof.

[Signature]

Reg. Land Surveyor

June 5, 2014
Revised 6/19/14
Revised 8/8/14

-for-
Serenity Homes Elite