



PREPARED FOR
GARY DUNHAM
KEEFE REAL ESTATE
LAKE GENEVA WI.

PLAT OF SURVEY

- OF -

PATHFINDER SURVEYING INC.
(formerly)
J.K. SURVEYING INC.
P.O BOX 322
LAKE GENEVA, WI. 53147
WWW.PATHFINDERSURVEYING.NET
262-248-8303

THE NORTH 1/2 OF LOT 5, BLOCK 13, GENEVA LAKE CRAWFORD
MANUFACTURING Co. ADDITION TO THE CITY OF LAKE GENEVA,
LOCATED IN THE SE 1/4 OF SECTION 25, TOWN 2 NORTH, RANGE
17 EAST, CITY OF LAKE GENEVA, COUNTY OF WALWORTH AND
STATE OF WISCONSIN.

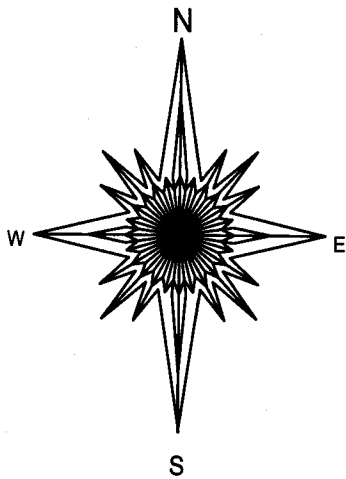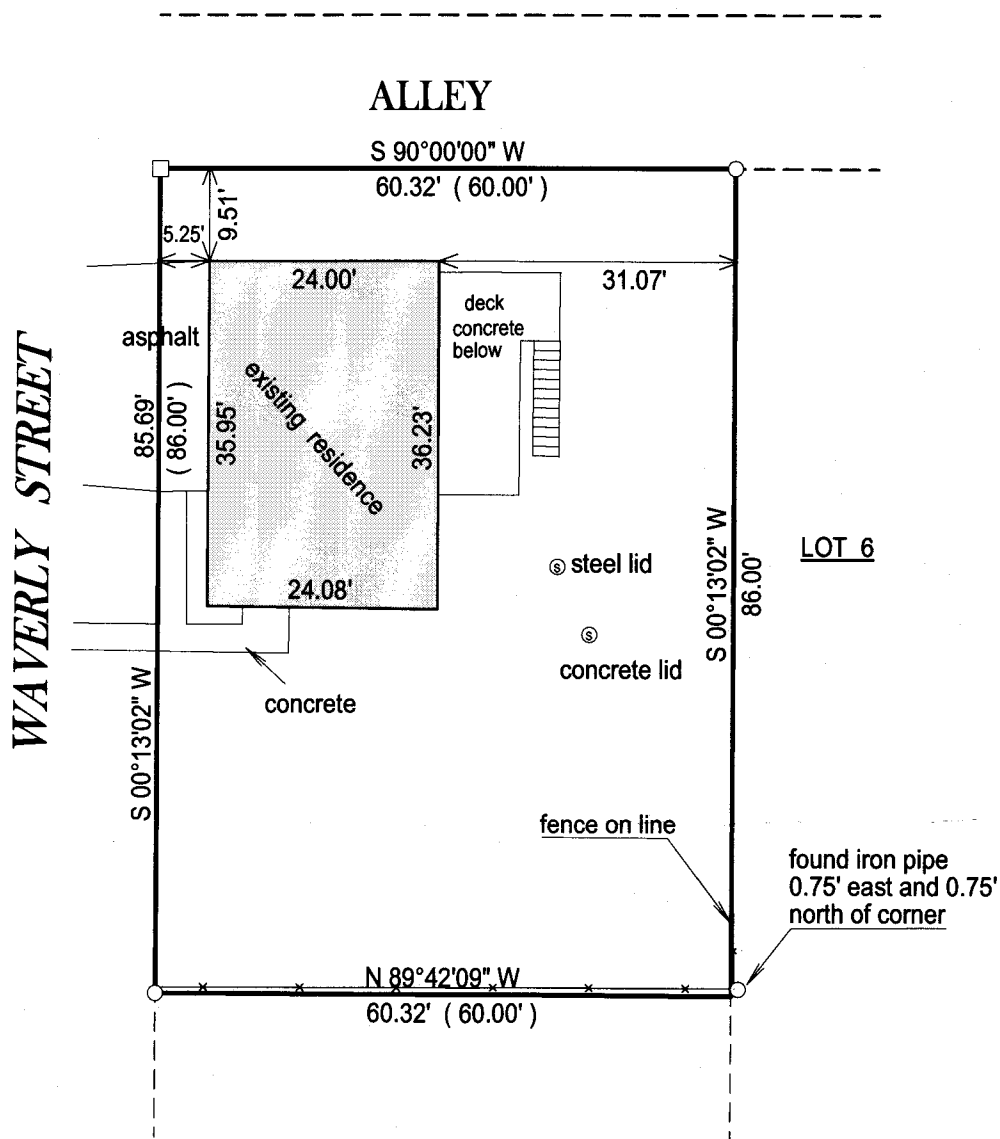

() = recorded as

□ = found iron bar

○ = found iron pipe


● = set iron pipe

■ = set iron bar

SCALE 1" = 20'

JOB # 14-191

TAX ID #
ZGC 00051A

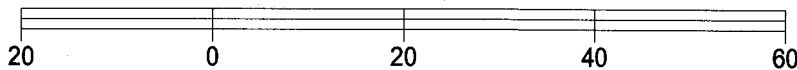


BASIS OF BEARING OF THIS PLAT: THE SOUTH LINE OF THE
ALLEY WAS ASSUMED TO BEAR WEST.

I hereby certify that I have surveyed the above- described property and the
above map is a true representation thereof and shows the size and
location of the property, its exterior boundaries, the location and
dimensions of all structures thereon, fences, apparrant easements and
roadways and visible encroachments if any.

This survey is made for the present owners of the property, and those who
purchase, mortgage, or guarantee the title thereto, within one year from
the date hereof.

DATED THIS 21st day of August, 2014.

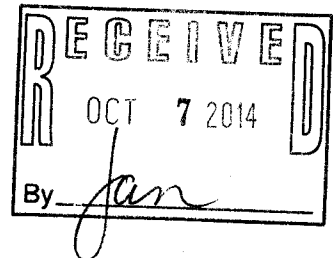

JEFFREY L KIMPS / S - 2436
Wisconsin Registered Land Surveyor
(original if signed in red)

ZGC-51A

007-3075