

concluded
1/10
stands
no
2
more
22
23

24

0 8 ft

meter
S.E.
lake
ions
e

19

d.

E.

E.

4/26. Surveyed lot 12,
Block 24, Crawford
Ave. to Lake Geneva for
Mrs. Schneider.
Measured E. from N.E. cor. lot 2,
B. 24. (stake found) 188' and
found old stake (lot 4, B. 24).
Measured south 120' and
E. 188' from S.E. cor. (stake
found) at lot 6, B. 25, and
found remains of original
stake 6" below surface. Measure
south 60' dug and found
original stake S.E. cor. lot 4
B. 25. Set transit over
center of this stake and
sighted at center of stake
at S.E. cor. lot 4, B. 25, and
line passed over center of
lake at N.E. cor. of lot 12,
B. 25. Continued line (which
is W. line of section) and
measured 66' from said last
mentioned stake set point
& continued N. 122' and
set point for N.E. cor. lot 12
B. 24. Dug & found old stake
about center about 12" W. of
line. Point is S.E. cor. lot
12. Measured 60' W. on N. line
& on S. line and made points
dug for N.W. cor. and found
old stake at point.
Set 1" iron stakes at 4 corners
of lot.
W. line passes close to center
of well and at E. side of
pump. Pump well on line
to pump evidently intended
for Peter Kiesel Madison St. cor. 11

Lot 12, Bk 24 Geneva Lake Crawford Mrs. Schneider

CC-154

7-307-Sk

to be on line at N.E. Cor.
the N.W. Cor. is at N.E. Cor.
of small shed or barn.
See plat. B. Palmer, Asst

4/26

Set E. line of lot 8.
B. 2nd Crawford for

Rog. Wrightman Stakes
set on line. No
for miles given.

Measured 66' for sage St.
from E. Stakes at lot 12
24' above.


Wrightman's shed to barn
stands 8' over line at N.E.
Cor. about 100' over at
S.E. Cor.

B. Palmer, Asst

4/29/15 H. Curtis

Deed from Curtis.
surveyed & decided to
set line of 5 E.
sect. 22, 4, 2, N. R.
south of Lake George
road and 51 rods
N.E. 1/4 sect. 27.
Set first line of
survey 51 rods west
Stakes set to with
three iron stake
next to road. sec.
B.

Area found to be 30.
Line on west measur
on north end, estimated
south end. The rest m.
trigonometry as follow

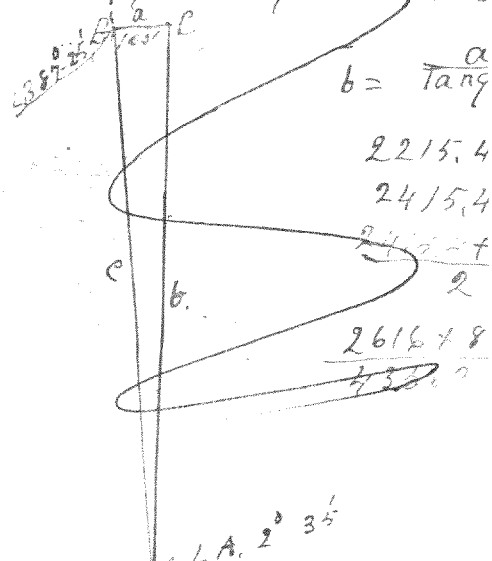

Stake 30 from lake
Peter Kussol Hand.