


PLAT OF SURVEY
-OF-


(TAKEN FROM WARRANTY DEED, DOC. NO. 112401)
PART OF LOTS 7 AND 8 IN BLOCK 31 OF THE ORIGINAL PLAT OF LAKE
GENEVA, WALWORTH COUNTY, WISCONSIN, DESCRIBED AS FOLLOWS:
BEGINNING IN THE SOUTH LINE OF SAID BLOCK 31 AT A POINT 93' DISTANT
SOUTHEASTERLY FROM THE SOUTHWEST CORNER OF SAID BLOCK; THENCE
NORTHWESTERLY IN THE SOUTH LINE OF SAID BLOCK 46.5'; THENCE NORT
14'; THENCE NORTHEASTERLY TO A POINT IN THE SOUTH LINE OF THE
ALLEY WHICH POINT IS 51.5'EASTERLY FROM THE NORTHWEST CORNER OF
LOT 7 IN SAID BLOCK; THENCE EASTERLY IN THE SOUTH LINE OF SAID
ALLEY, 51.5'; THENCE SOUTHWESTERLY TO THE PLACE OF BEGINNING.

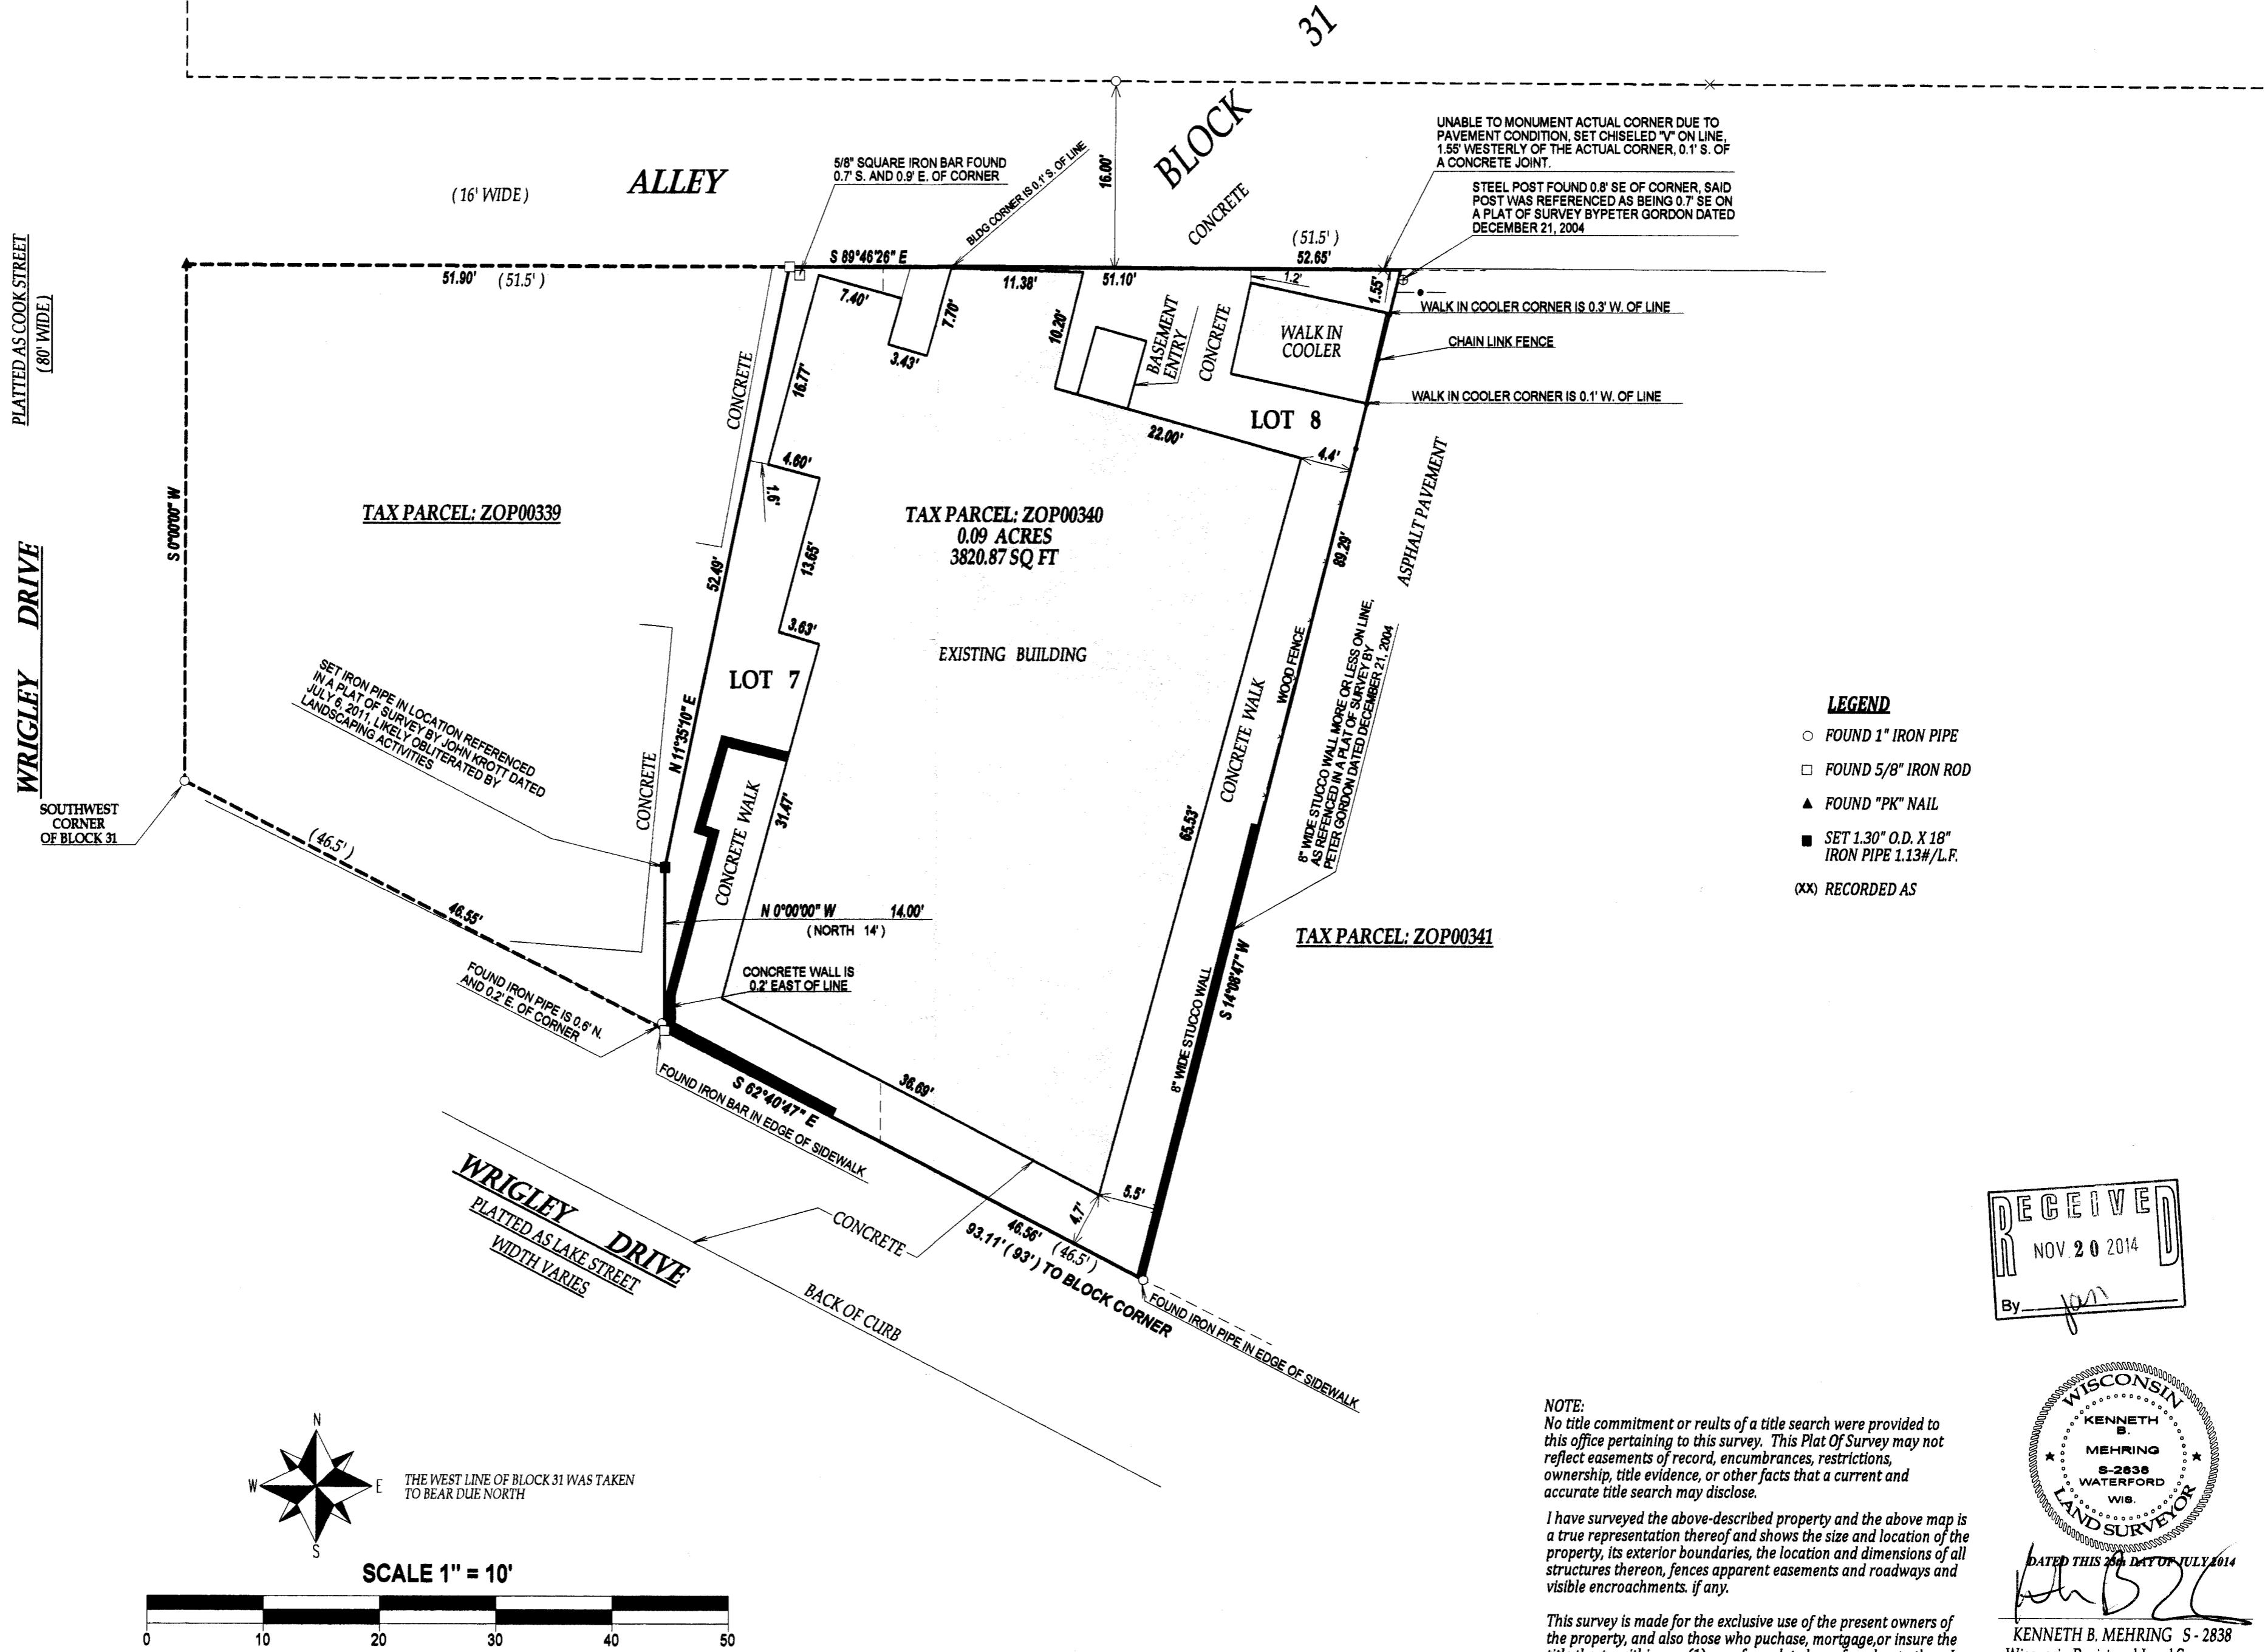

NOTE:
No title commitment or results of a title search were provided to this office pertaining to this survey. This Plat Of Survey may not reflect easements of record, encumbrances, restrictions, ownership, title evidence, or other facts that a current and accurate title search may disclose.

I have surveyed the above-described property and the above map is a true representation thereof and shows the size and location of the property, its exterior boundaries, the location and dimensions of all structures thereon, fences apparent easements and roadways and visible encroachments, if any.

This survey is made for the exclusive use of the present owners of the property, and also those who purchase, mortgage, or insure the title thereto within one (1) year from date hereof; and as to them I warrant the accuracy of said survey map.

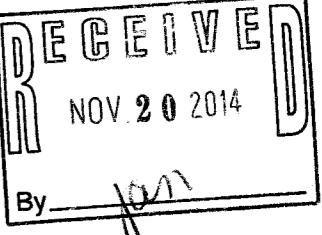

[Handwritten signature of Kenneth B. Mehring]
KENNETH B. MEHRING S - 2838
Wisconsin Registered Land Surveyor
(original if signed in red)