


48-27

HENRY STREET

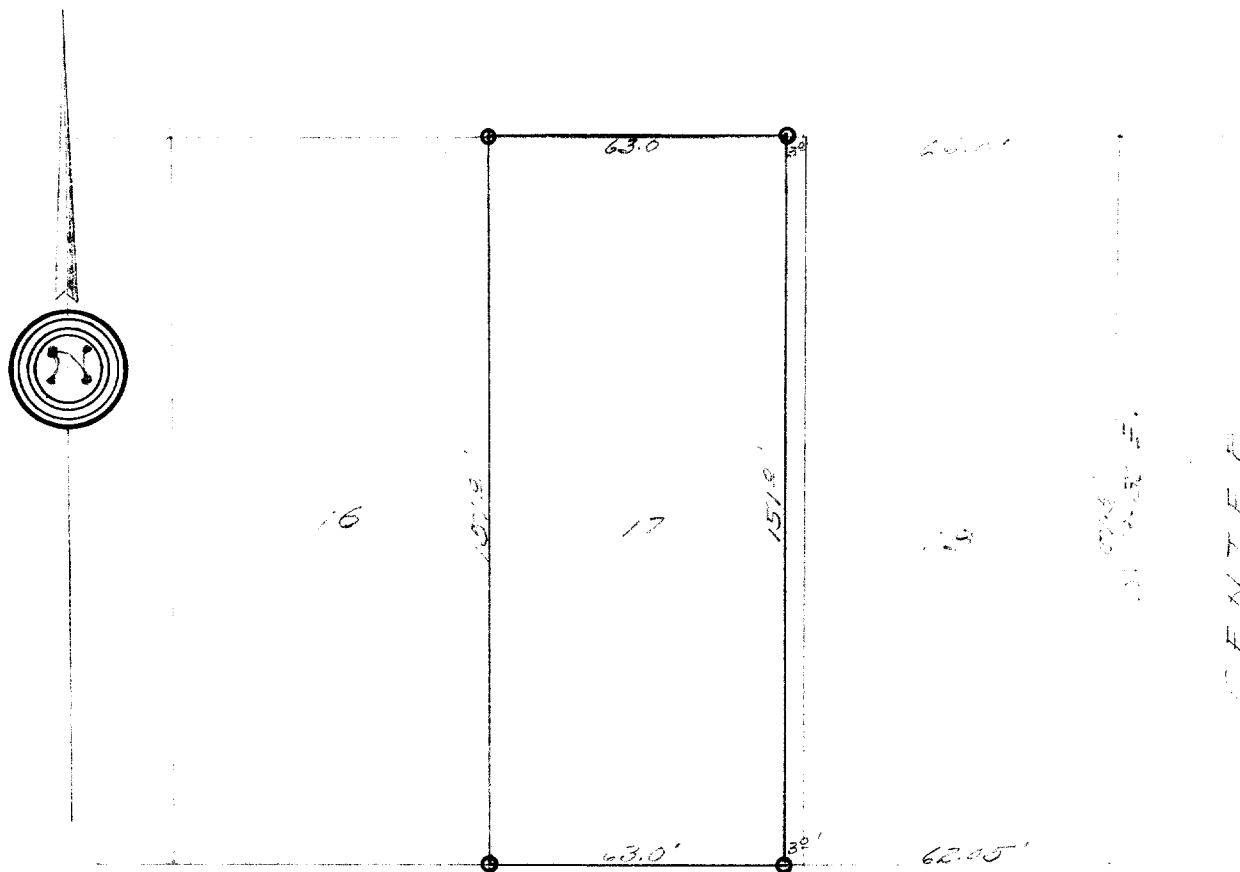

DESCRIPTION:

The West 63.0 feet of Lot 17, Ferguson's Addition to the Village (now city) of Lake Geneva Walworth County, Wisconsin.

Certification:

I, hereby certify that I have on this the 18th day of June 1948, surveyed the above described property according to the official records on file in the office of the Recorder of Deeds in and for Walworth County, Wisconsin, and find that the measurements and bearings of the boundary lines of said property as taken at the site on this day, substantially agree with those in the above description and that no encroachments exist.

SIGNED AND SEALED THIS 18th DAY OF JUNE 1948.

Joseph M. Biagi
Joseph M. Biagi, Professional Engineer.
Elkhorn, Wisconsin.