


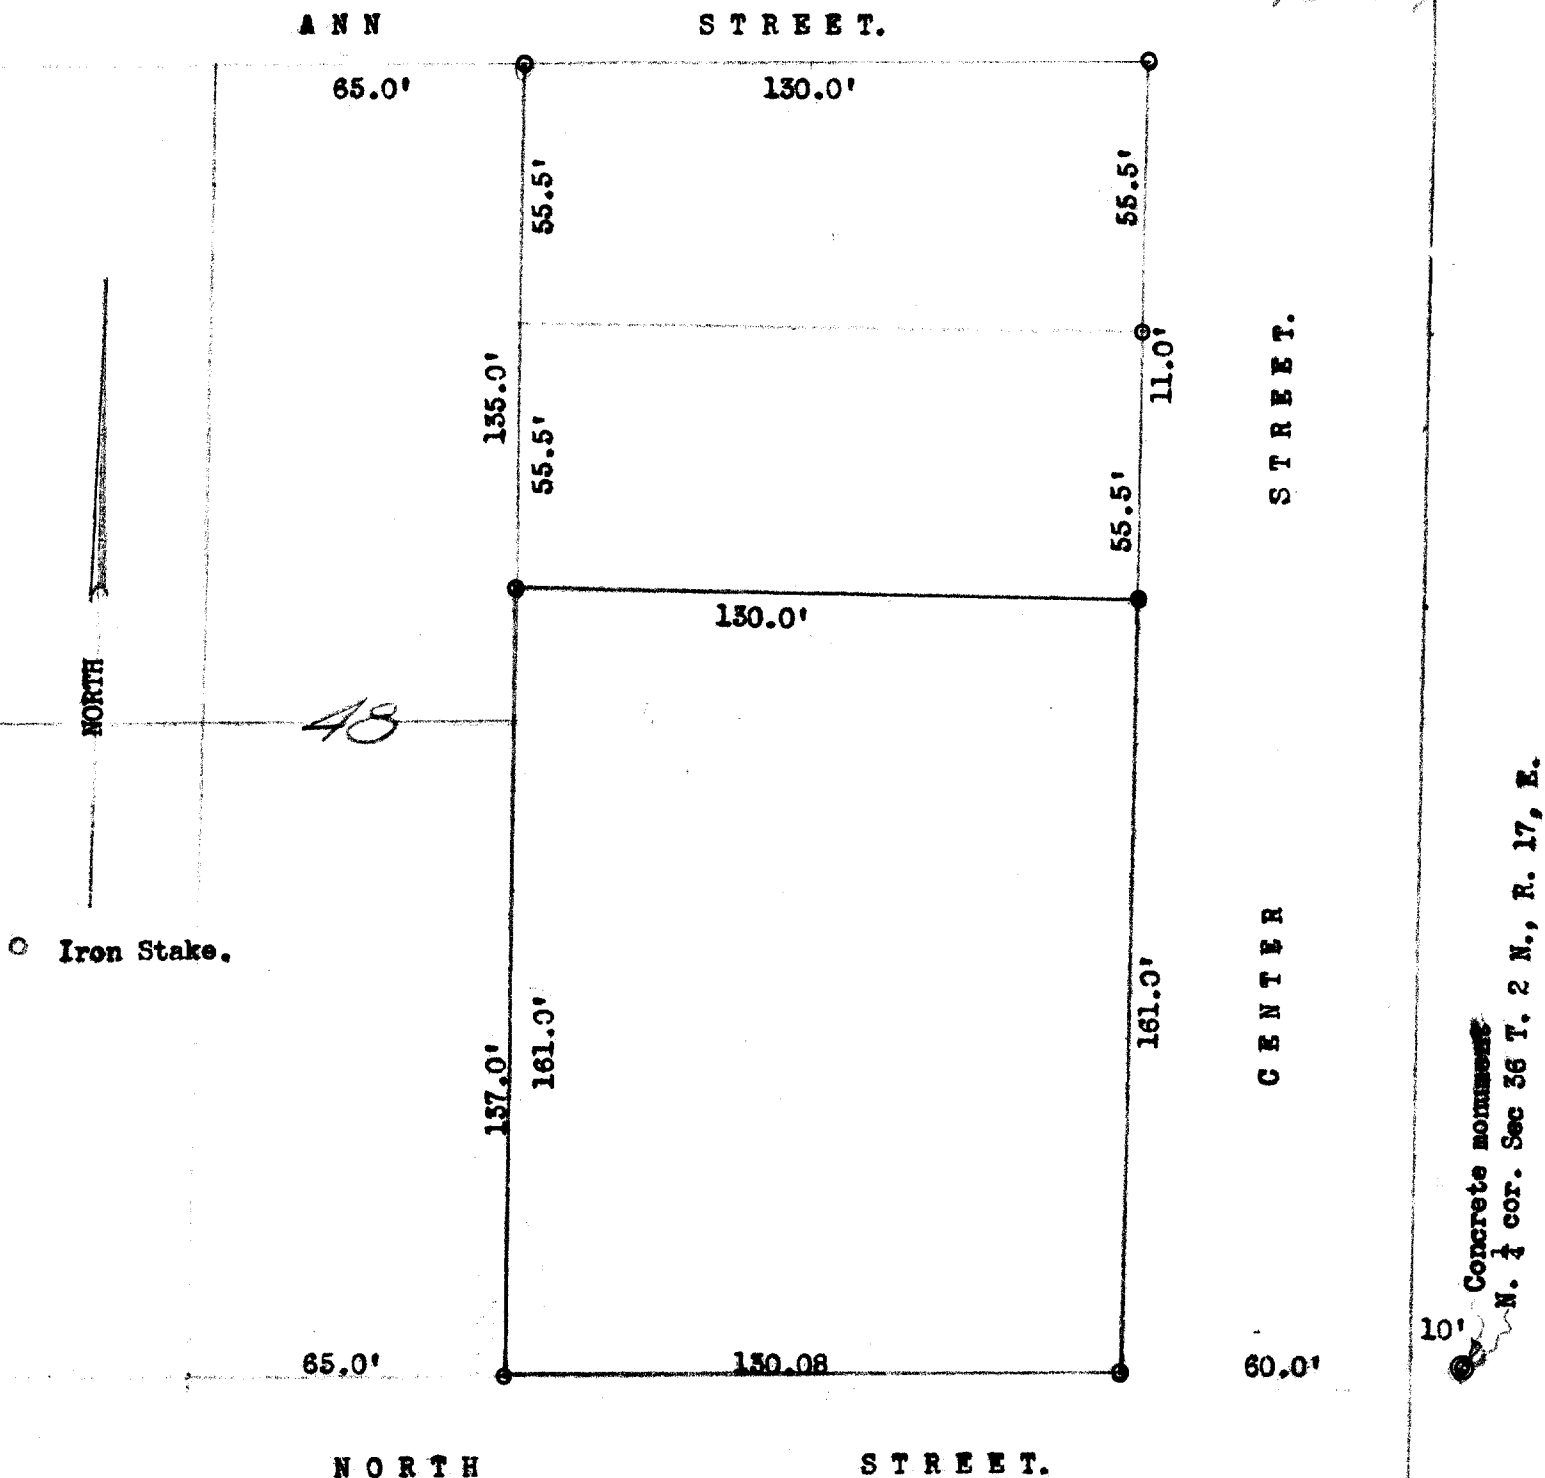

DESCRIPTION: The east 130 feet of Large Lot 48 in Ferguson's Addition to the Village (now city) of Lake Geneva Walworth County, Wisconsin, excepting therefrom the north 11.0 feet thereof.

CERTIFICATE: I, hereby certify that I have on this the 3rd day of October 1946, surveyed the above described property according to the official records on file in the office of the Recorder of Deeds in and for Walworth County Wisconsin, and find that the measurements and bearings of the boundary lines of said property as taken at the site on this day, substantially agree with those on the above portrayed plat.

SIGNED AND SEALED THIS 4TH DAY OF OCTOBER 1946.

Joseph M. Biagi
Joseph M. Biagi, Professional Engineer.
Elkhorn Wisconsin.