

ORDERED BY
RACHEL HUBINGER


PLAT OF SURVEY

- OF -

PATHFINDER SURVEYING INC.
(formerly)
J.K. SURVEYING INC.
P.O BOX 322
LAKE GENEVA, WI. 53147
WWW.PATHFINDERSURVEYING.NET
262-248-8303

THE WEST 32 FEET OF THE NORTH 208 FEET OF LOT 2 AND THE NORTH
130 FEET OF LOT 3, BLOCK 4, E.D. PHILLIPS SUBDIVISION, CITY OF LAKE GENEVA,
LOCATED IN SECTION 36, TOWN 2 NORTH, RANGE 17 EAST, CITY OF LAKE GENEVA,
WALWORTH COUNTY, WISCONSIN.

DARWIN STREET

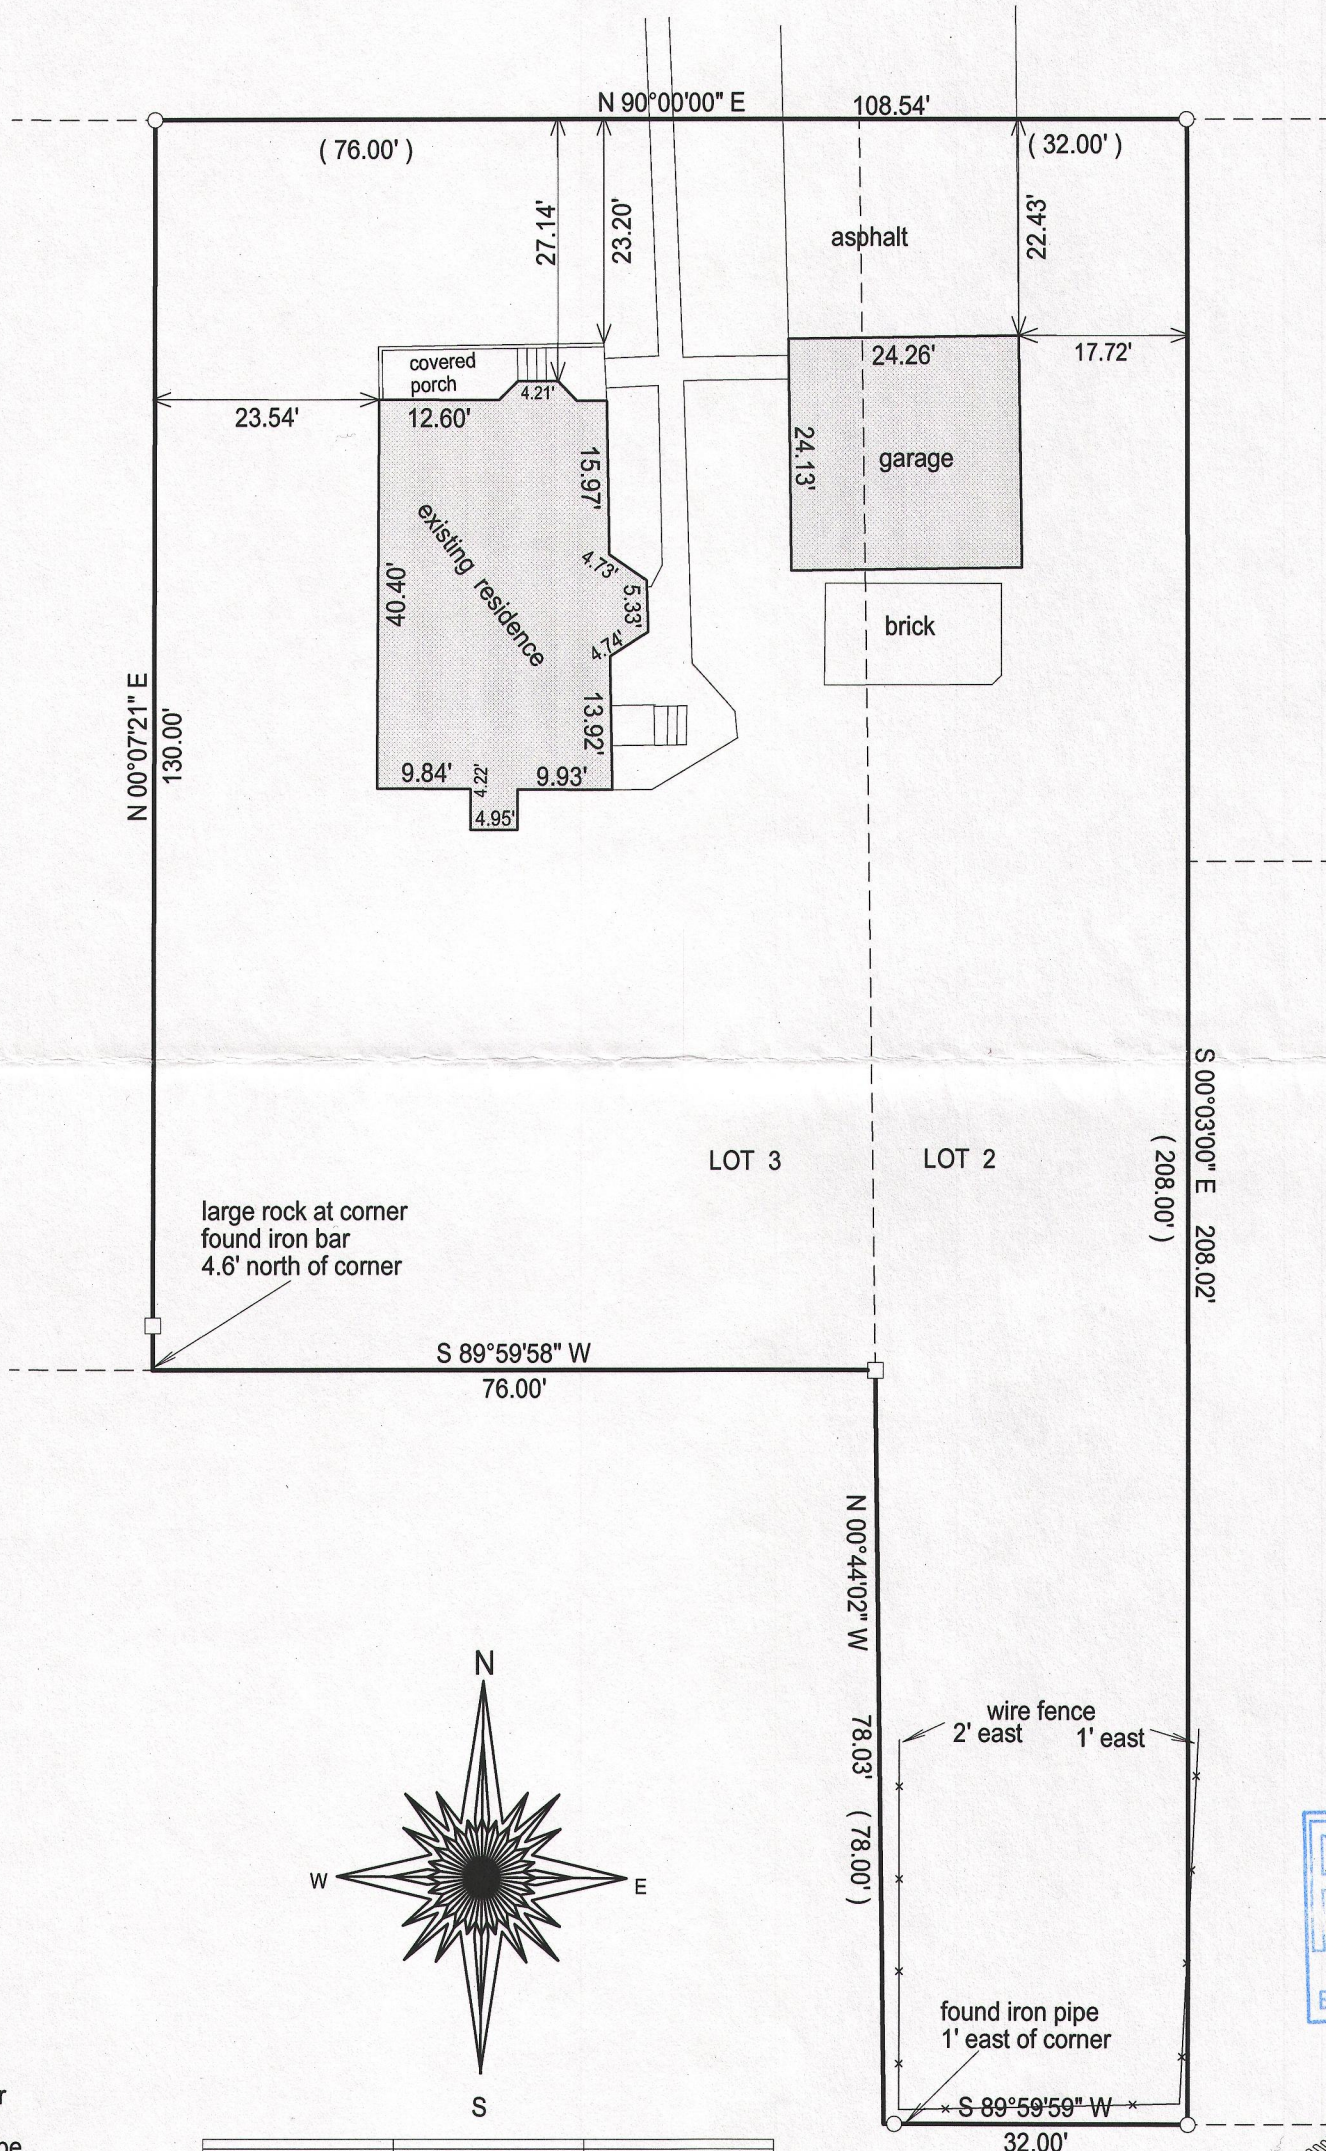

- () = recorded as
□ = found iron bar
○ = found iron pipe
● = set iron pipe
■ = set iron bar

SCALE 1" = 20'

JOB # 14-196

TAX ID #
ZPI00025

BASIS OF BEARING OF THIS PLAT: THE SOUTH LINE OF DARWIN
ST. WAS ASSUMED TO BEAR EAST.

I hereby certify that I have surveyed the above- described property and the
above map is a true representation thereof and shows the size and
location of the property, its exterior boundaries, the location and
dimensions of all structures thereon, fences, apparant easements and
roadways and visible encroachments if any.

This survey is made for the present owners of the property, and those who
purchase, mortgage, or guarantee the title thereto, within one year from
the date hereof.

DATED THIS 26TH DAY OF AUGUST, 2014.

JEFFREY L. KIMPS S - 2436
Wisconsin Registered Land Surveyor
(original if signed in red)

ZP# - 25

007- 3106