

PLAT OF SURVEY
-OF-


LOT 34, MEADOWLAND SUBDIVISION,
ACCORDING TO THE RECORDED PLAT
THEREOF. SAID LAND BEING IN THE
CITY OF LAKE GENEVA, COUNTY OF
WALWORTH AND STATE OF WISCONSIN.

SURVEY FOR: FRED GELDERMANN OF
RE/MAX GENEVA REALTY

SURVEY ADDRESS: 779 JOSHUA LANE,
LAKE GENEVA, WI 53147

CURVE DATA

RADIUS = 130.00'
CENTRAL ANGLE = 25°19'42"
CHORD = 57.00'
CHORD BEARING = N77°12'04"E

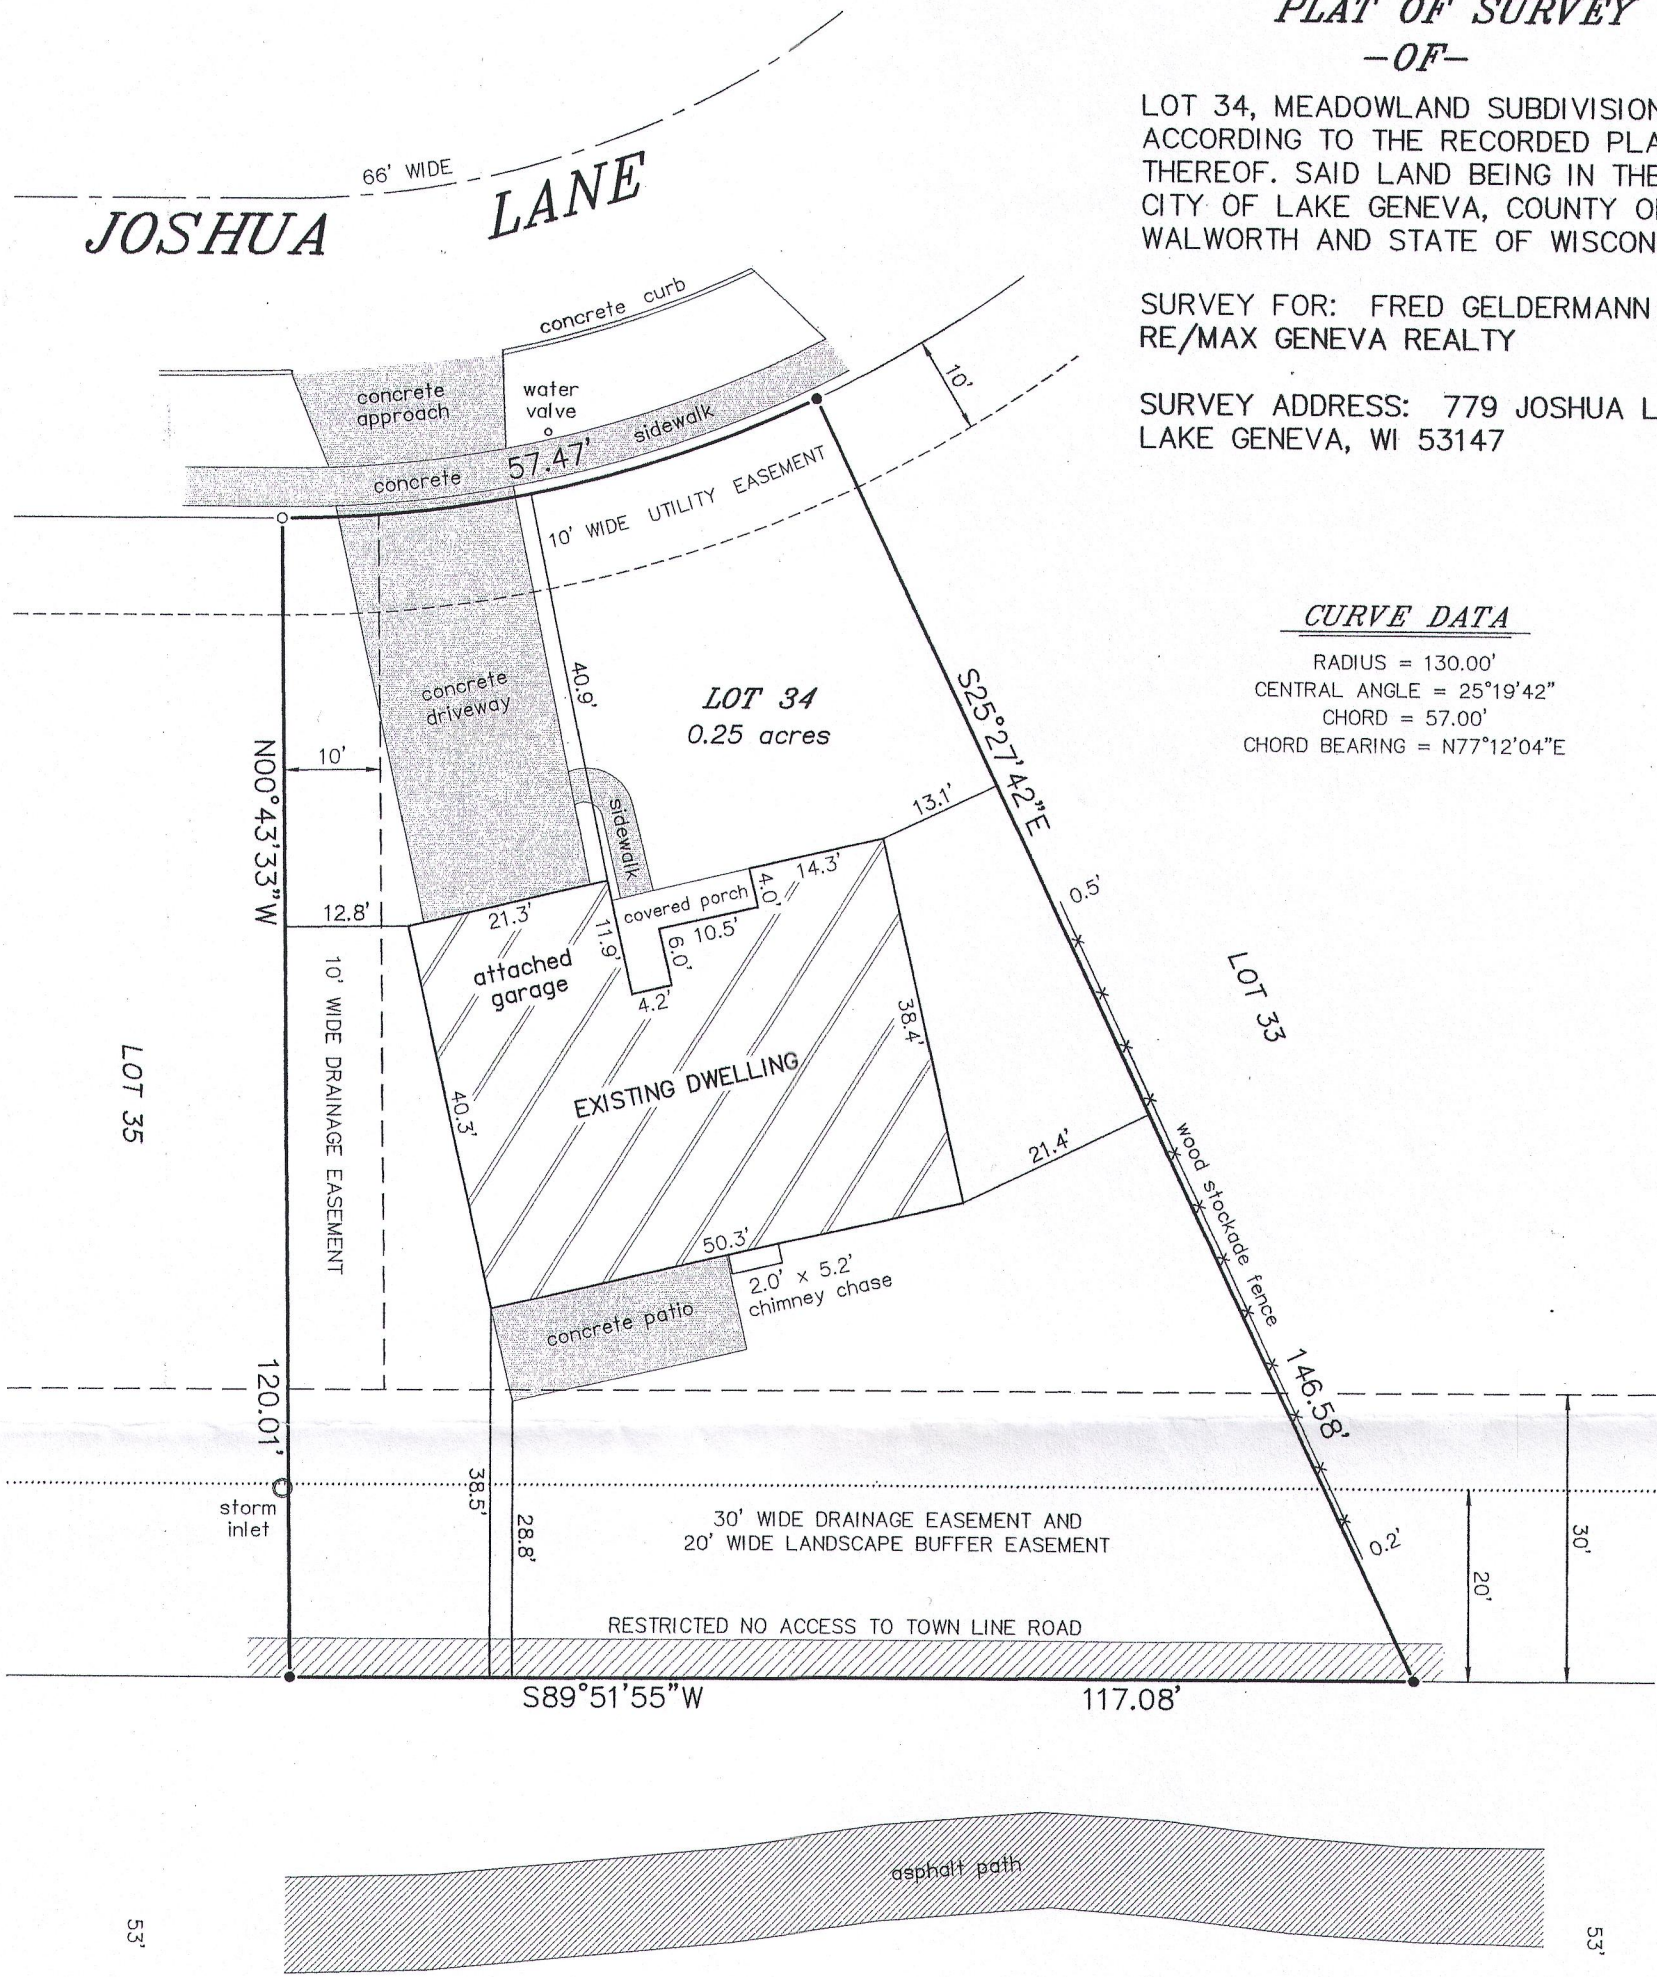

TOWN LINE ROAD



LEGEND

- FOUND 1-5/16" DIA. IRON ROD
- FOUND 3/4" DIAMETER IRON ROD

"I HEREBY CERTIFY THAT I HAVE SURVEYED THE ABOVE
DESCRIBED PROPERTY AND THAT THE ABOVE MAP IS A CORRECT
REPRESENTATION THEREOF AND SHOWS THE SIZE AND LOCATION
OF THE PROPERTY, ITS EXTERIOR BOUNDARIES, THE LOCATION
OF ALL VISIBLE STRUCTURES AND DIMENSIONS OF ALL
PRINCIPAL BUILDINGS THEREON, BOUNDARY FENCES, APPARENT
EASEMENTS, ROADWAYS AND ENCROACHMENTS, IF ANY."

"THIS SURVEY IS MADE FOR THE USE OF THE PRESENT OWNERS
OF THE PROPERTY, AND THOSE WHO PURCHASE, MORTGAGE, OR
GUARANTEE THE TITLE THERETO WITHIN ONE YEAR FROM DATE
HEREOF."

SATTER SURVEYING, LLC
LAND SURVEYS, MAPPING AND PLANNING
272 ORIGEN STREET
BURLINGTON, WI 53105
262-661-4239

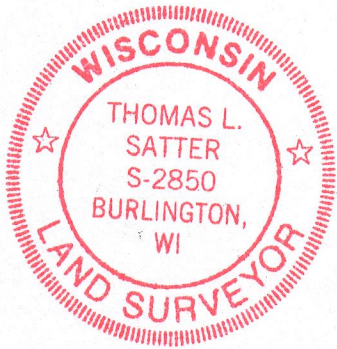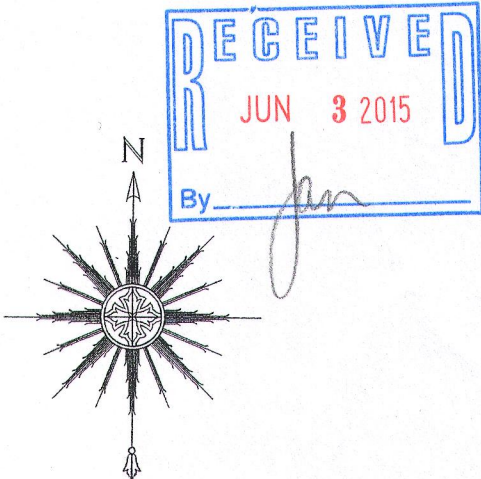

THIS IS NOT AN ORIGINAL PRINT
UNLESS THIS SEAL IS RED.

Thomas L. Satter
THOMAS L. SATTER S-2850

MAY 26, 2015
DATE

051514
JOB NUMBER

ZMEA -34 007-3142