

PREPARED FOR:  
JANE LEWIS  
201 PEARSON DR.  
LAKE GENEVA, WI 53147


# PLAT OF SURVEY

-OF-


LYNCH & ASSOCIATES  
ENGINEERING CONSULTANTS, LLC.  
405 SKYLINE DRIVE, SUITE C  
LAKE GENEVA, WI 53147  
(262) 248-3697

PARCEL 1:  
LOT 35 OF PEARSON'S SUBDIVISION TO THE CITY OF LAKE  
GENEVA, ACCORDING TO THE RECORDED PLAT THEREOF,  
WALWORTH COUNTY, WISCONSIN.

PARCEL 2:  
LOT 36 OF PEARSON'S SUBDIVISION TO THE CITY OF LAKE  
GENEVA, WALWORTH COUNTY, WISCONSIN.

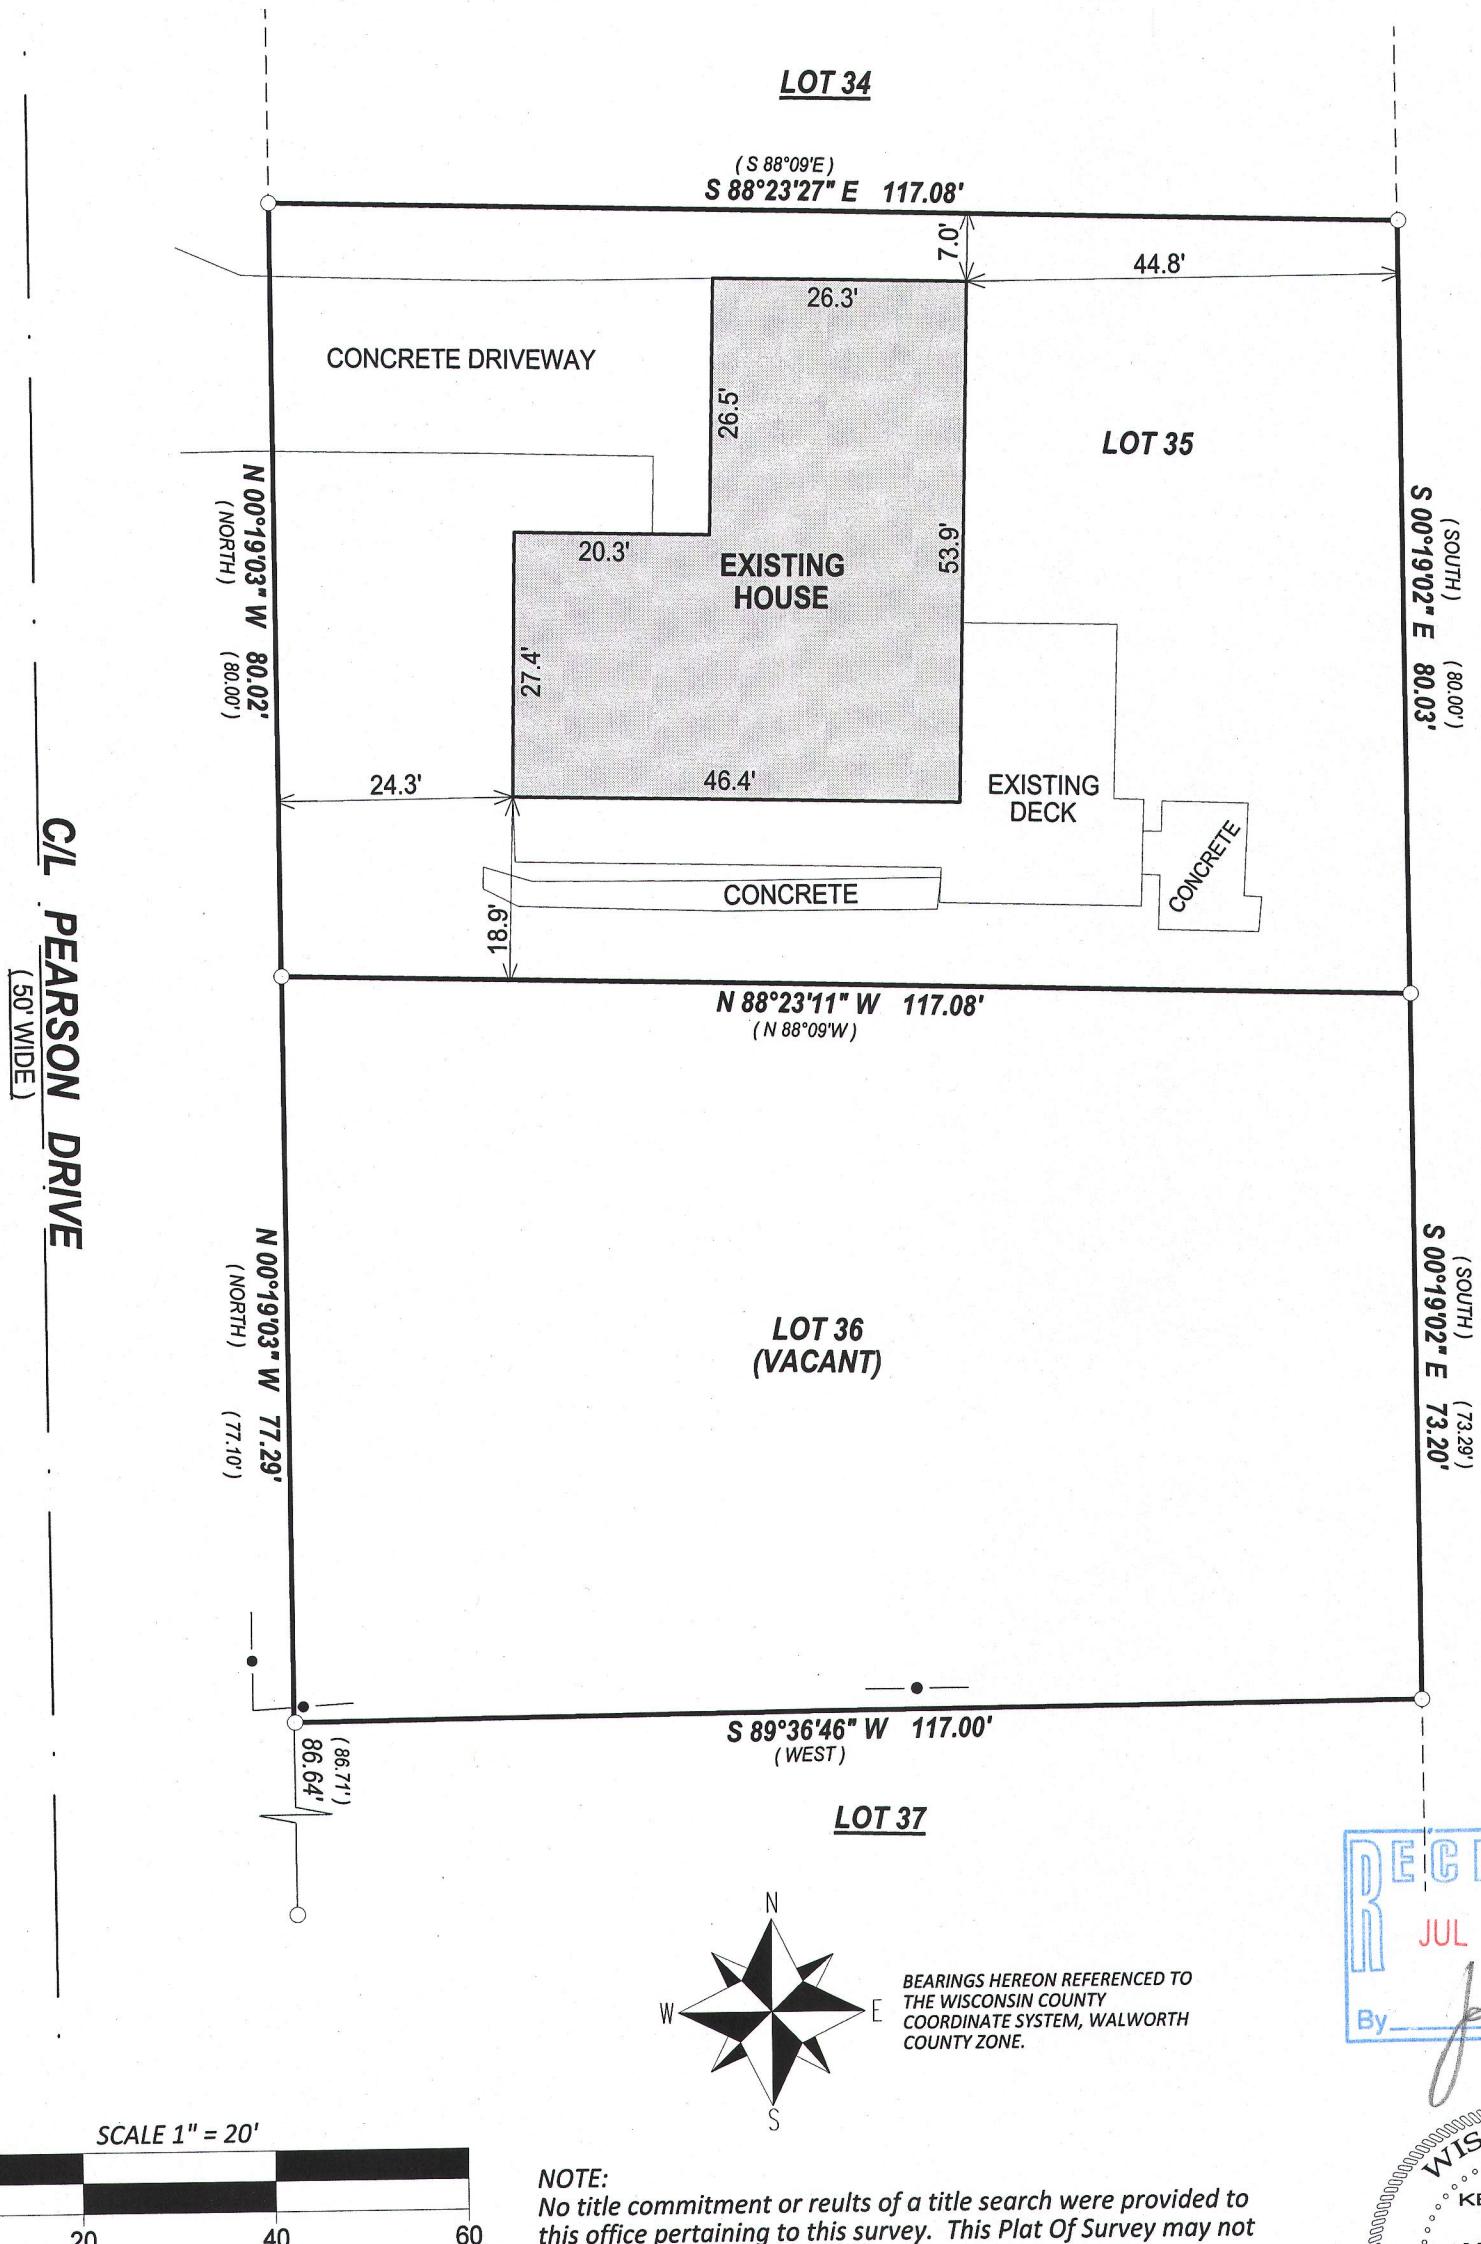

BEARINGS HEREON REFERENCED TO  
THE WISCONSIN COUNTY  
COORDINATE SYSTEM, WALWORTH  
COUNTY ZONE.

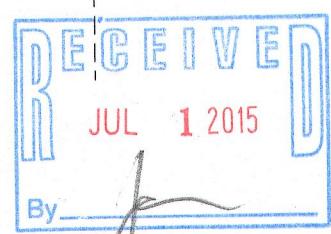

DATED THIS 13th DAY OF MAY, 2015

KENNETH B. MEHRING S-2838  
Wisconsin Professional Land Surveyor  
(original if signed in red)