


Lot 18, Columbian Subdivision

Begin at a point 1' north and 1' at N.E. corner of Pleasant and of lot No. 25, said subdivision, St. 350' to the S.W. corner of lot to the S.E. corner of lot 18 (Set line of cement walk east intersects south line of alley of alley 350' to N.W. corner of stake at S.W. corner and set lot 18, measured 150' N. from E line of lot 18 was measured at to be 4' from wall of her house W. P. Hague told her that her house

Mar. 19, 1914

By request of John Allen measured Mrs. Davis's lot N.E. corner Geneva & Sage Sts. B. R. Plat makes N. B. 137' B. E. 84' C. D. 71' & D. E. 94' occupied 150' B. E. 120' B. E. 84'

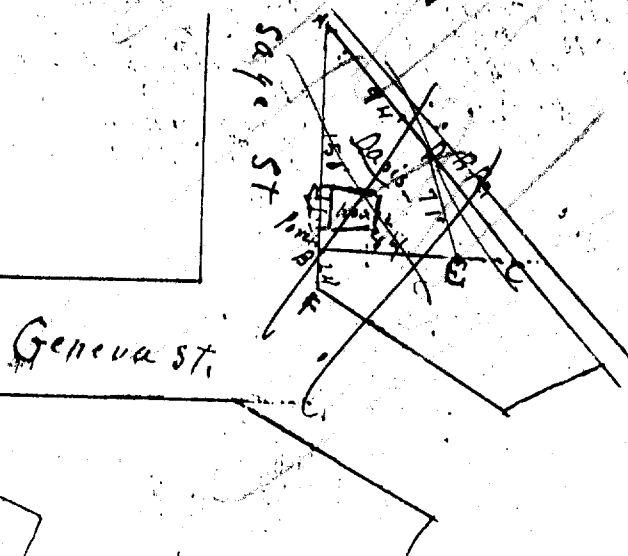

March 13, 1914

east of inner corner of cement walk Clover Sts. which is the S.W. corner Thence E. along said N. line of Pleasant 18. (Set 1" gas pipe) thence east 50' more 2" gas pipe. At a point 1' E. of inner side of Clover St. where same thence east along said south line lot 18, also measured 150' north from 1" gas pipe. Thence east 50' to N.E. cor. S.E. corner of lot 18 and set 1" gas pipe. Mrs. McCartney's house and found which distance Mrs. McCartney said was from the line.

J. G. Shields, Surveyor.

E. line of Sage St. passes about midway of Davis's west fence.

Land not occupied as shown.

J. G. S.

J. G. S.

Set 18, Columbian Subd

CL-17

7-314-Sk