


PLAT OF SURVEY

-OF-

LOT 11 IN BLOCK 22 IN GENEVA LAKE CRAWFORD MANUFACTURING COMPANY'S ADDITION TO THE VILLAGE OF GENEVA, NOW THE CITY OF LAKE GENEVA, WALWORTH COUNTY, WISCONSIN.

SURVEY FOR: BOB LIMOSANI OF HOMESTEAD REALTY INC.

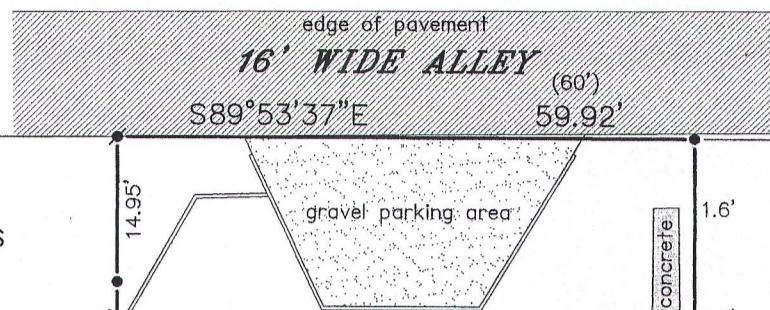


NOTE: REFER TO A CURRENT TITLE REPORT FOR EASEMENTS, RESTRICTIONS OR COVENANTS WHICH MAY AFFECT THIS PROPERTY.

LEGEND

- FOUND IRON PIPE IN CONCRETE
- FOUND IRON PIPE
- ¤ FOUND IRON ROD
- ¤ SET IRON PIPE
- () RECORDED AS

LOT 10

BEARINGS HEREON RELATE TO THE SOUTH LINE OF BLOCK 22 OF GENEVA LAKE CRAWFORD MANUFACTURING COMPANY'S ADDITION. ASSUMED BEARING OF WEST.

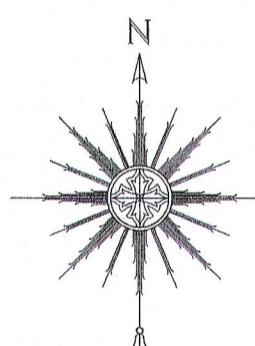

0 10' 20' 40'

SCALE: 1" = 20'

EAST RIGHT-OF-WAY LINE OF CRAWFORD STREET

LOT 11
0.237 acres

N00°07'03"E


LOT 12

S00°05'30"W

0.4'
0.3'
1.2'

landscaping

Top of leaning
pipe is 0.12' east
of actual corner.

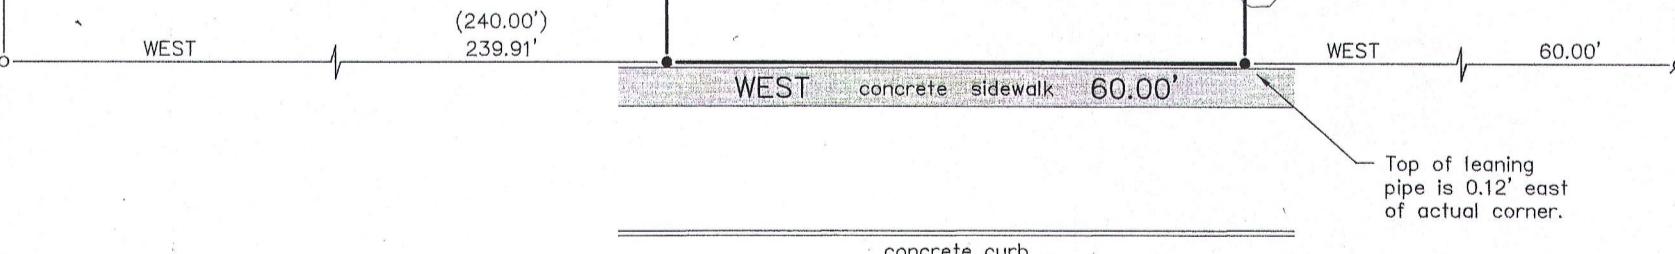

WATER (66' WIDE) STREET



"I HEREBY CERTIFY THAT I HAVE SURVEYED THE ABOVE DESCRIBED PROPERTY AND THAT THE ABOVE MAP IS A CORRECT REPRESENTATION THEREOF AND SHOWS THE SIZE AND LOCATION OF THE PROPERTY, ITS EXTERIOR BOUNDARIES, THE LOCATION OF ALL VISIBLE STRUCTURES AND DIMENSIONS OF ALL PRINCIPAL BUILDINGS THEREON, BOUNDARY FENCES, APPARENT EASEMENTS, ROADWAYS AND ENCROACHMENTS, IF ANY."

"THIS SURVEY IS MADE FOR THE USE OF THE PRESENT OWNERS OF THE PROPERTY, AND THOSE WHO PURCHASE, MORTGAGE, OR GUARANTEE THE TITLE THERETO WITHIN ONE YEAR FROM DATE HEREOF."

SATTER SURVEYING, LLC

LAND SURVEYS, MAPPING AND PLANNING

272 ORIGEN STREET
BURLINGTON, WI 53105
262-661-4239

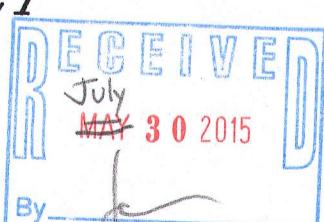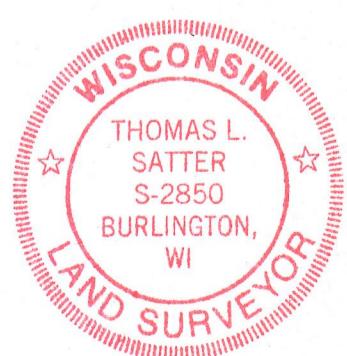

Thomas L. Satter
THOMAS L. SATTER
S-2850

THIS IS NOT AN ORIGINAL PRINT
UNLESS THIS SEAL IS RED.

JULY 7, 2015

061518

JOB NUMBER

ZGC -129 007-3165