


HAROLD H. KOLB
REGISTERED PROFESSIONAL LAND SURVEYOR
TWIST BUILDING
LAKE GENEVA, WIS. 53147

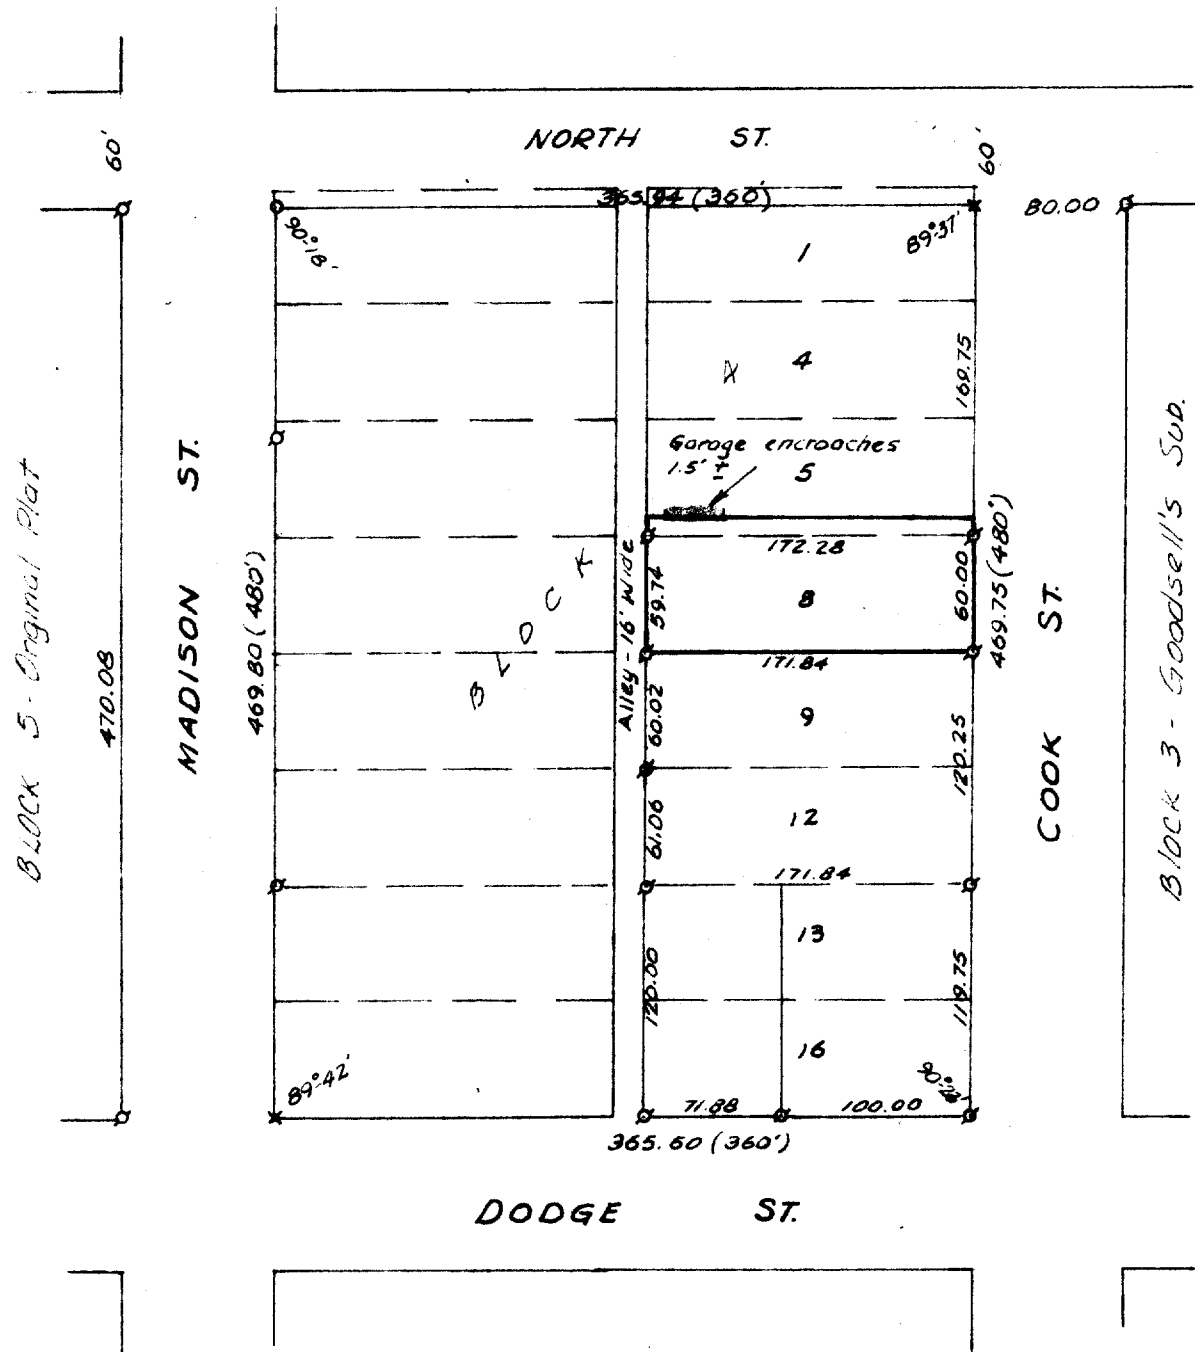

N

SCALE - 1" = 100'

Ø - IRON PIPE FOUND

X - SPIKE

Drawing showing existing dimensions and internal angles of Block 4, Goodsell's Subd., City of Lake Geneva, Walworth County, Wisconsin and parcel to be surveyed; to wit: Lot 8 and the South 10.00 feet of Lot 5, Block 4 of said Subd.

Harold H. Kolb

Harold H. Kolb
Wis. Reg. Land Surveyor S-187
September 4, 1969