

PREPARED FOR
LINCOLN HOLDING GROUP


PLAT OF SURVEY

- OF -

PATHFINDER SURVEYING INC.
(formerly)
J.K. SURVEYING INC.
P.O. BOX 322
LAKE GENEVA, WI. 53147
WWW.PATHFINDERSURVEYING.NET
262-248-8303

LOTS 1 AND 2 BLOCK 19, EXCEPT THE SOUTH 42 FEET OF SAID LOTS
1 AND 2, GENEVA LAKE CRAWFORD MFG. Co. ADDITION TO THE
CITY OF LAKE GENEVA, WALWORTH COUNTY, WISCONSIN.

HASKINS STREET


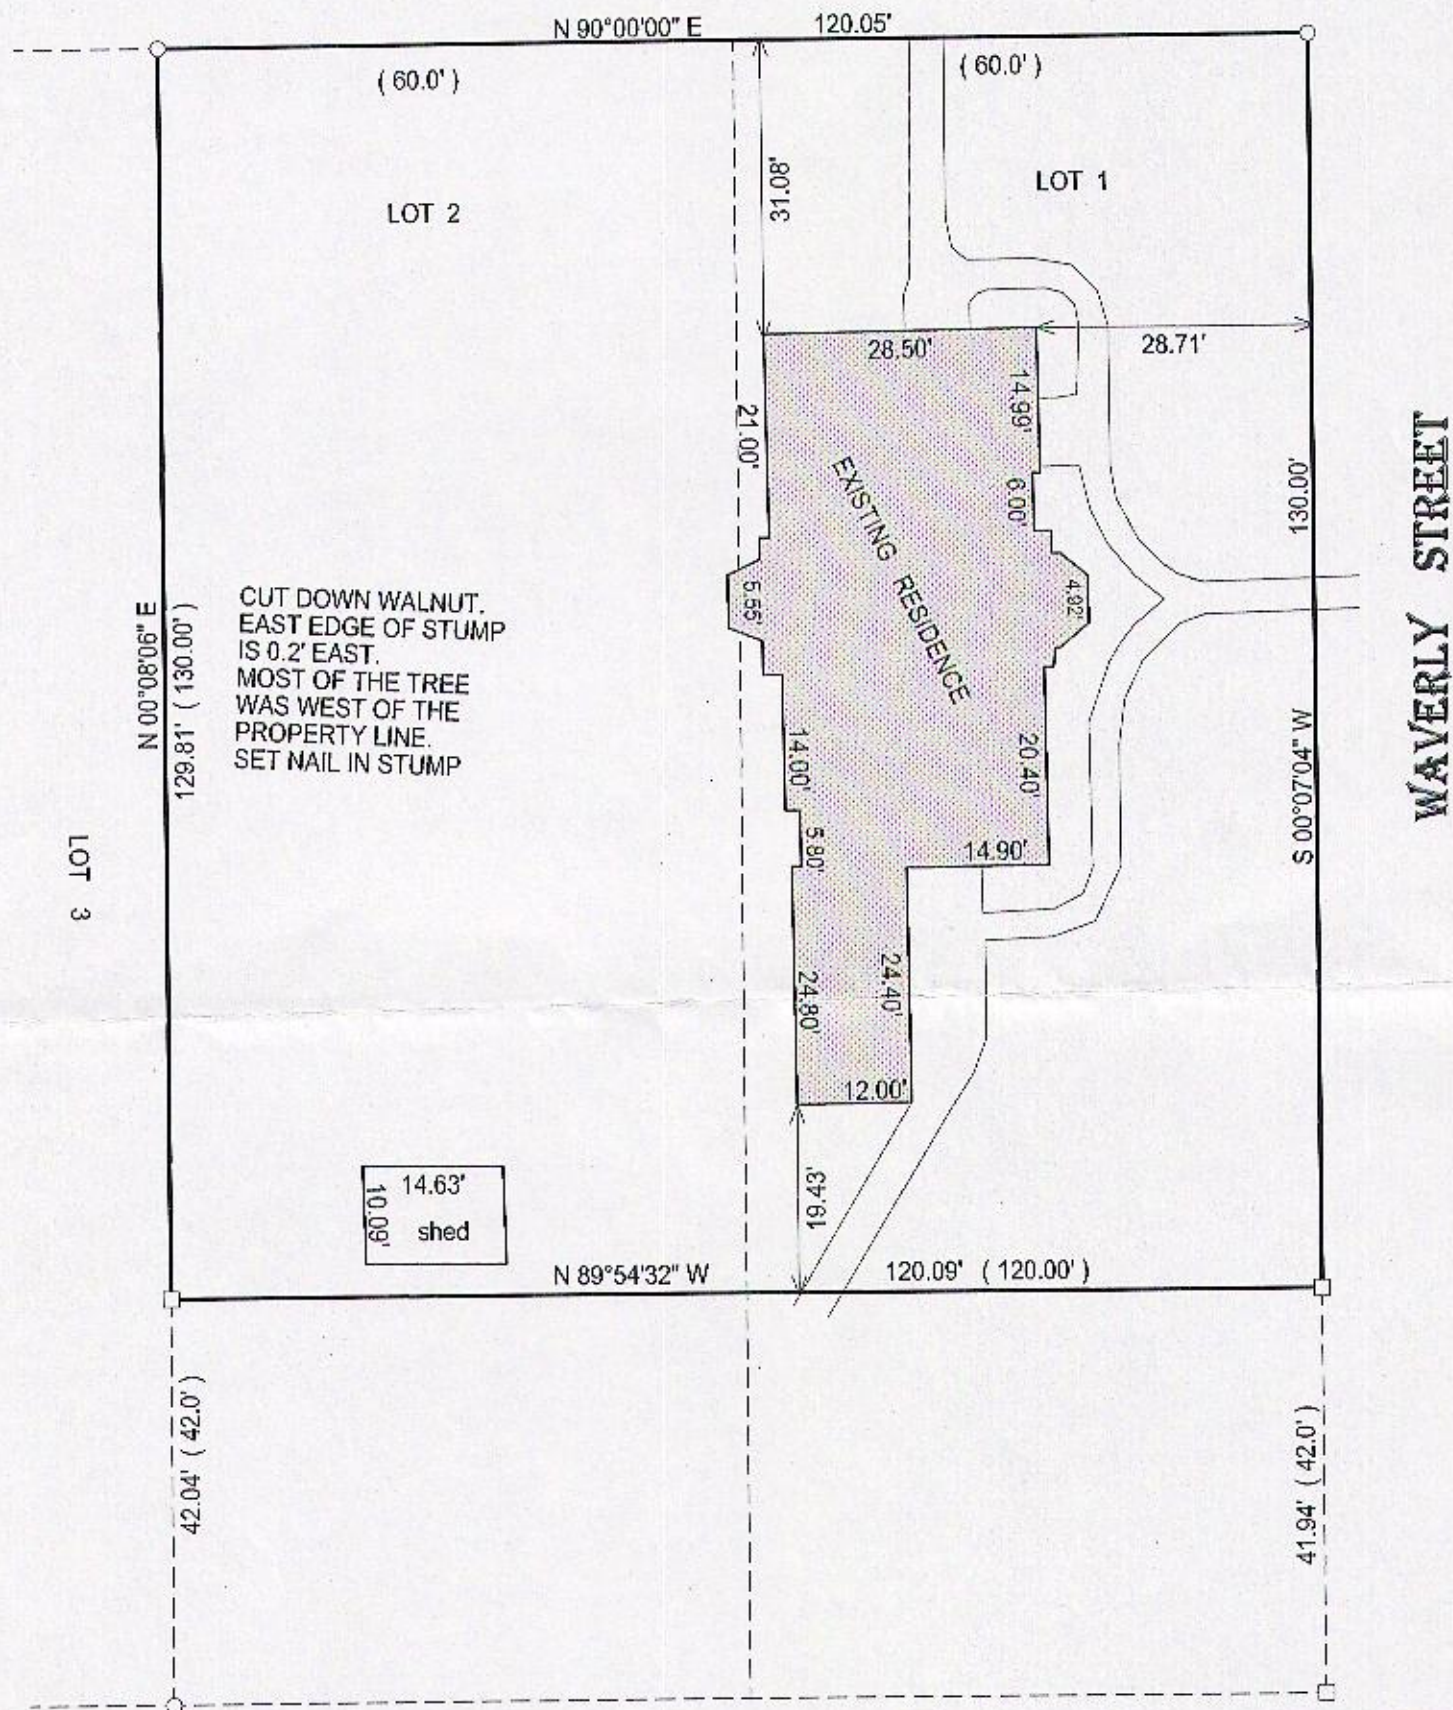


- () = recorded as
- = found iron bar
- = found iron pipe
- = set iron pipe
- = set iron bar

SCALE 1" = 20'

JOB # 15-136

TAX ID # ZGC00102

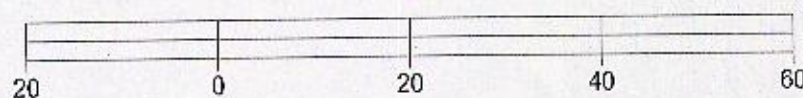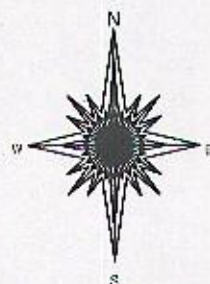


BASIS OF BEARING OF THIS PLAT: THE SOUTH LINE OF HASKINS
WAS ASSUMED TO BEAR EAST AS MONUMENTED.

I hereby certify that I have surveyed the above-described property and the
above map is a true representation thereof and shows the size and
location of the property, its exterior boundaries, the location and
dimensions of all structures thereon, fences, appurtenant easements and
roadways and visible encroachments if any.

This survey is made for the present owners of the property, and those who
purchase, mortgage, or guarantee the title thereto, within one year from
the date hereof.

DATED THIS 15TH DAY OF MAY, 2015.

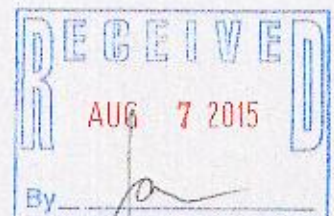

JEFFREY L. KIMPS S-2436
Wisconsin Registered Land Surveyor
(original if signed in red)

007-3175