

LAND-MARK SURVEYING

Mark L. Miritz

Wisconsin Professional Land Surveyor S-2582

N9330 Knuteson Drive
Whitewater, WI 53190
Phone: (262) 495-3284
MARKMIRITZ@
LAND-MARKSURVEYING.COM

PLAT OF SURVEY

LOT 39, TOWNLINE TRAILS SUBDIVISION, LOCATED IN
PART OF THE NORTHEAST 1/4 OF THE NORTHWEST 1/4
AND THE SOUTHEAST 1/4 OF THE NORTHWEST 1/4 OF
SECTION 6, ALL IN TOWN 1 NORTH, RANGE 18 EAST,
CITY OF LAKE GENEVA, WALWORTH COUNTY, WISCONSIN

ORDERED BY: BASSO BUILDERS, INC.
405 SKYLINE ROAD
LAKE GENEVA, WI 53147

CUMBERLAND TRAIL

60' WIDE

S 00°08'05" E 75.02'
(S 00°08'05" E 75.00')

27.3'

12.6'

24'

14'

26'

EXISTING
FOUNDATION

50'

12.3'

N 89°48'51" E 176.90'
(N 89°51'55" E 176.98')


12' WIDE UTILITY EASEMENT

LOT 39

13396 SF

N 89°48'55" E 180.22'
(N 89°51'55" E 180.32')

(S 02°41'05" E 75.07')
S 02°39'54" E 75.10'

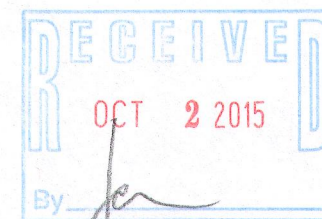

LEGEND



FOUND IRON PIPE



SET IRON ROD, 18" LONG, WEIGHING
1.5 LBS./LINEAL FT., 3/4" DIA.

(x x)

RECORDED AS DIMENSION


SCALE: 1 INCH = 20 FEET

"I hereby certify that the above described property has been surveyed by me or under my direction and that the above map is a true representation thereof and shows the size and location of the property, its exterior boundaries, the location of all visible structures and dimensions of all principal buildings thereon, boundary fences, apparent easements, roadways and visible encroachments, if any."
"This survey is made for the use of the present owners of the property, and also those who purchase, mortgage, or guarantee the title thereto within one year from date hereof."

MARK L. MIRITZ
WISCONSIN PROFESSIONAL
LAND SURVEYOR S-2582

REVISED JULY 22, 2015
TO SHOW FOUNDATION
AS BUILT

DATE: MAY 5, 2015 JOB NO. 15.416

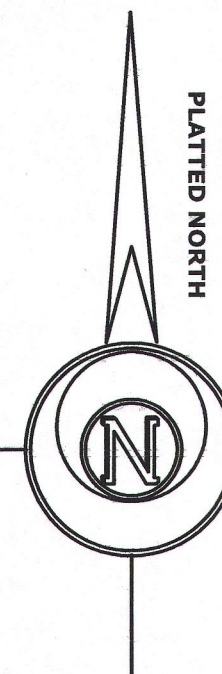

2TT-39

007-3178