


11 Marsh Add for
City of Lake Geneva

1. Chain 3, from stone at N.W. cor.
No. 86, 166 ft for A. cor. 200 ft. Offset 3
42 ft forward line and set stake.
2. Find set stake and remainder of set
line 3 at S. cor. 200 ft. 127 ft from R
with a 1x2" and 1/2" iron pin in N. on N.W.
line. Distance 167.56 ft from set
stake. 167.56 ft from set stake of 2 1/2" x
1/2" iron pin for A. cor. 200 ft.
167.56 ft from set stake for A.
cor. 200 ft. 167.56 ft from set
line 168 ft from set stake of 1/2" x 1/2"
and 1x2 pin in line 400 ft. 43.
3. Line 42 ft from stake 3 for 2
and set stake forward line. Protracted
out line N. on line 400 ft. 43
and set stake.

Aug. 4th 08. C. Hudson Asst.

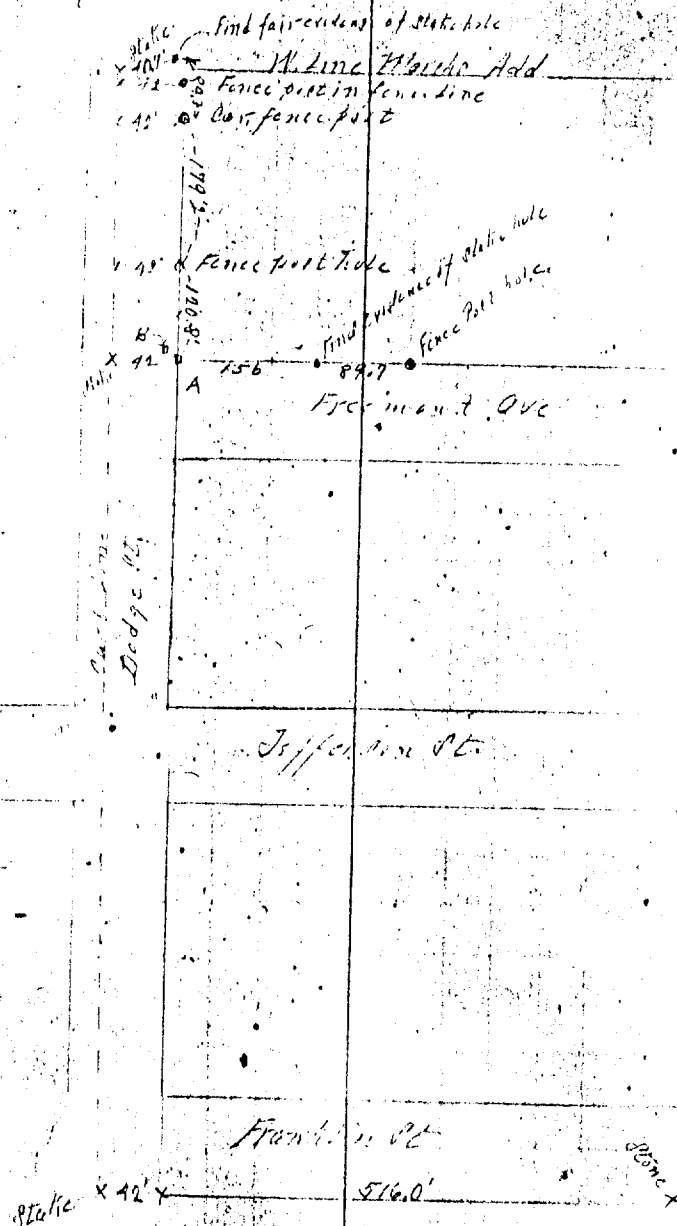

Lot 37 David C. Marsh

MA-28

7-317-8

11

7

—)

0

Fin.

14.

2. *For*

10

12

•

15

2

ρ_{T_0}

1

N

9

