


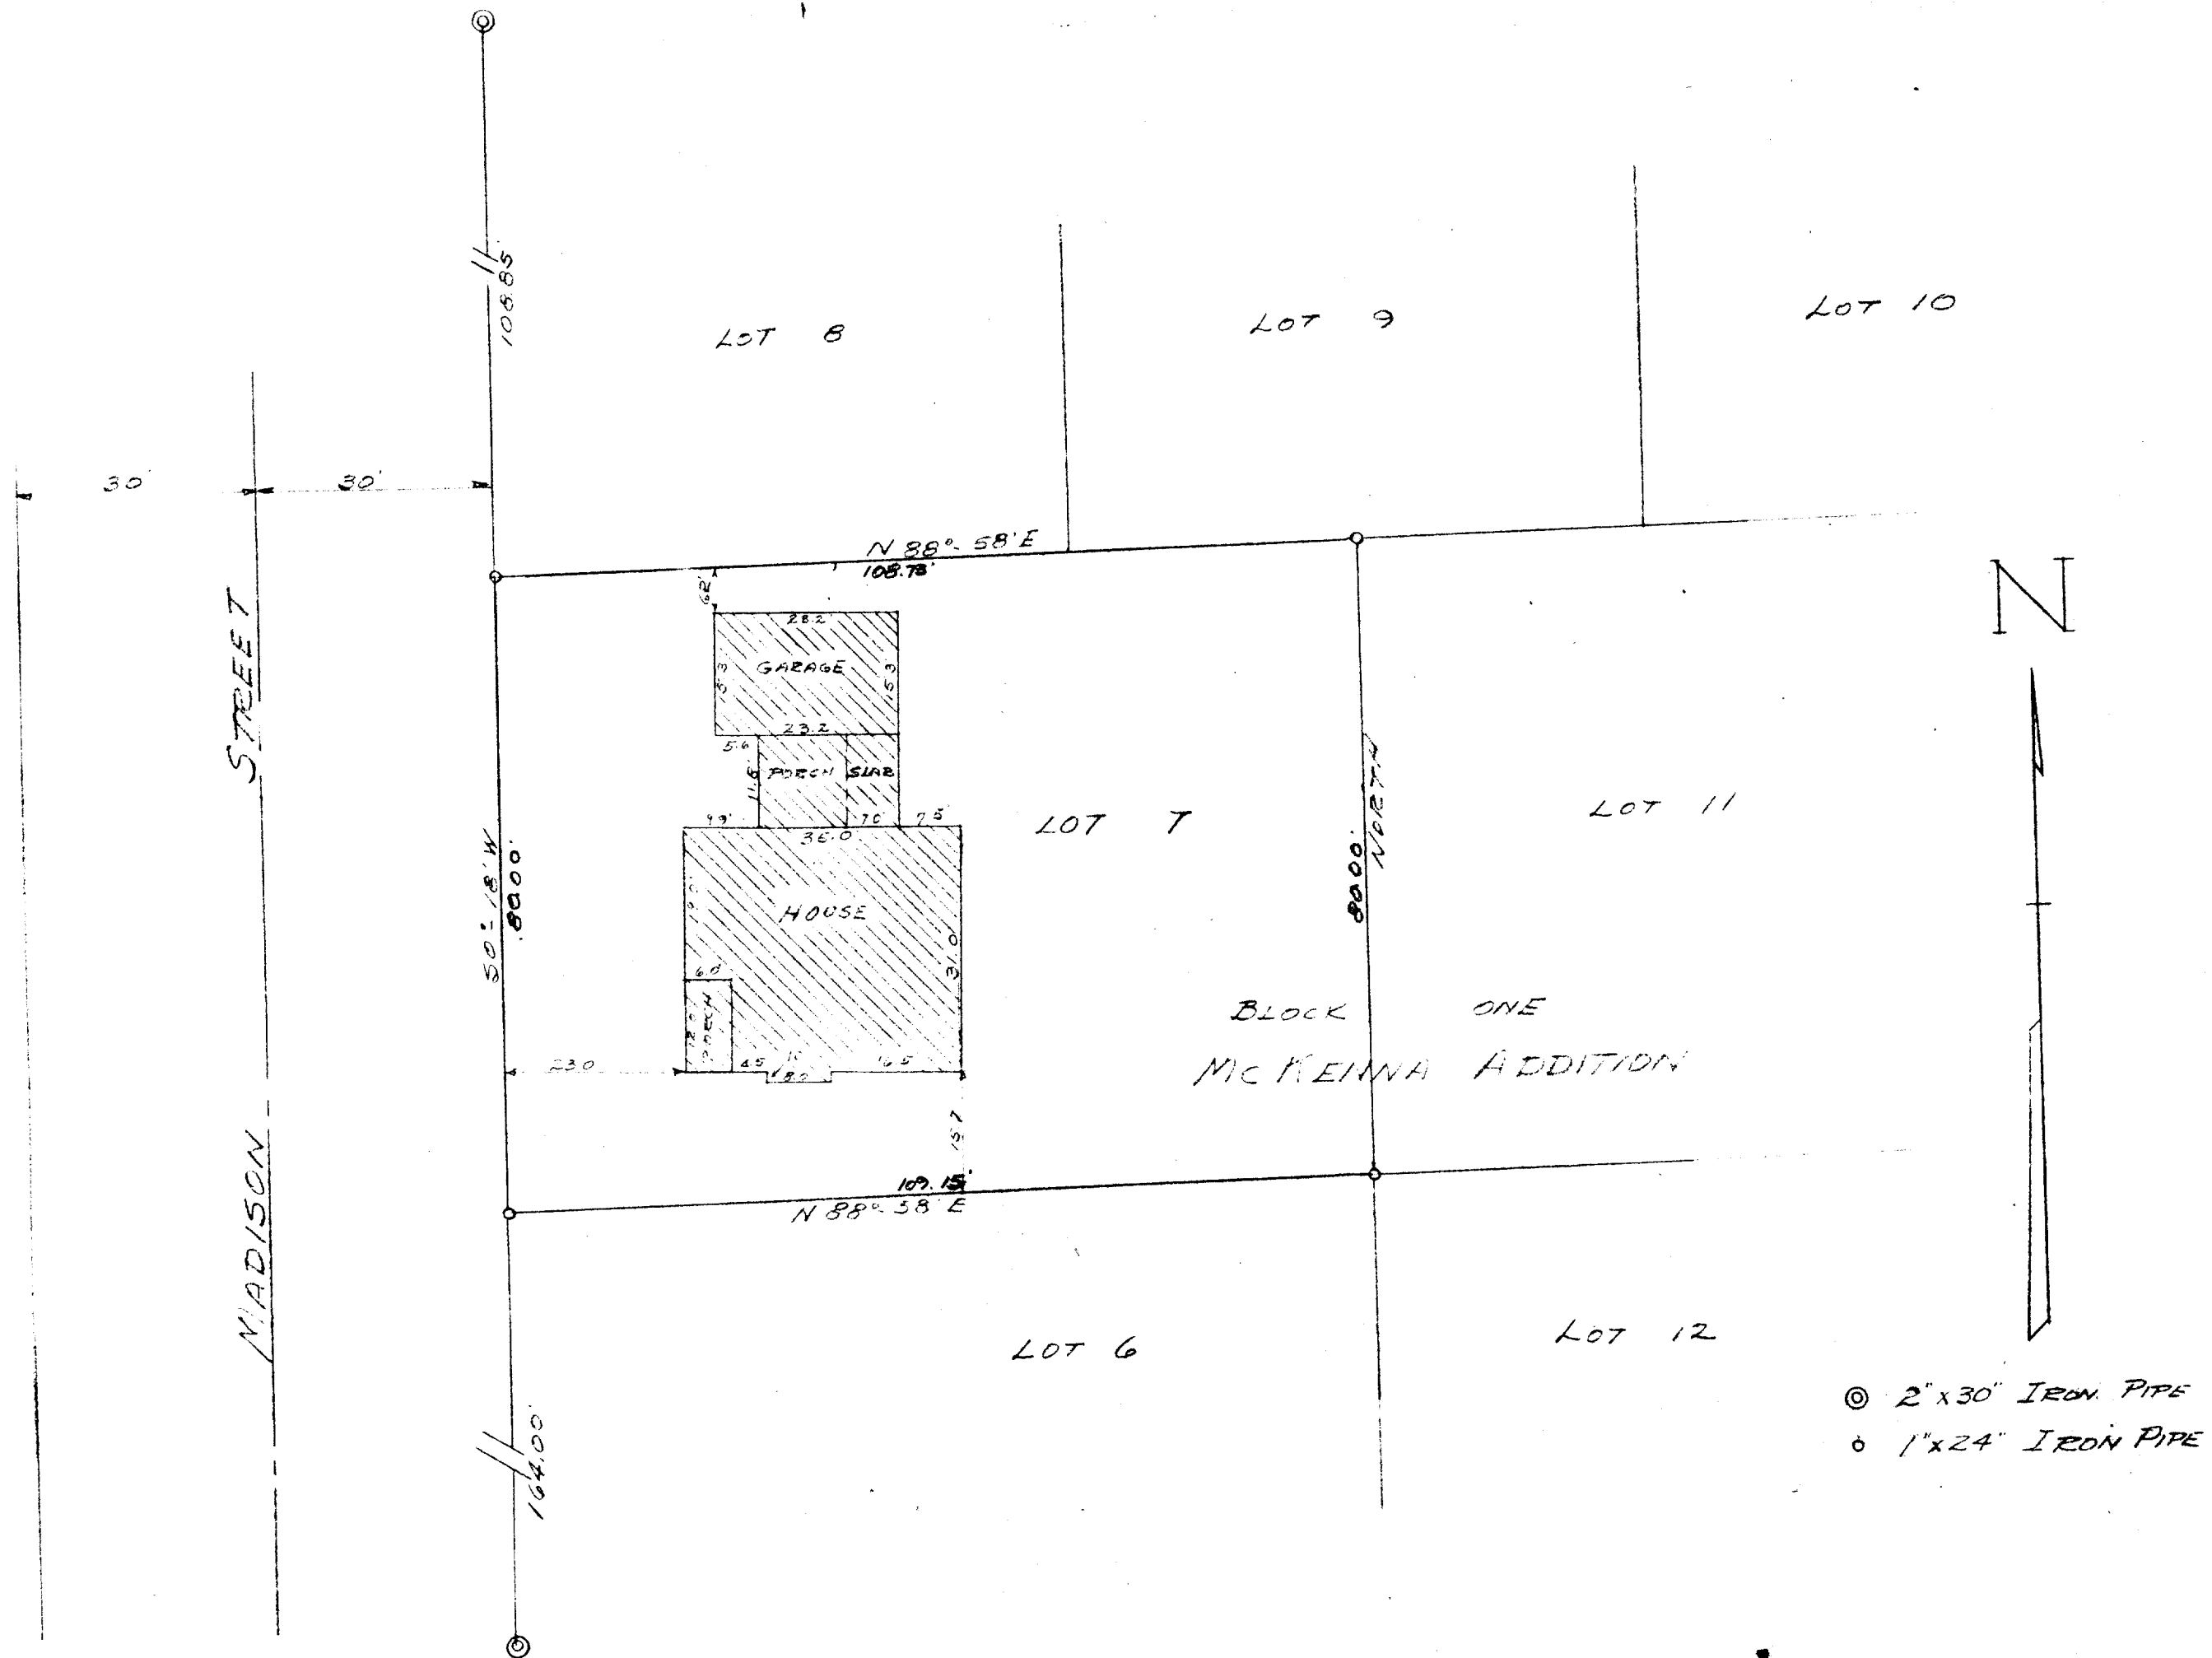

STATE OF WISCONSIN)
COUNTY OF WALWORTH)

I, LLOYD L. JENSEN, DO HEREBY CERTIFY THAT I HAVE SURVEYED THE PROPERTY DESCRIBED HEREON ACCORDING TO THE OFFICIAL RECORDS, AND THAT THE PLAT ABOVE IS A CORRECT REPRESENTATION OF THE LOT LINES AND PRINCIPAL LINES OF BUILDINGS THEREON.

ELKHORN WISCONSIN Oct. 7 1954.

Lloyd L. Jensen
COUNTY SURVEYOR

PLAT OF SURVEY OF

LOT 7, BLOCK ONE OF
"MCKENNA ADDITION" SECTION 25
T2 N R1E OF WALWORTH COUNTY
WISCONSIN

Lloyd L. Jensen
COUNTY SURVEYOR

SCALE 1" = 20'

DATE OCT. 7, 1954

7-31J

M 7-1