

WORK ORDERED BY -
 RON DEROSA
 1550 HECT ROAD
 BARTLETT, IL. 60103

FARRIS, HANSEN & ASSOCIATES, INC.

ENGINEERING - ARCHITECTURE - SURVEYING
 7 RIDGWAY COURT - P.O. BOX 437 - ELKHORN, WISCONSIN 53121
 PHONE: (262) 723-2098 FAX: (262) 723-5886
PLAT OF SURVEY


LOTS 2 AND 3, BLOCK 14 OF LAKE GENEVA MANOR
 LOCATED IN PART OF THE EAST 1/2 OF SECTION 35,
 TOWN 2 NORTH, RANGE 17 EAST, CITY OF LAKE GENEVA,
 WALWORTH COUNTY, WISCONSIN




1622 EVERGREEN LANE

PARCEL 1:
 Lot Two (2), in Block Fourteen (14) of the Lake Geneva Manor, City of Lake Geneva,
 County of Walworth, State of Wisconsin.
 Tax Key No. ZLM00014

PARCEL 2:
 Lot Three (3), in Block Fourteen (14) of the Lake Geneva Manor, City of Lake Geneva,
 County of Walworth, State of Wisconsin.
 Tax Key No. ZLM00015

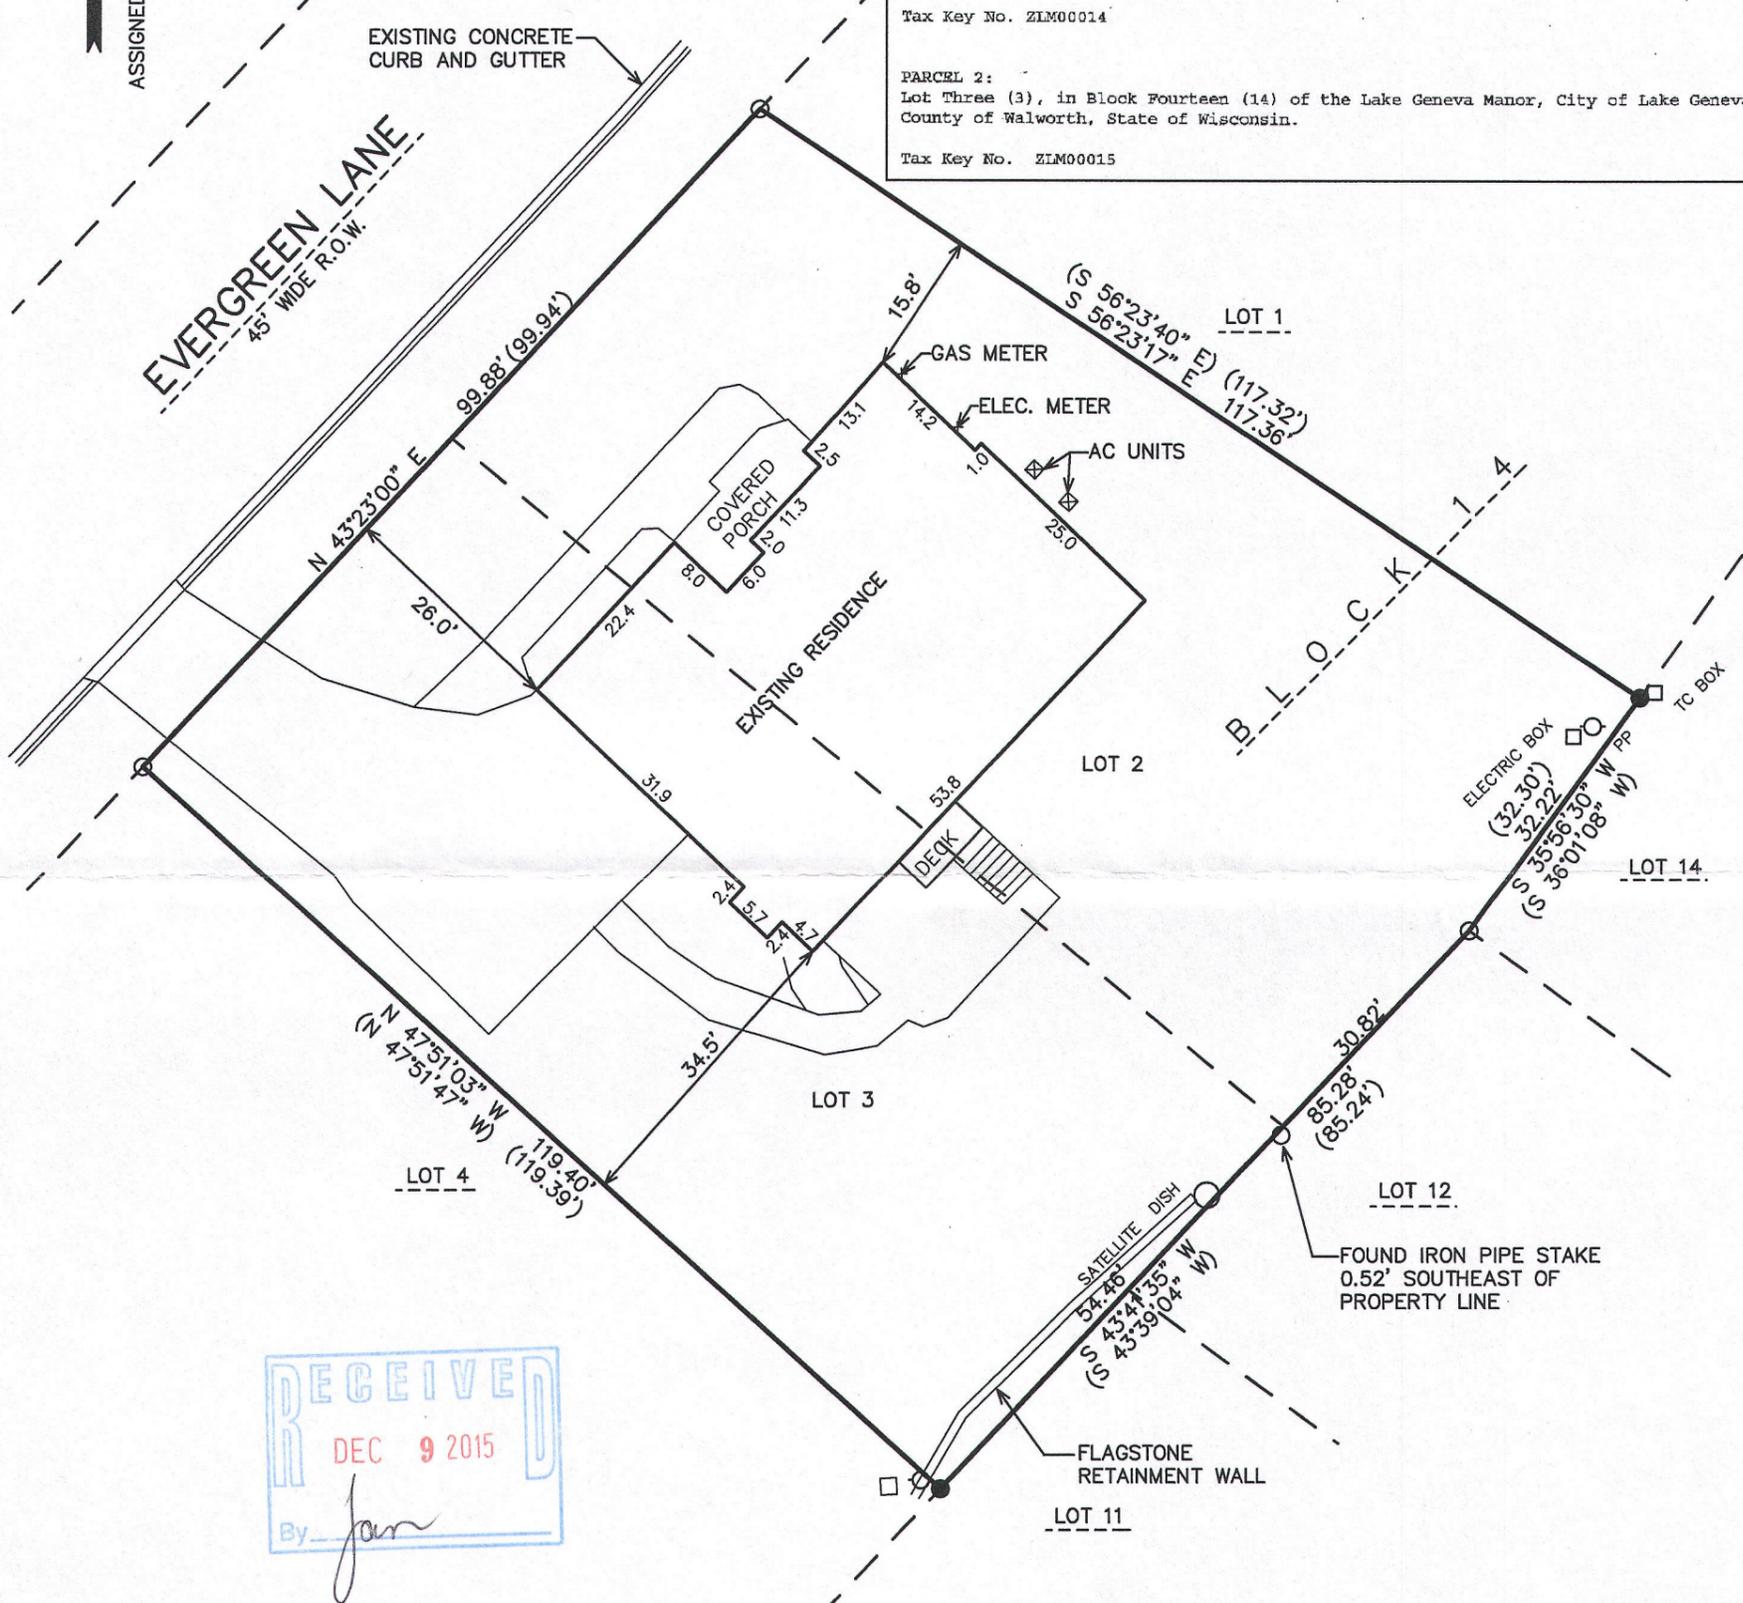

RECEIVED
 DEC 9 2015
 By *Jan*

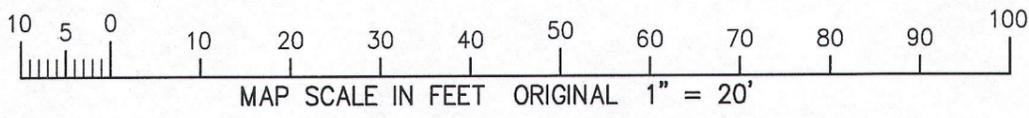

TOTAL AREA
 12,963 S.F.
 0.30 AC.


NOTE: COPIES OF THIS MAP TO WHICH THE FOLLOWING CERTIFICATE WILL APPLY SHOW THE SURVEYOR'S ORIGINAL SEAL AND SIGNATURE IN RED INK. COPIES BY ANY OTHER MEANS MAY HAVE ALTERATIONS WHICH DO NOT REPRESENT THE SURVEYOR'S WORK PRODUCT.

I HEREBY CERTIFY THAT THE ABOVE DESCRIBED PROPERTY HAS BEEN SURVEYED UNDER MY DIRECTION AND THAT THE ABOVE MAP IS A TRUE REPRESENTATION THEREOF AND SHOWS THE SIZE AND LOCATION OF THE PROPERTY, ITS EXTERIOR BOUNDARIES, THE LOCATION OF ALL VISIBLE STRUCTURES, AND DIMENSIONS OF ALL PRINCIPLE BUILDINGS THEREON, BOUNDARY FENCES, APPARENT EASEMENTS, ROADWAYS, AND VISIBLE ENCROACHMENTS, IF ANY. THIS SURVEY IS MADE FOR THE USE OF THE PRESENT OWNERS OF THE PROPERTY, AND ALSO THOSE WHO PURCHASE, MORTGAGE, OR GUARANTEE THE TITLE THERETO WITHIN ONE YEAR FROM THE DATE HEREOF.

DATED: JUNE 9, 2015

 PETER S. GORDON P.L.S. 2101

- LEGEND
- = FOUND IRON PIPE STAKE
 - = FOUND IRON REBAR STAKE
 - (XXX) = RECORDED AS

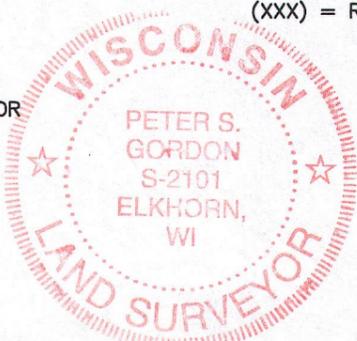

PROJECT: 7072.15
 DATE: 06-09-2015
 SHEET 1 OF 1

6/22/2015 X:\Projects\7072\Doc\SURVEY2015