



HAROLD H. KOLB

REGISTERED PROFESSIONAL LAND SURVEYOR
LAKE GENEVA, WISCONSIN

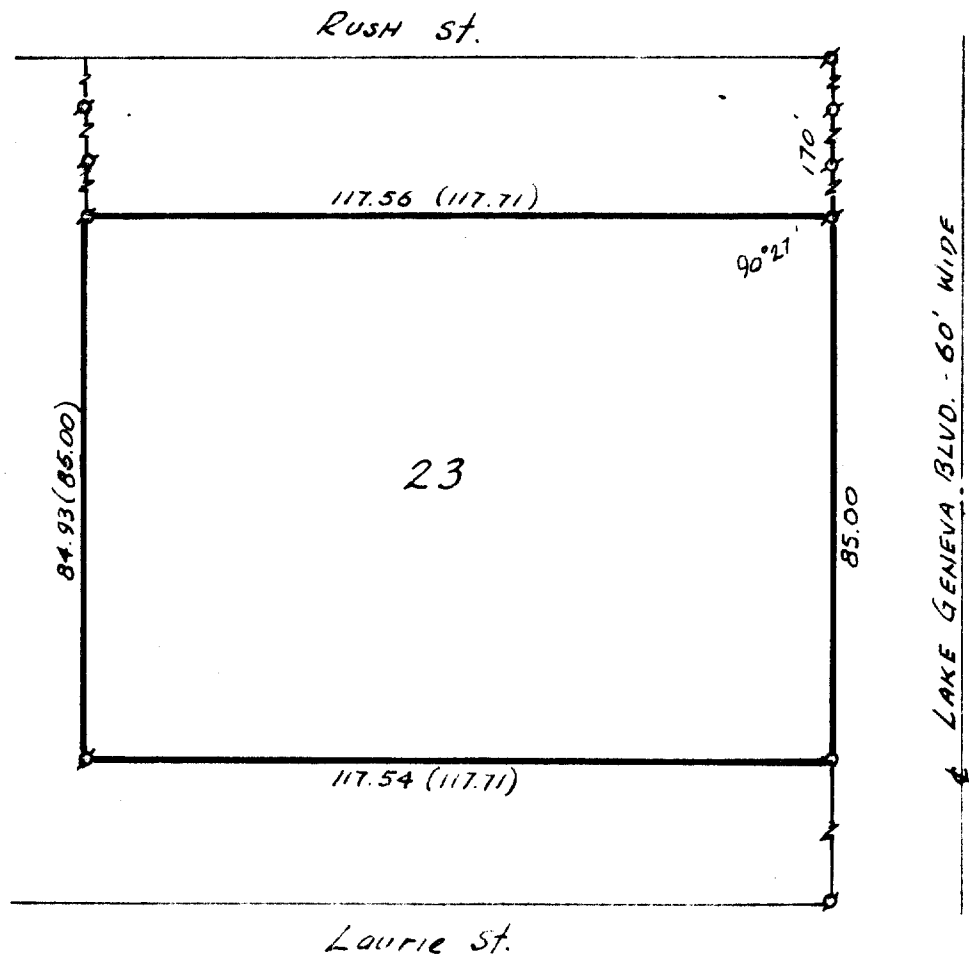

LEGEND

- ♂ - IRON PIPE FOUND
 - - IRON PIPE PLACED
 - - CONCRETE MONUMENT
 - x - SPIKE
 - () - AS PLATTED
- SCALE - 1" = 30'

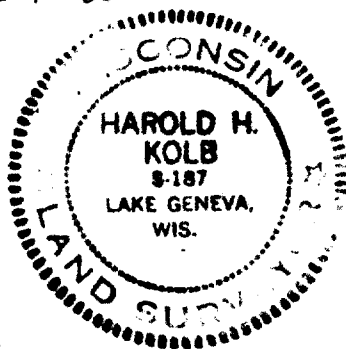

PLAT OF SURVEY OF
Lot 23, H.E. Wells Subd, City of
Lake Geneva, Walworth County,
Wisconsin

I, HAROLD H. KOLB, DO HEREBY CERTIFY THAT I HAVE
SURVEYED THE PROPERTY HEREON DESCRIBED ACCORDING
TO THE OFFICIAL RECORDS, AND THAT THE PLAT HEREON
IS A CORRECT REPRESENTATION OF THE LOT LINES.

Harold H. Kolb
HAROLD H. KOLB

WISCONSIN REGISTERED LAND SURVEYOR, S-187

DATE FEB. 10, 1970

217324

HAROLD H. KOLB

REGISTERED PROFESSIONAL LAND SURVEYOR

415 BROAD STREET

PROFESSIONAL BLDG.

PHONE 414-248-3697

LAKE GENEVA, WISCONSIN 53147

July 14, 1971

PLAT OF SURVEY OF

A parcel of land located in the Northeast $\frac{1}{4}$ of Section 35, T 2 N, R 17 E, City of Lake Geneva, Walworth County, Wisconsin described as follows: Beginning at the Southwest corner of Sleepy Hollow Subdivision in said City of Lake Geneva, thence S 89° 04' E 120.00 feet along the South line of said Subdivision; thence N 88° 47' E 307.42 feet along the South line of said Subdivision; thence S 0° 51' W 100.00 feet; thence S 89° 46' W 3.10 feet; thence S 4° 48' W 121.20 feet; thence S 86° 54' W 91.80 feet; thence N 89° 29' W 55.00 feet; thence S 0° 13' W 478.31 feet to the centerline of Main Street; thence S 78° 02' W 104.56 feet along said centerline; thence N 0° 30' E 620.45 feet; thence S 89° 01' W 172.00 feet to the East line of Elmwood Avenue; thence N 0° 30' E 103.12 feet along said East line to the place of beginning.

I, Harold H. Kolb, do hereby certify that I have surveyed the property hereon described according to the official records, and that the plat hereon is a correct representation of the lot lines.

Harold H. Kolb

Wisconsin Registered Land Surveyor, S-187