


PREPARED FOR:
LAKE GENEVA AREA REALTY
101 BROAD ST
LAKE GENEVA, WI.

PLAT OF SURVEY

- OF -

PART OF LOTS 1, 2 AND 3, BLOCK 26 IN THE ORIGINAL PLAT OF THE VILLAGE OF GENEVA, NOW
CITY OF LAKE GENEVA, WALWORTH COUNTY WISCONSIN.
(SEE ATTACHED WARRANTY DEED FOR COMPLETE LEGAL DESCRIPTION)

PATHFINDER SURVEYING INC.
(formerly)
J.K. SURVEYING INC.
P.O. BOX 322
LAKE GENEVA, WI. 53147
WWW.PATHFINDERSURVEYING.NET
262-248-8303


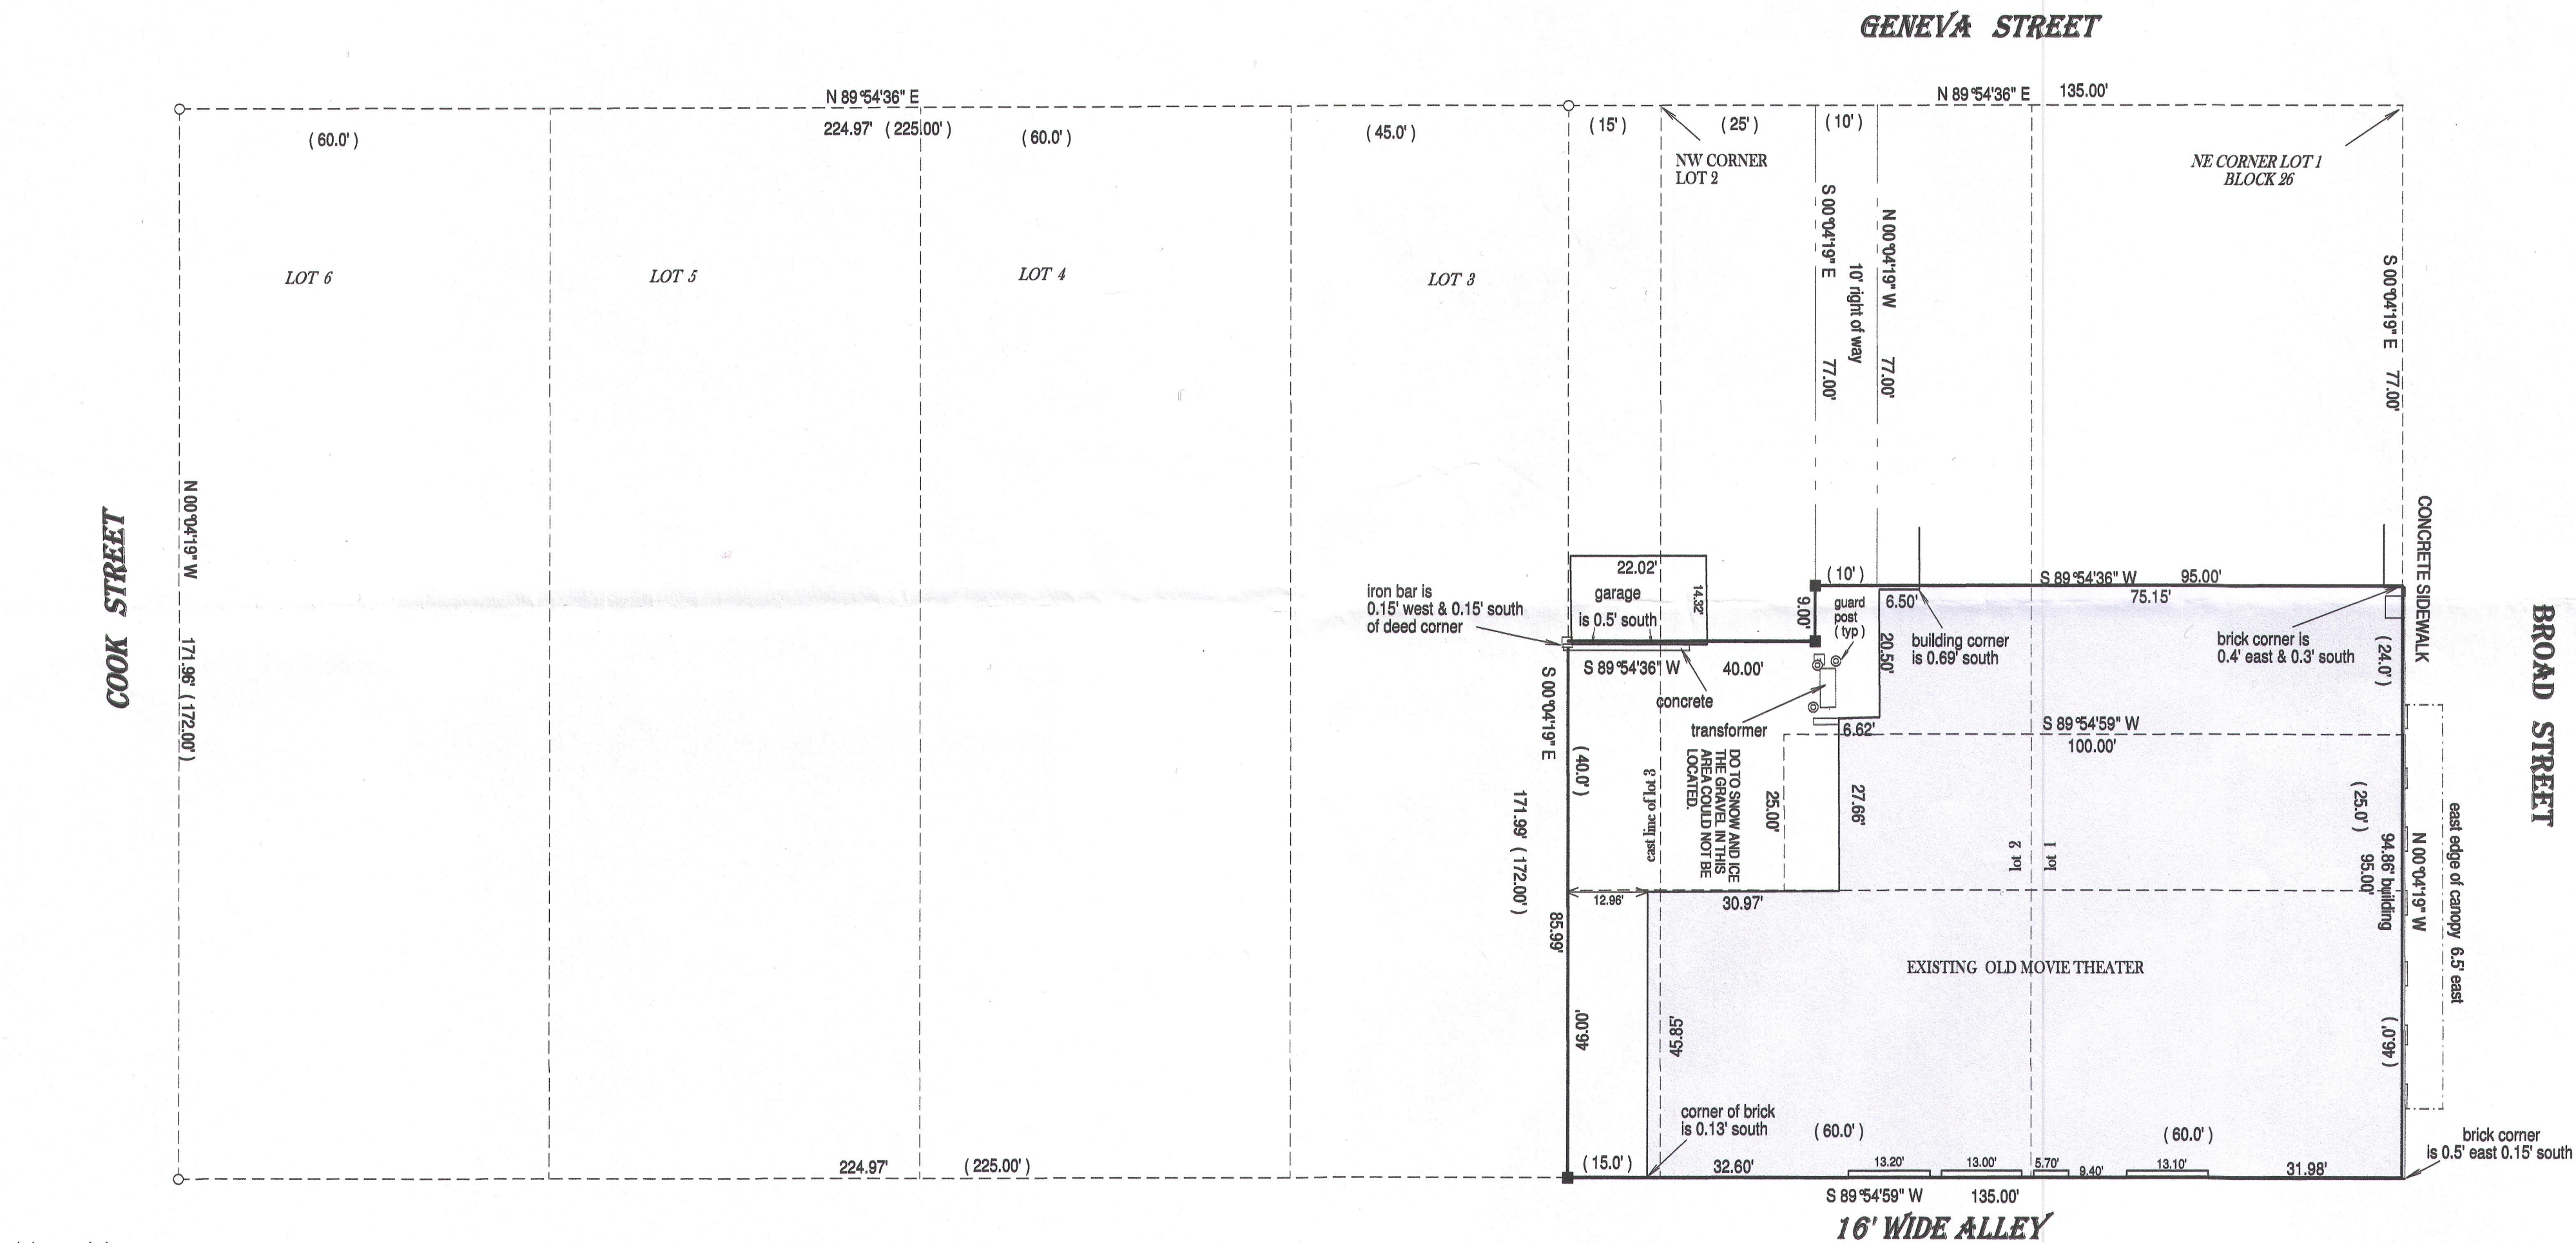


- () = recorded as
□ = found iron bar
○ = found iron pipe
● = set iron pipe
■ = set iron bar

SCALE 1" = 20'

JOB # 16-05



TAX ID # ZOP 00246 / 00247 / 00248

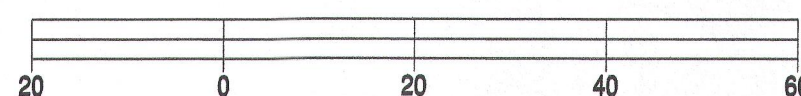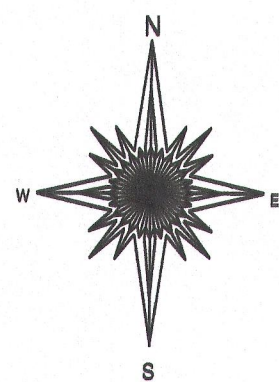

BASIS OF BEARING OF THIS PLAT: THE US STATE PLANE COORDINATE SYSTEM
SOUTH ZONE, GRID NORTH, NAD 83, WISCONSIN.

"I hereby certify that I have surveyed the above described property and that the above map is a true representation of its exterior boundaries and shows the size and location of all visible structures, apparent easements and encroachments if any."
This survey is made for the present owners of the property, and those who purchase, mortgage, or guarantee the title thereto, within one year from the date hereof.

DATED THIS 13TH DAY OF JANUARY, 2016.

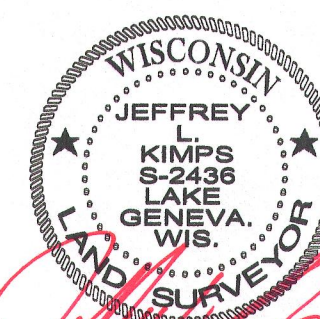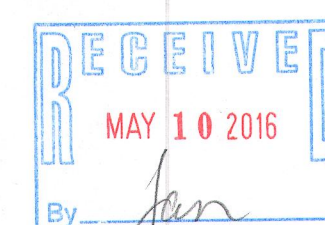

JEFFREY L. KIMPS S-2436
Wisconsin Registered Land Surveyor
(original if signed in red)

ZOP-246
ZOP-247
ZOP-248

007-3256