


Scale
1" = 40'



project BENCHMARK - paint spot
on top of curb elevation = 100.00

Building Envelope
Lines per CSM

LaSalle
Court

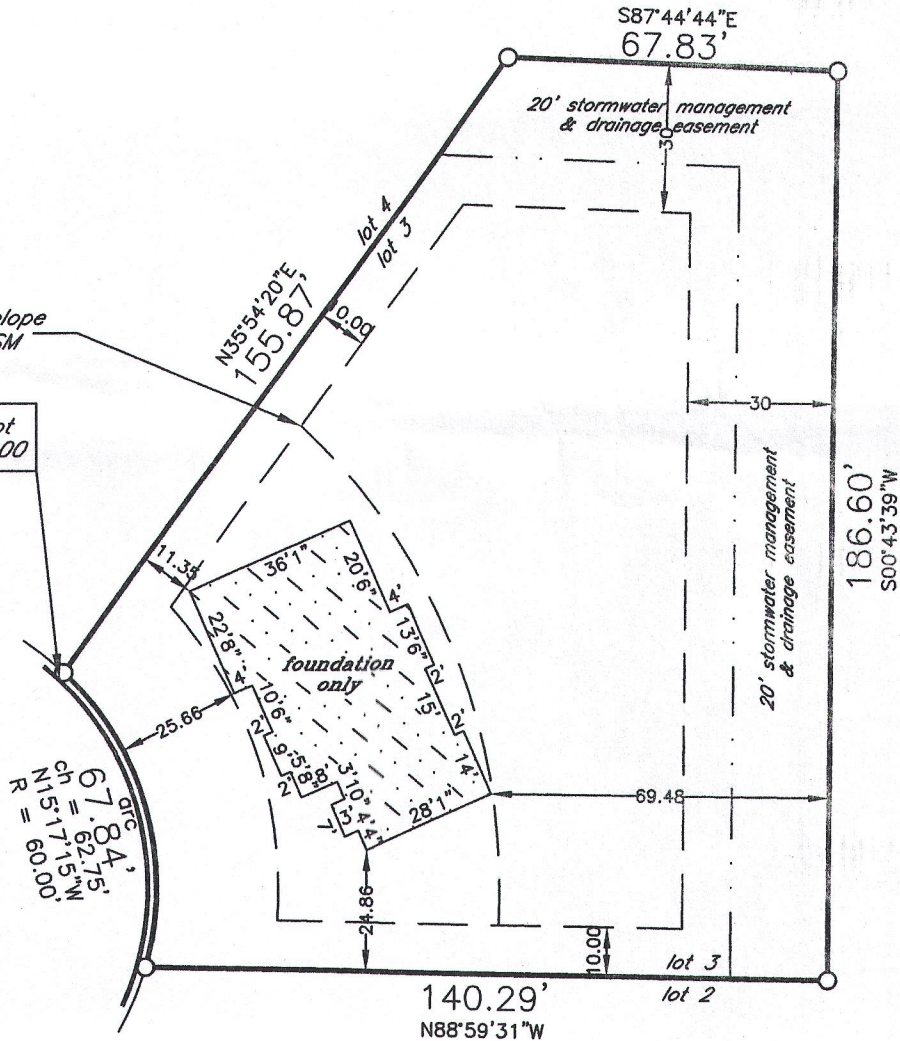

top of foundation
elevation = 100.03


* outside finish grade = EL 99.33
(advisory only) - top of founda-
tion = EL 100.00 (advisory only) un-
less otherwise determined in writ-
ing by City Engineering Department

denotes iron
pipe

* Verify exact number with
City Engineering Department

Proposed building field staked true size. Contractor to verify all dimensions be-
fore building by same and adhere to drainage plan in effect for this subdivision.
Refer to a current title report for easements or restrictions which may affect
the use of this site that are not shown on the recorded subdivision plat.

J.K.R. SURVEYING, INC.
8121 22ND AVENUE
KENOSHA, WI 53143

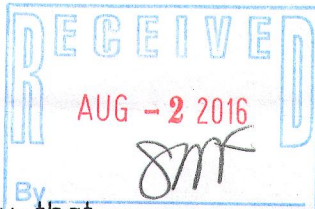

Plat of Survey of
LOT 3 OF

CERTIFIED SURVEY MAP NO. 4248

in SE1/4 Section 26-2-17

CITY OF LAKE GENEVA
WALWORTH COUNTY, WIS.

-for-

Hagen Contractors



I hereby certify that
this property was
surveyed under my
direction and this
plat is a true re-
presentation thereof.

[Signature]

Reg. Land Surveyor

May 13, 2016

Revised 6/27/16

4248-3

007-3291