


PREPARED FOR  
MARC SMALL  
1359 DEVONSHIRE RD  
BUFFALO GROVE, IL. 60089

# PLAT OF SURVEY


- OF -

PATHFINDER SURVEYING INC.  
(formerly)  
J.K. SURVEYING INC.  
P.O BOX 322  
LAKE GENEVA, WI. 53147  
WWW.PATHFINDERSURVEYING.NET  
262-248-8303

LOT 10 OF DAVID O. MARSH'S SUBDIVISION OF BLOCK 7 OF THE ORIGINAL PLAT OF THE VILLAGE ( NOW CITY OF LAKE GENEVA), BEING PART OF THE NW 1/4 OF SECTION 36, TOWN 2 NORTH, RANGE 17 EAST, CITY OF LAKE GENEVA, COUNTY OF WALWORTH AND STATE OF WISCONSIN,

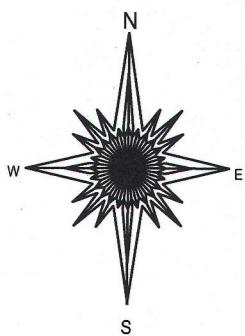

FRANKLIN STREET

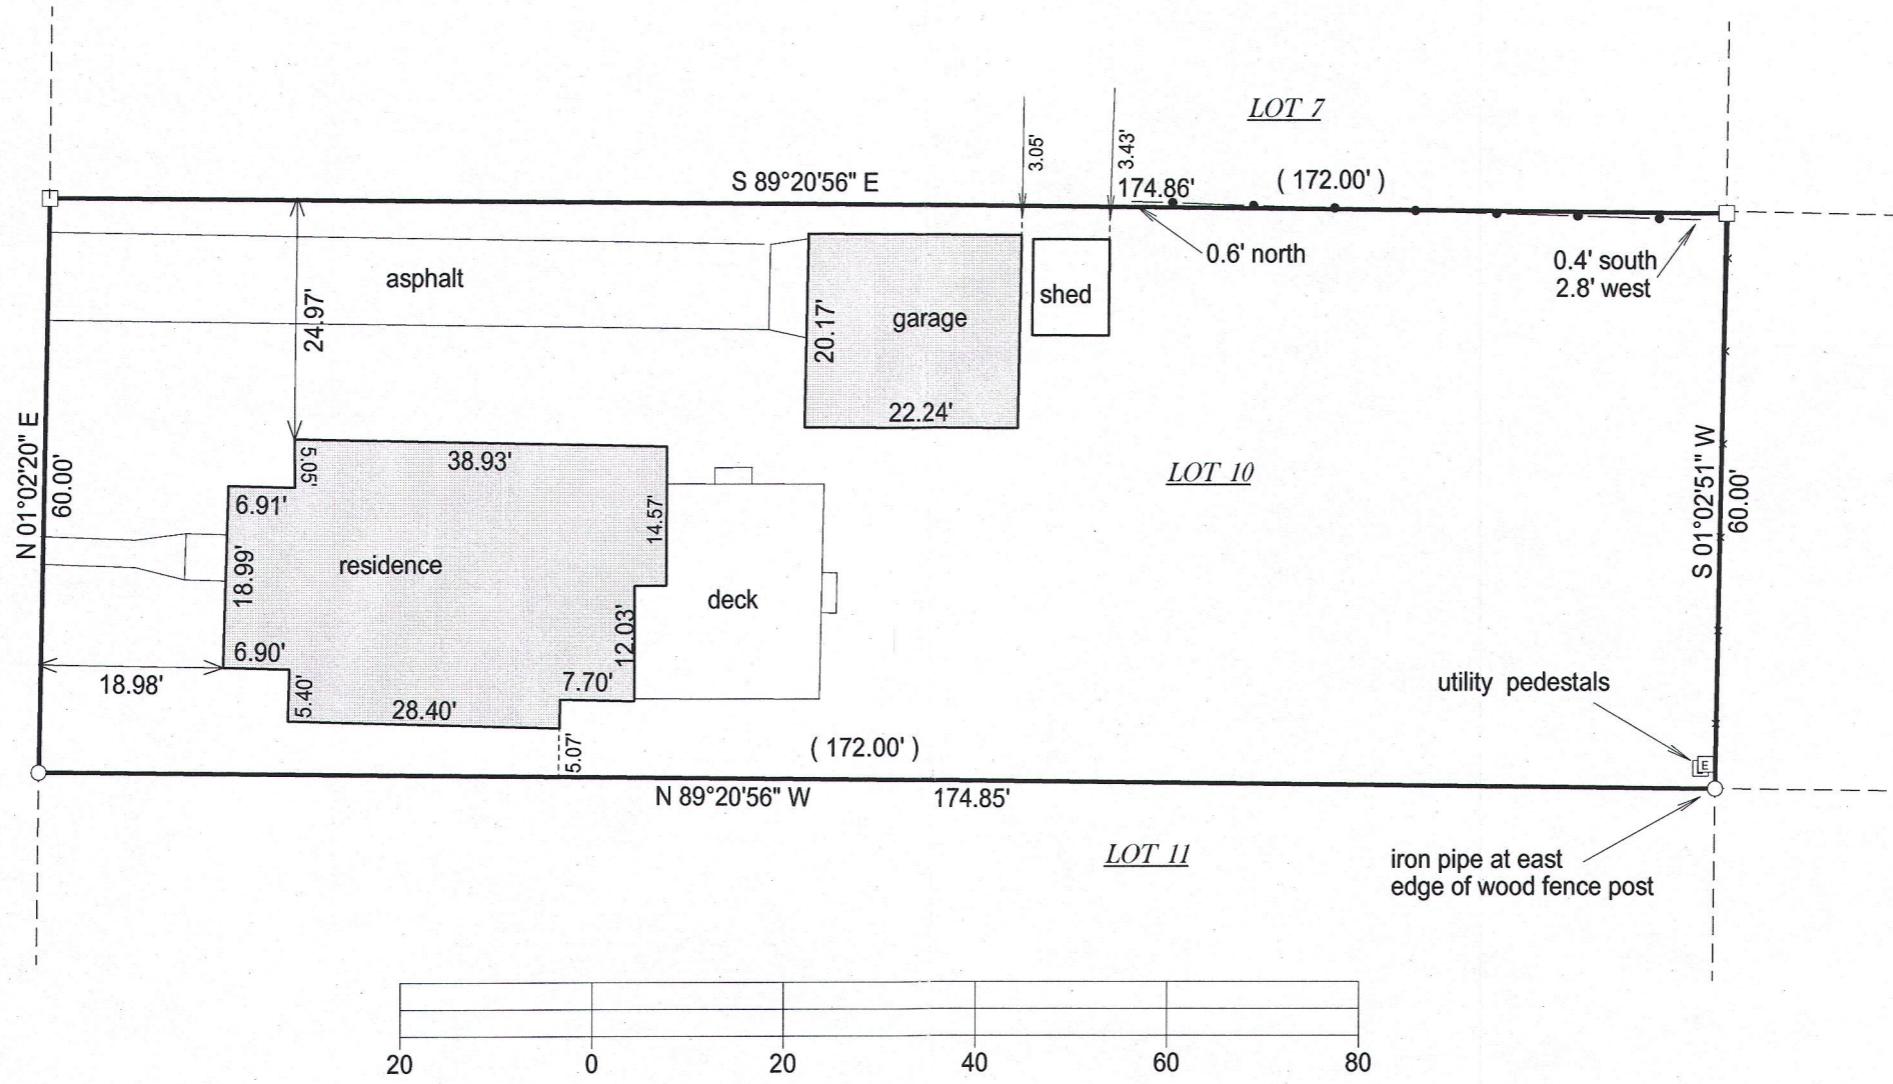

BASIS OF BEARING OF THIS PLAT: THE EAST LINE OF FRANKLIN ST. WAS ASSUMED TO BEAR N 01°02'20" E.

"I hereby certify that I have surveyed the above described property and that the above map is a true representation of its exterior boundary and shows the size and location of all visible structures, apparent easements and encroachments if any."

This survey is made for the present owners of the property, and those who purchase, mortgage, or guarantee the title thereto, within one year from the date hereof.

DATED THIS 28TH DAY OF MAY, 2016.

JEFFREY L. KIMPS S-2436  
Wisconsin Professional Land Surveyor  
( original if signed in red )

ZMB - 10

007 - 3305