


HAROLD H. KOLB

REGISTERED PROFESSIONAL LAND SURVEYOR
LAKE GENEVA, WISCONSIN

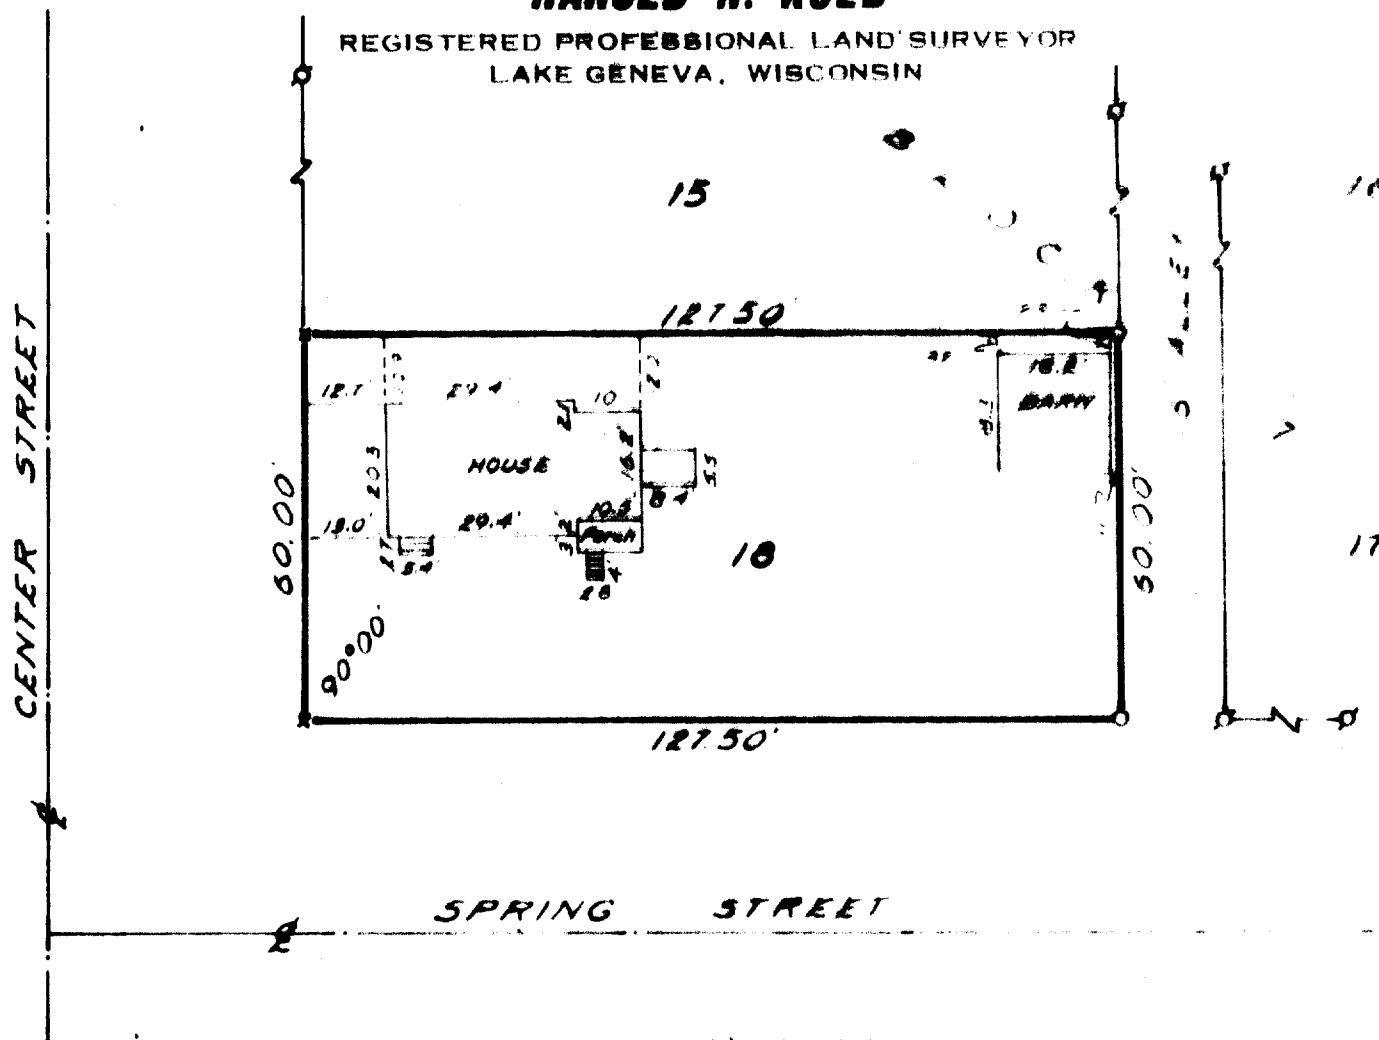

PLAT OF LOT 18

Lot 18, Block 7, Geneva Lake, Wisconsin
Manufactured by the Wisconsin State Survey
117 of Lake Geneva, Wisconsin, County,
Wisconsin

N



SCALE: 1" = 30'

LEGEND

- Ø - IRON PIPE FOUND
- - IRON PIPE PLACED
- - CONCRETE MONUMENT
- X - Cross in concrete



I, HAROLD H. KOLB, DO HEREBY CERTIFY THAT I HAVE
SURVEYED THE PROPERTY HEREOF DESCRIBED ACCORDING
TO THE OFFICIAL RECORDS, AND THAT THE PLAT HEREON
IS A CORRECT REPRESENTATION OF THE LOT LINES AND THE
PRINCIPLE LINES OF THE LOT LINES HEREOF.

Harold H. Kolb

HAROLD H. KOLB

WISCONSIN REGISTERED LAND SURVEYOR, S-187

DATE May 1, 1971

7-334