


PREPARED FOR:
TRICIA FORBECK
KEEFE REAL ESTATE
LAKE GENEVA, WI.

PLAT OF SURVEY

- OF -

PATHFINDER SURVEYING INC.
(formerly)
J.K. SURVEYING INC.
P.O BOX 322
LAKE GENEVA, WI. 53147
WWW.PATHFINDERSURVEYING.NET
262-248-8303

LOT 1 OF CERTIFIED SURVEY MAP No. 3179, RECORDED IN VOLUME 17
OF CERTIFIED SURVEYS, ON PAGE 243 AS DOCUMENT No. 433826 AND
BEING A REDIVISION OF LOT 15 AND PARTS OF LOTS 14 AND 16, BLOCK
31 OF LAKE GENEVA MANOR TRACT No. 17, ACCORDING TO THE RECORD
PLAT THEREOF. SAID LAND BEING IN THE CITY OF LAKE GENEVA, COUNTY
OF WALWORTH AND STATE OF WISCONSIN.

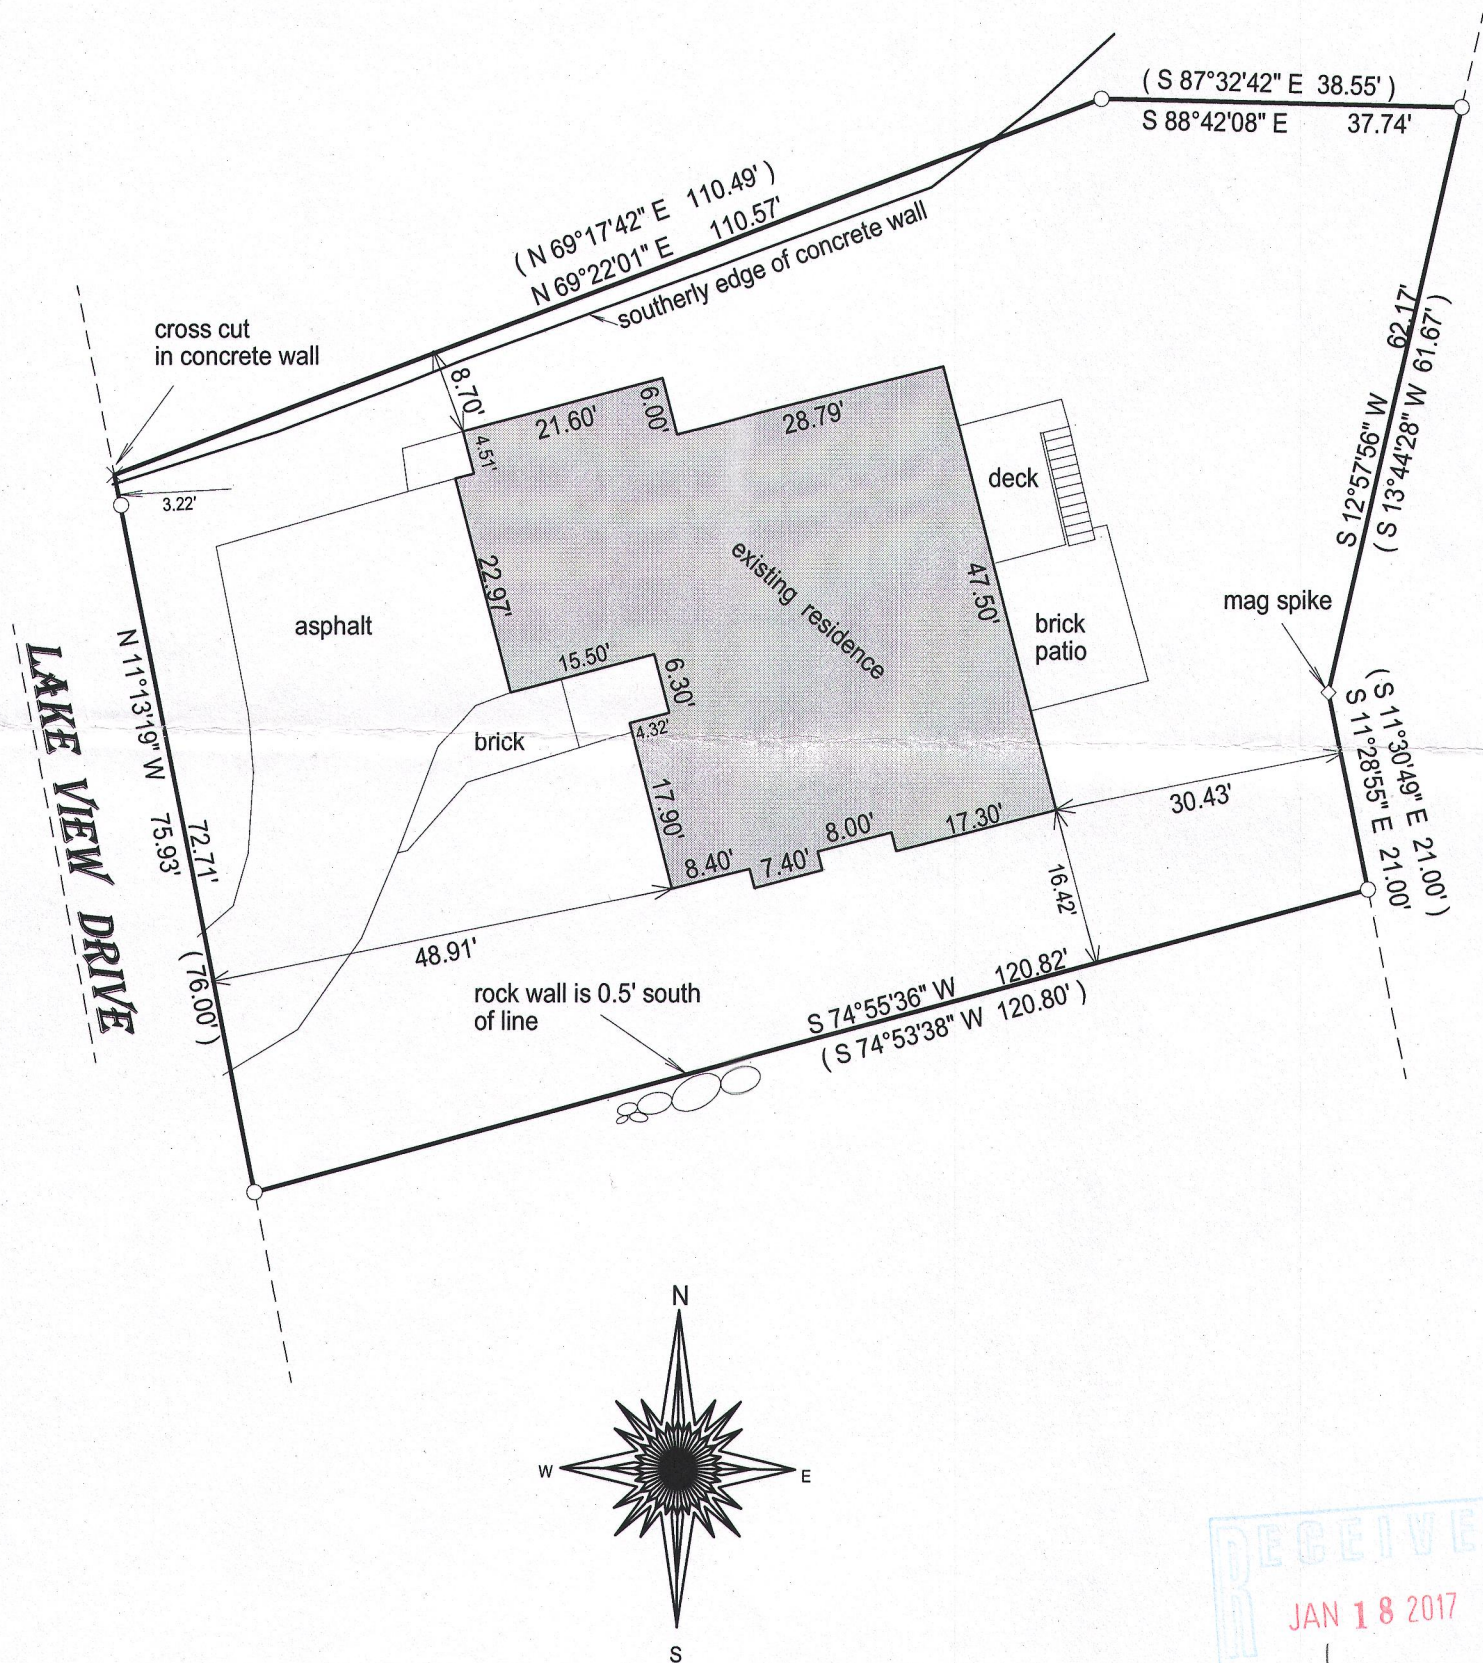


- () = recorded as
- = found iron bar
- = found iron pipe
- = set iron pipe
- = set iron bar

SCALE 1" = 20'

JOB # 16-250

TAX ID # ZA317900001


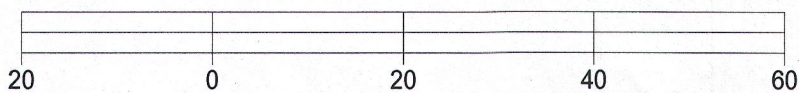


BASIS OF BEARING OF THIS PLAT: THE CERTIFIED SURVEY OF RECORD.

I hereby certify that I have surveyed the above-described property and the above map is a true representation thereof and shows the size and location of the property, its exterior boundaries, the location and dimensions of all structures thereon, fences, apparent easements and roadways and visible encroachments if any.

This survey is made for the present owners of the property, and those who purchase, mortgage, or guarantee the title thereto, within one year from the date hereof.

DATED THIS 23RD, DAY OF AUGUST, 2016.

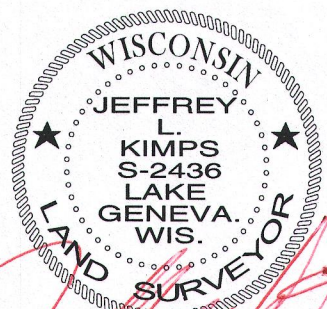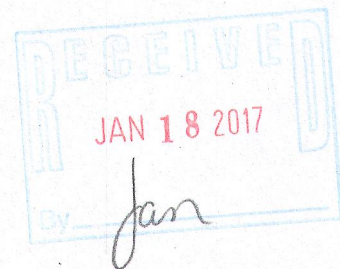

JEFFREY L. KIMPS S - 2436
Wisconsin Professional Land Surveyor
(original if signed in red)