


REGISTERED PROFESSIONAL LAND SURVEYOR
LAKE GENEVA, WISCONSIN

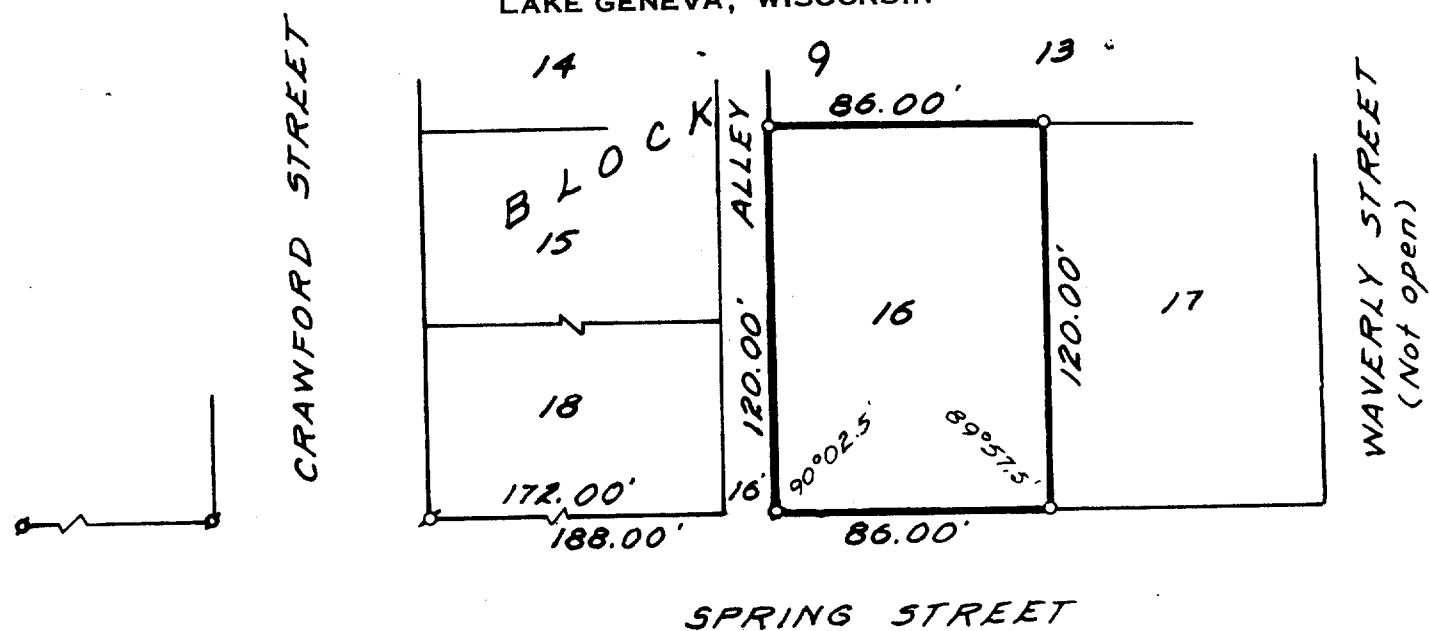

Lot 16, Block 9, Geneva Lake Crawford Manufacturing Company's Addition to the City of Lake Geneva, Walworth County, Wisconsin.

N



♂ - IRON PIPE FOUND
 ○ - IRON PIPE PLACED
 ● - CONCRETE MONUMENT
 X - SPIKE

A circular seal for a Wisconsin Land Surveyor. The outer ring contains the text "WISCONSIN" at the top and "LAND SURVEYOR" at the bottom, separated by two stars. The center of the seal contains the name "HAROLD H. KOLB", the number "8-187", and the location "LAKE GENEVA, WIS."

Harold H. Kell

HAROLD H. KOLB
WISCONSIN REGISTERED LAND SURVEYOR, S-187
DATE June 2, 1970

7-33 8

LA 248